
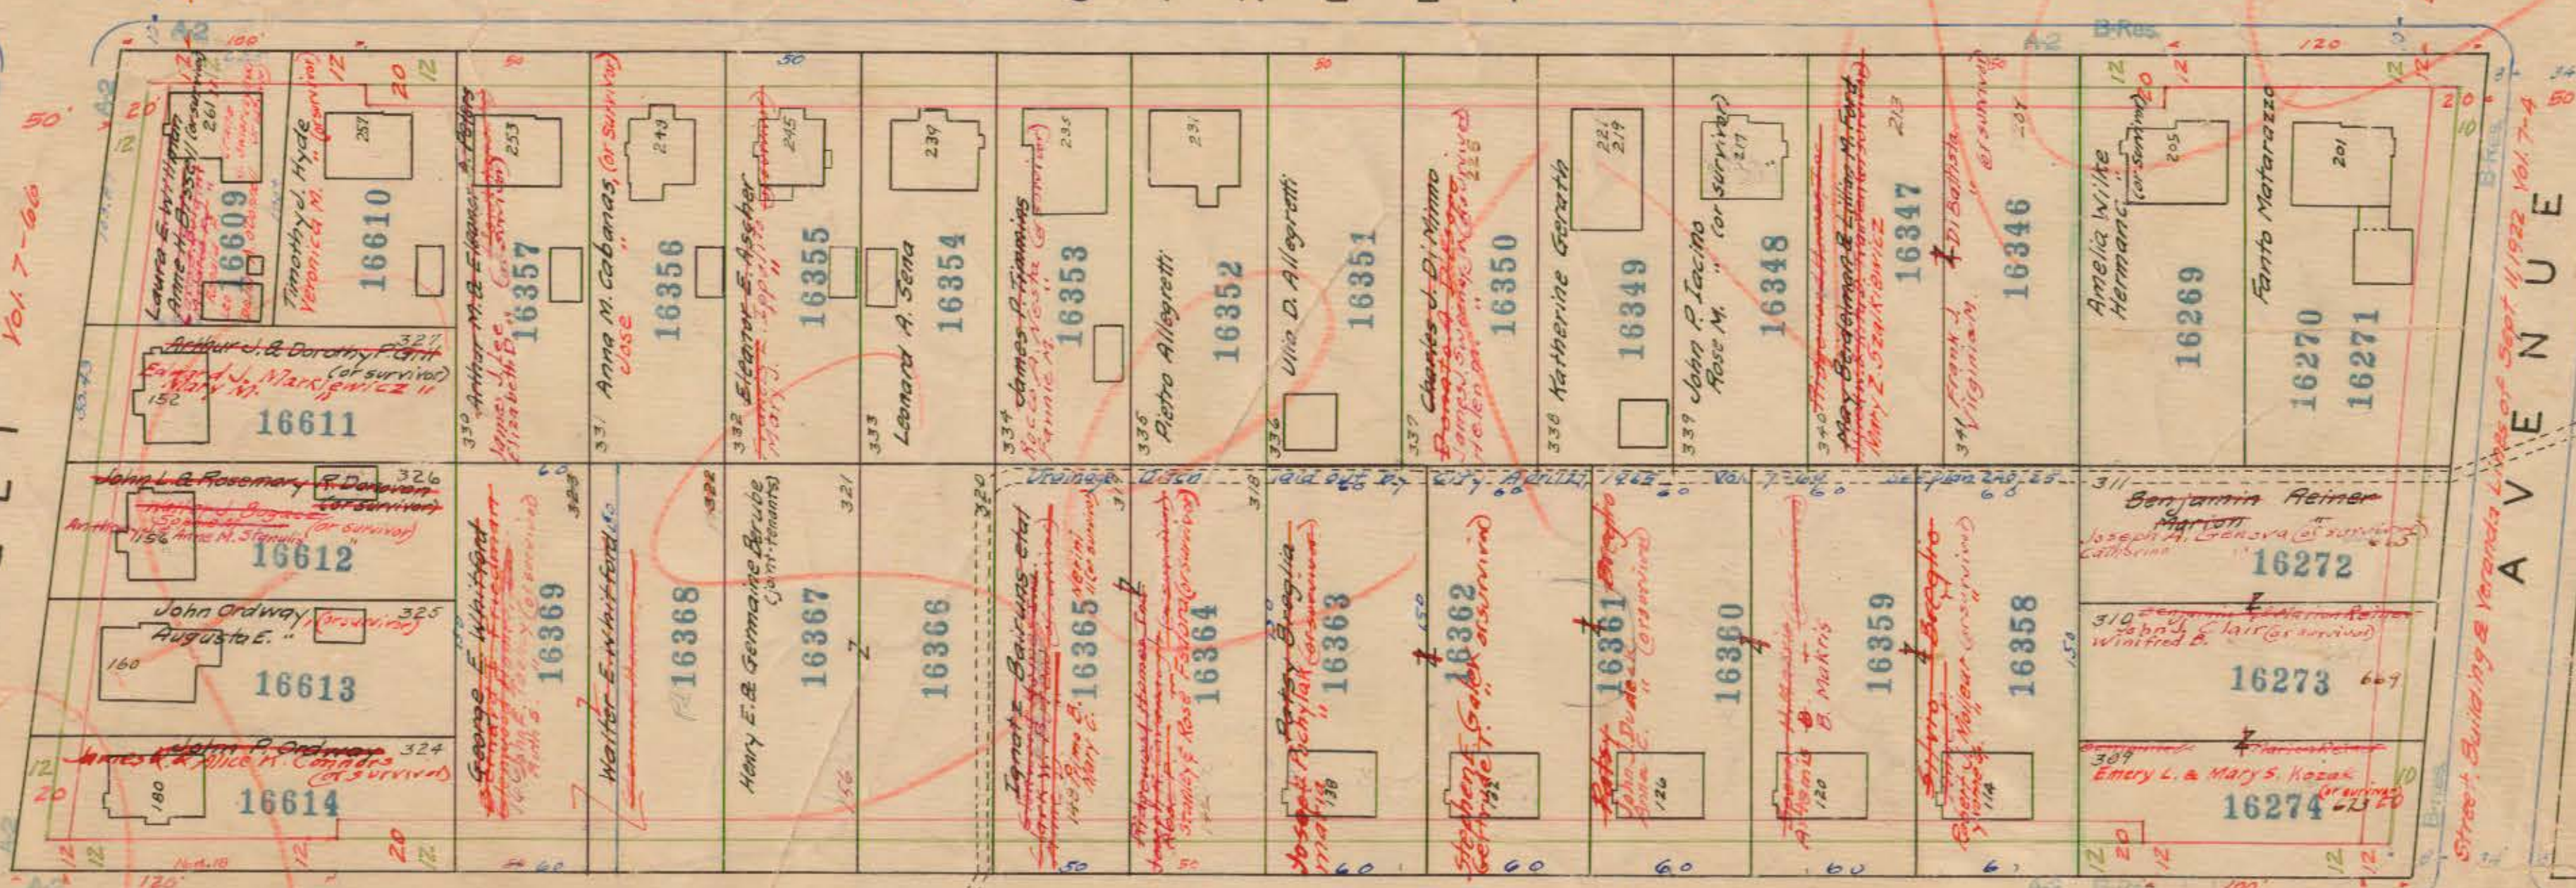


F R E E M A N




Street Building & Veranda Lines S T R E E T of March 23, 1925 Vol. 7-65

Vol. 7-65

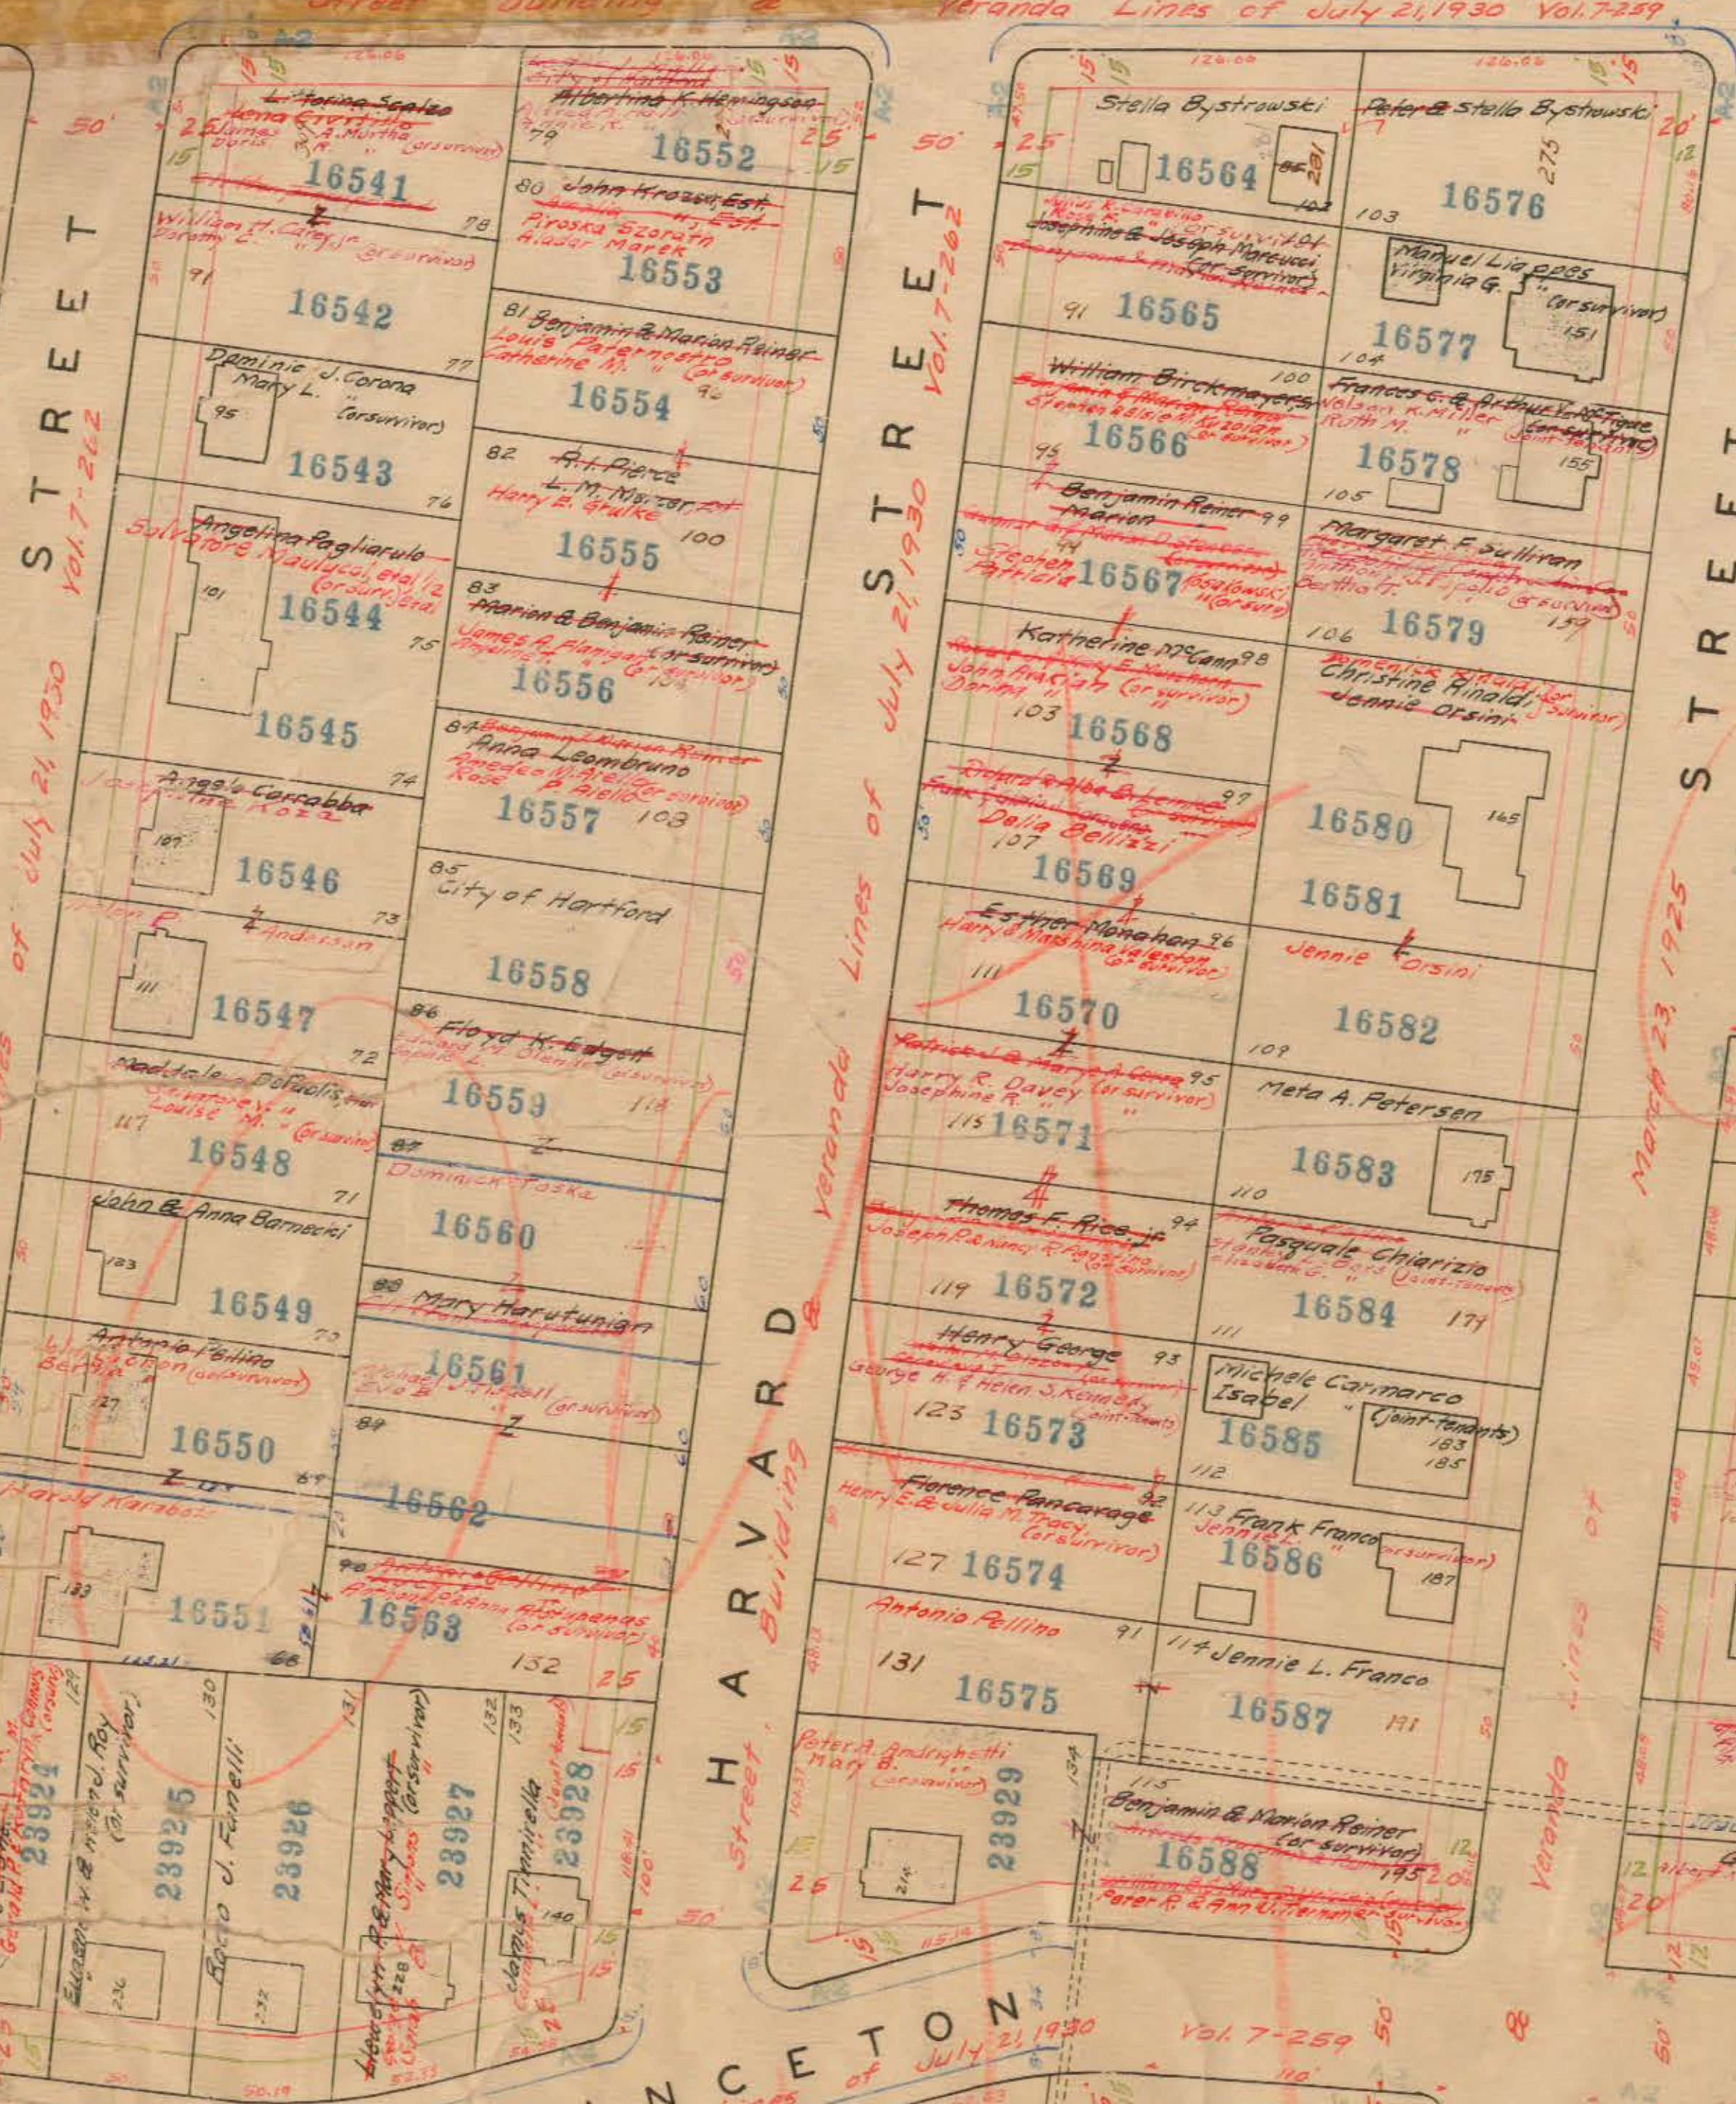



Y A L E Street, Building & Veranda Lines of March 23, 1925 S T R E E T Vol. 7-66

Vol. 7-66

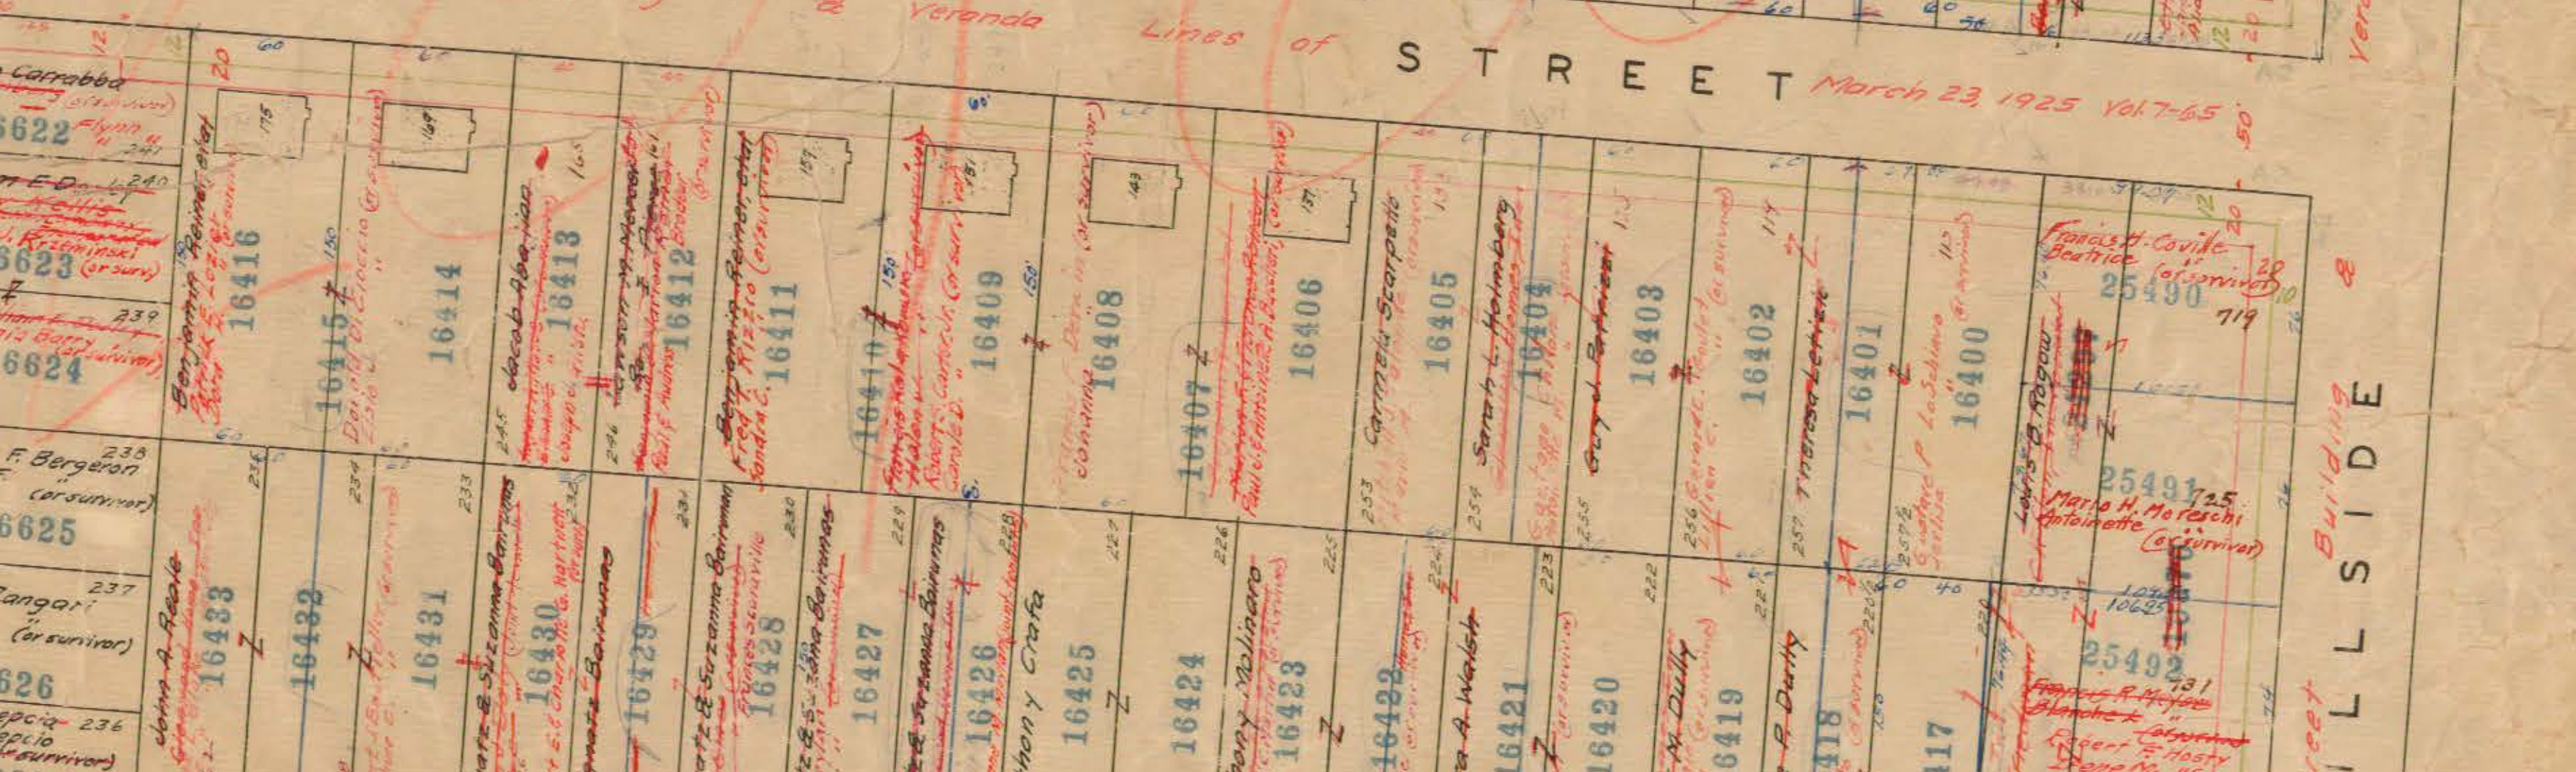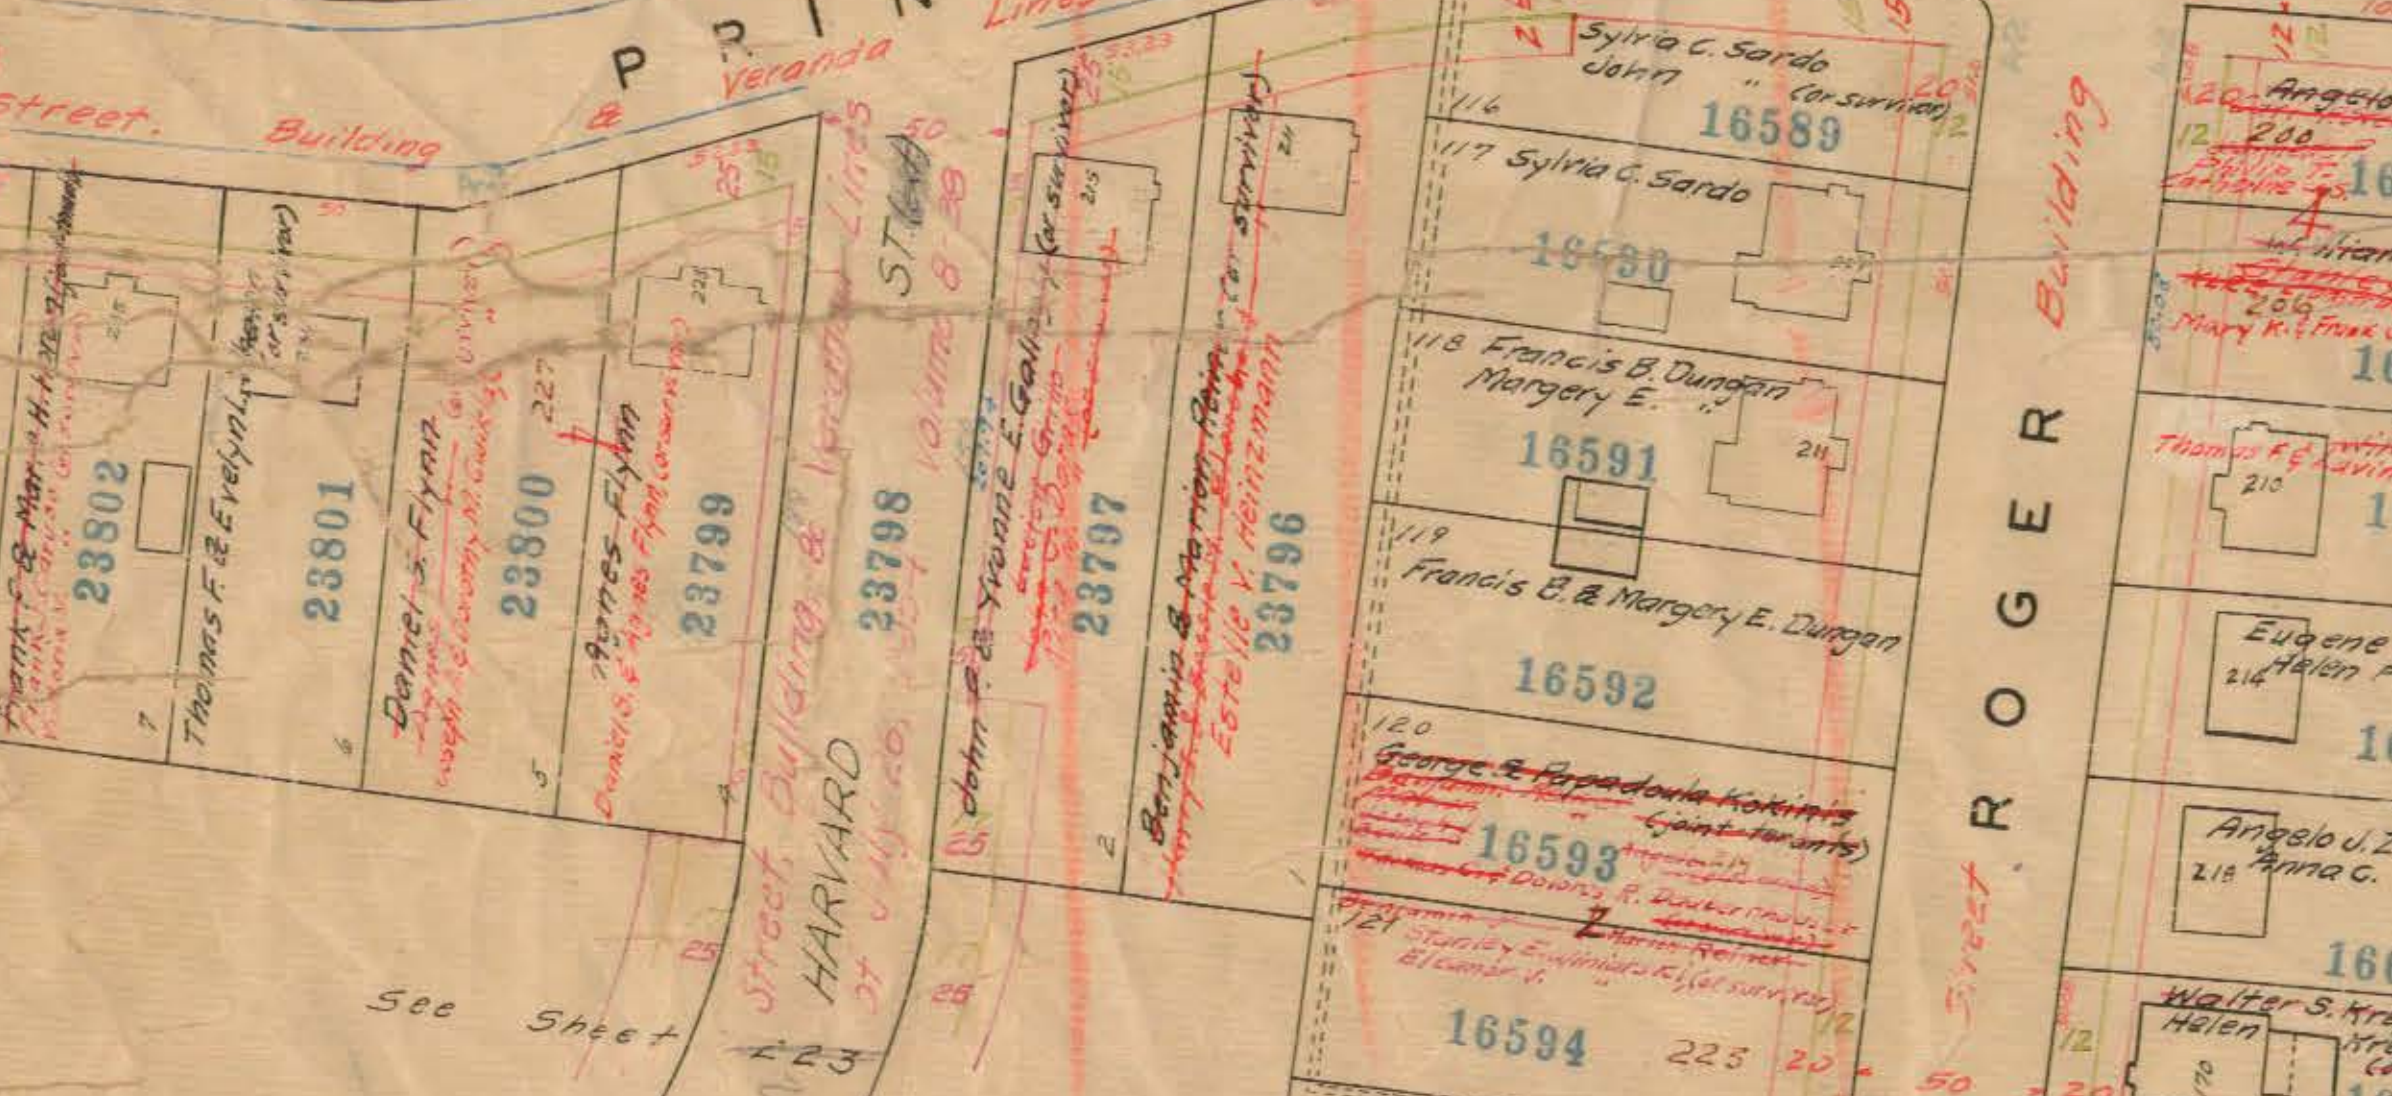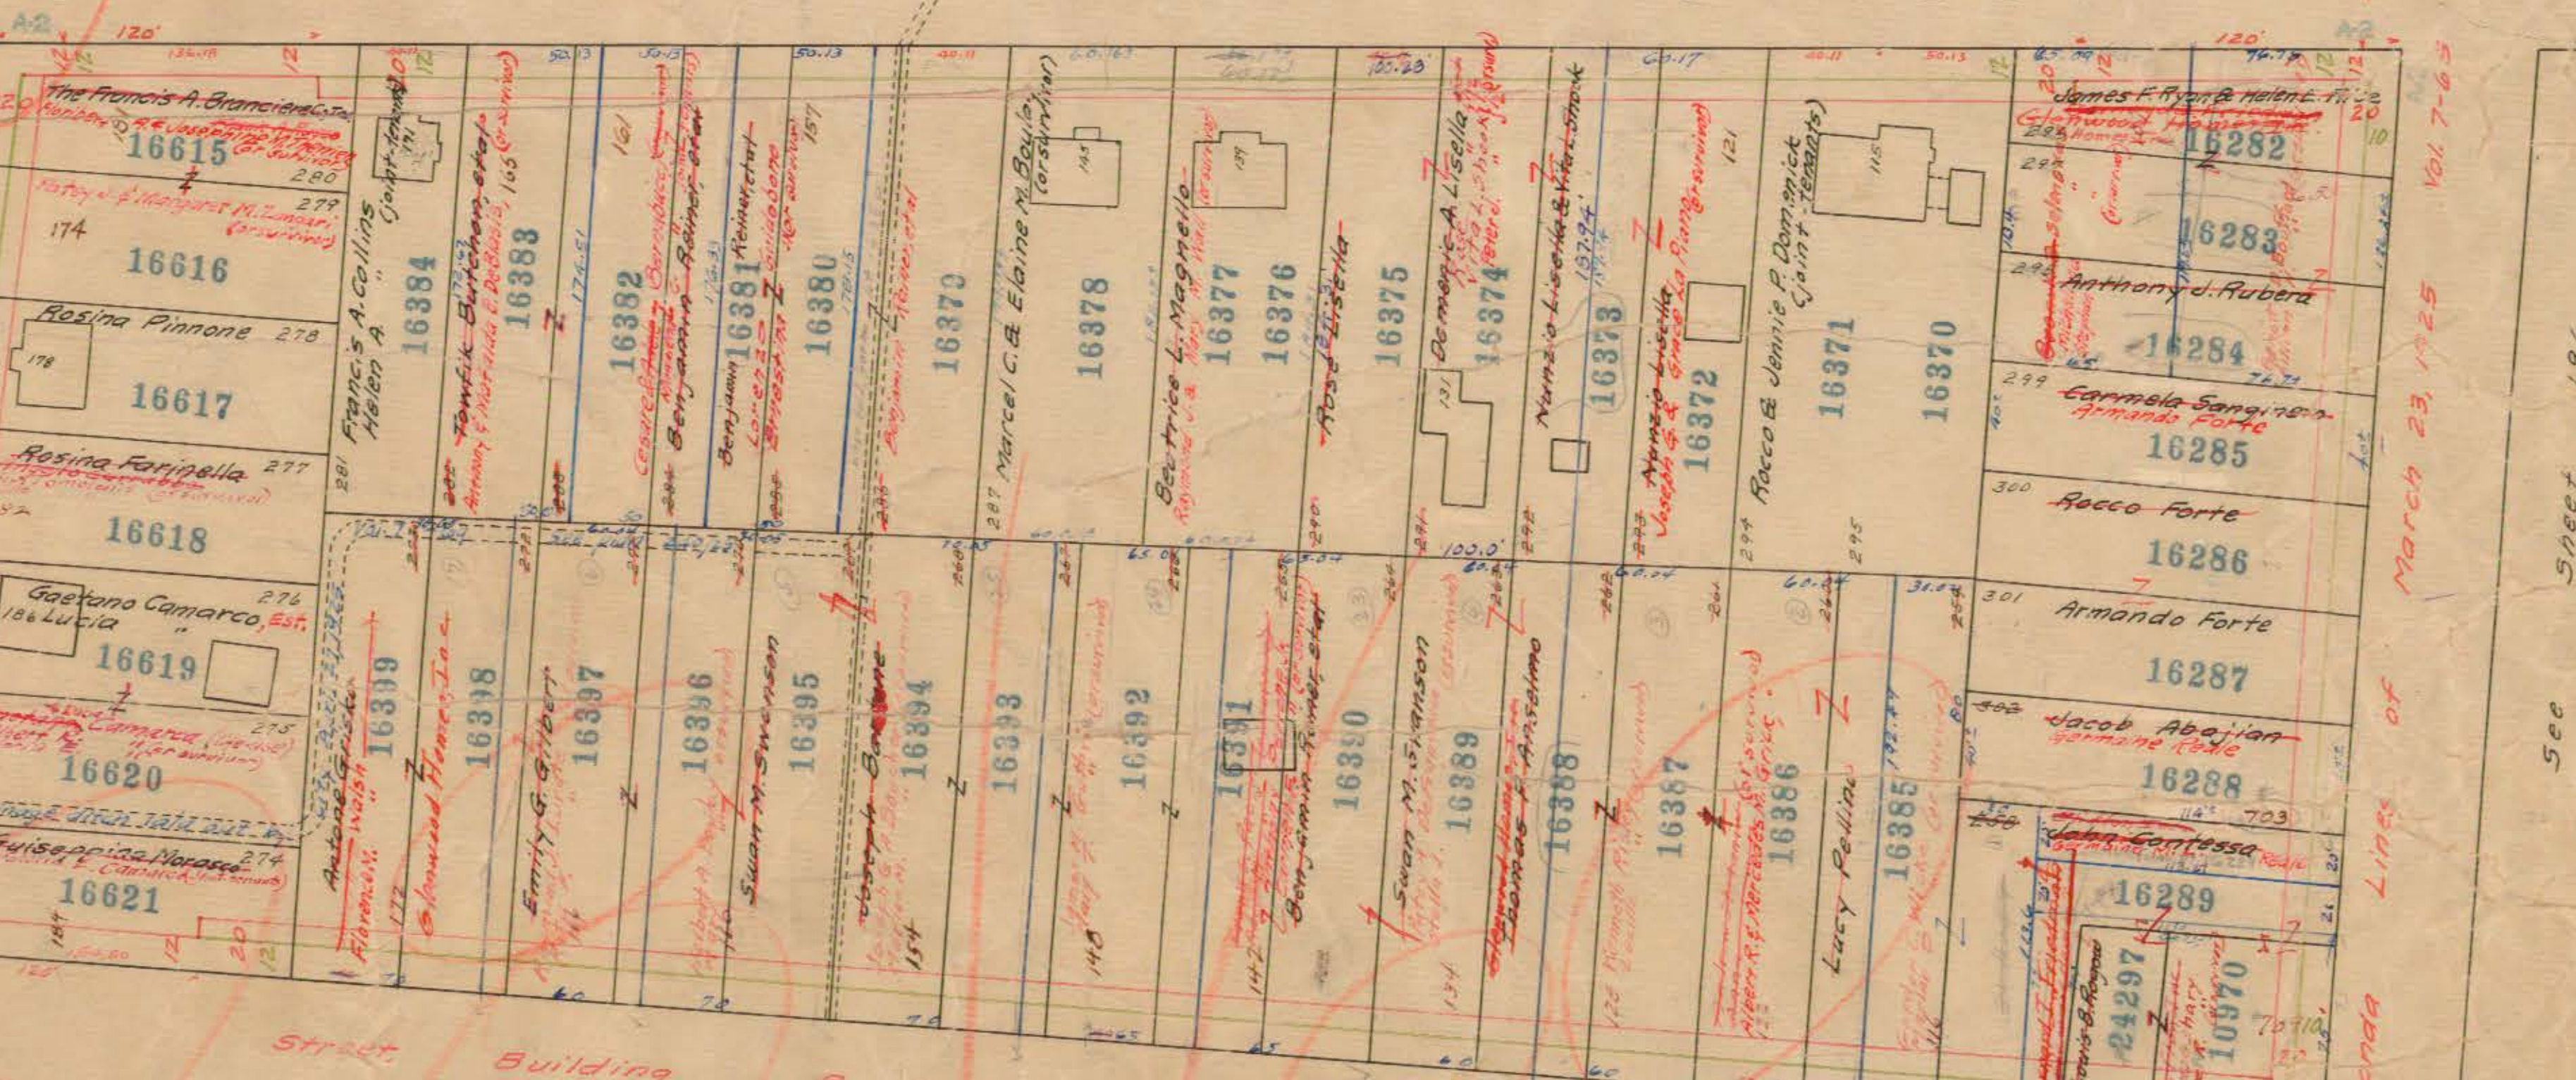

Street Building & Veranda Lines of March 23, 1925 S T R E E T Vol. 7-65

Vol. 7-65

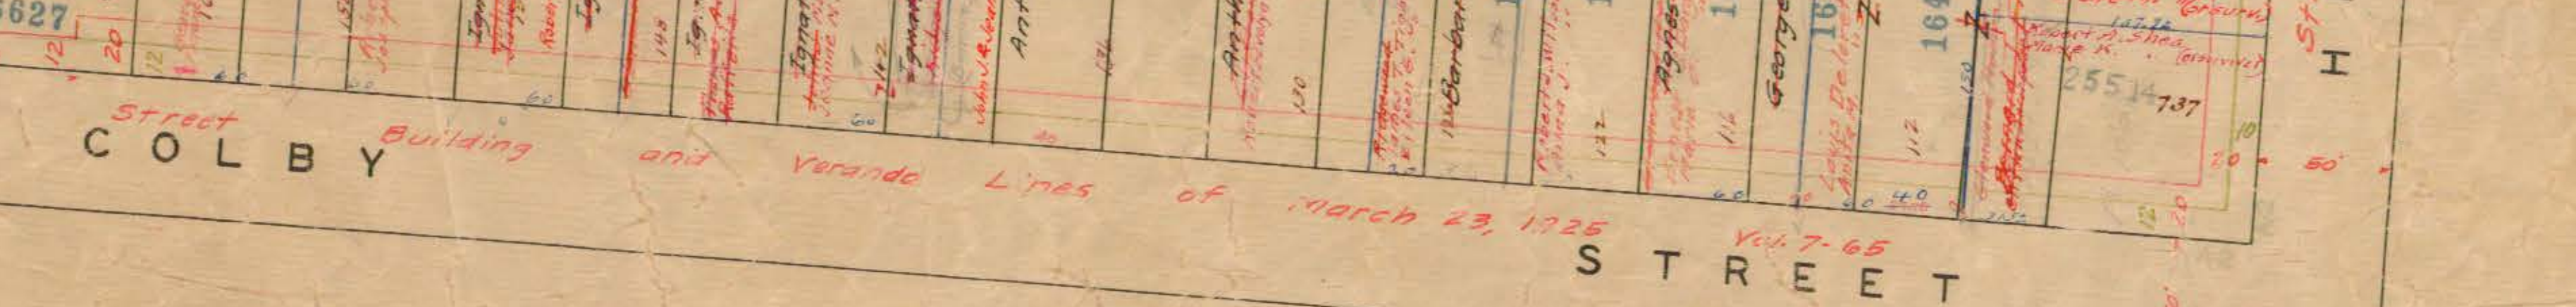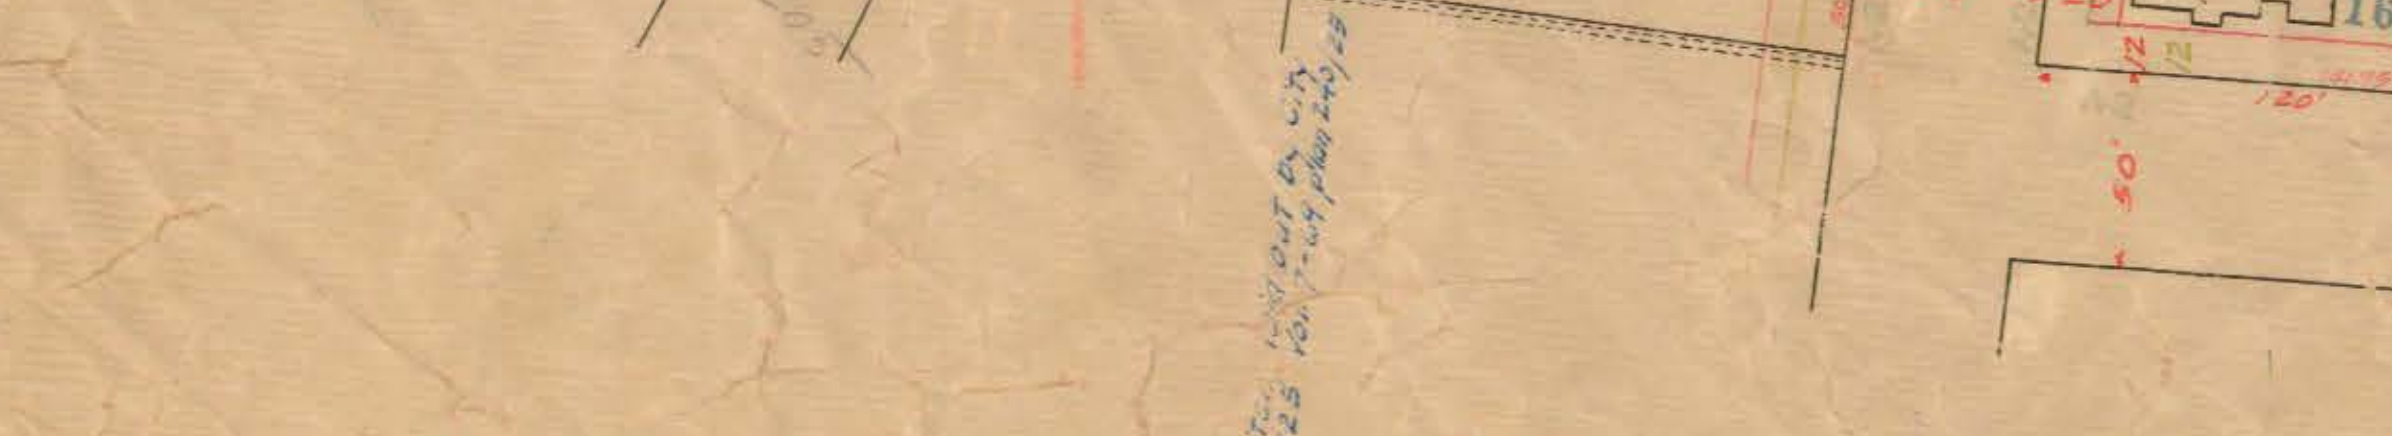

Street Building & Veranda Lines of March 23, 1925 S T R E E T Vol. 7-65

Vol. 7-65

