


See Sheet 114

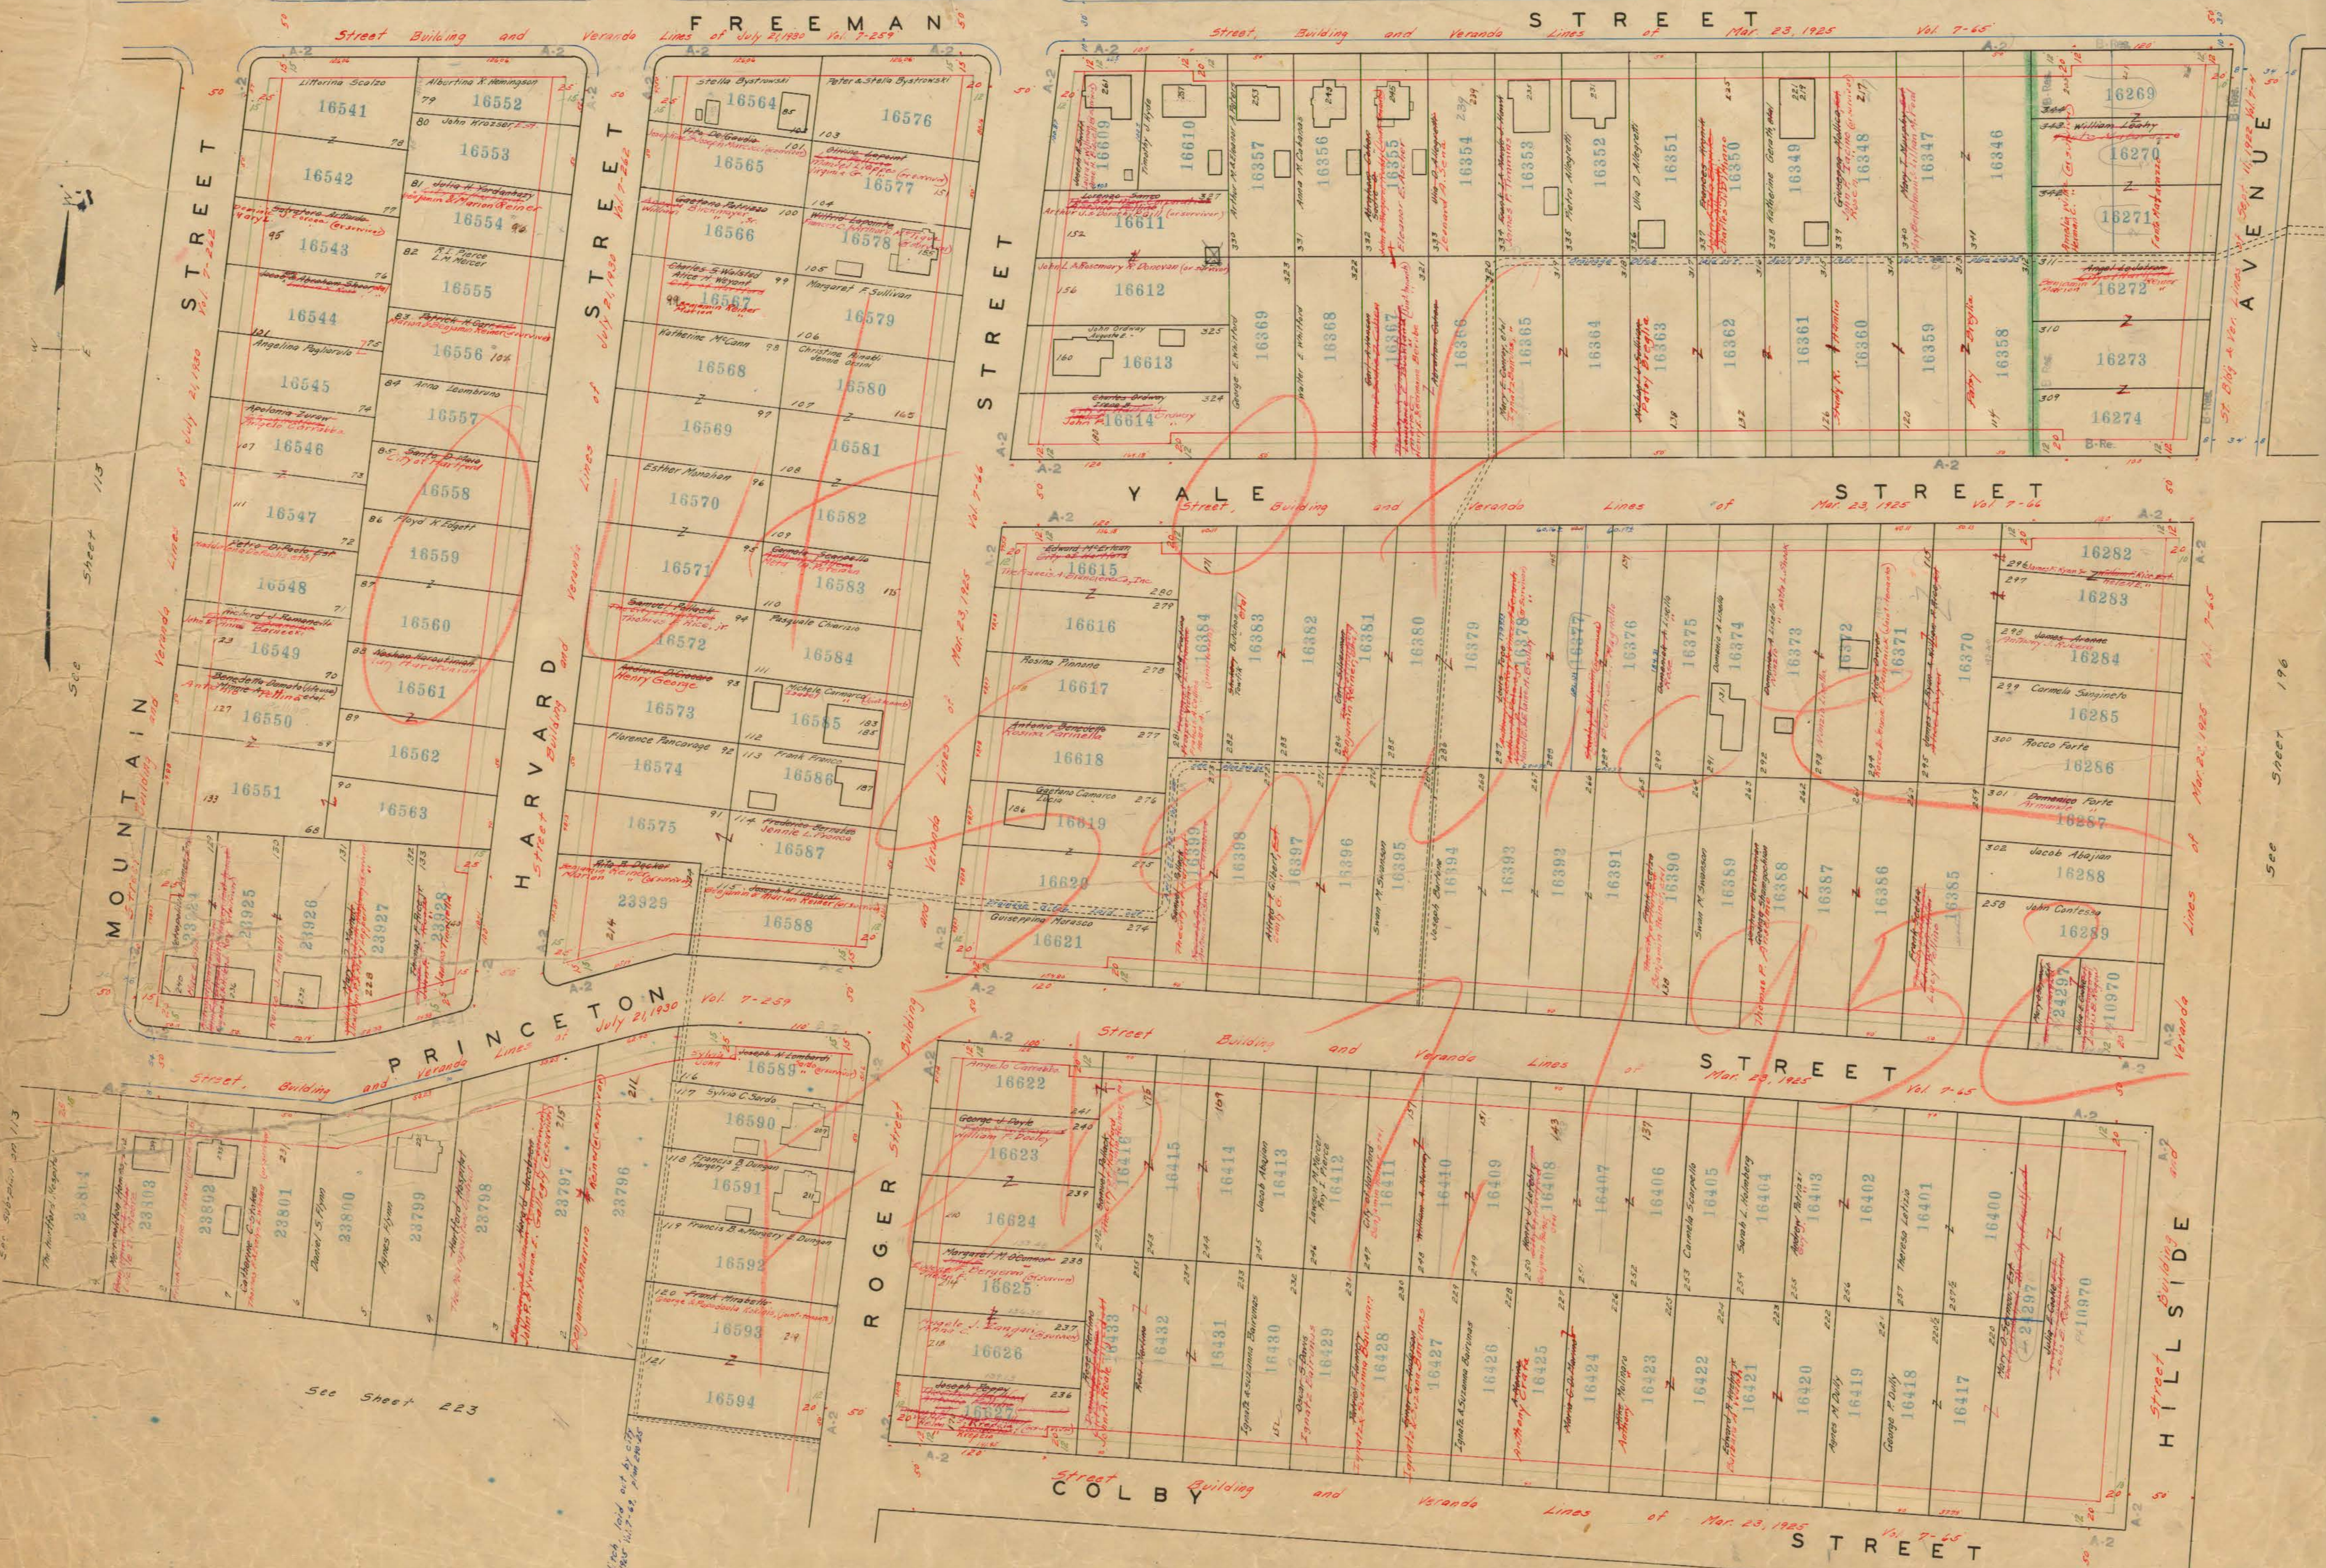

See Sheet 223

See Sheet 200