



See Sheet 114

FREEMAN STREET

Street, Building and Veranda Lines of July 21, 1930 Vol. 7-259


STREET

Mar. 23, 1925 Vol. 7-65

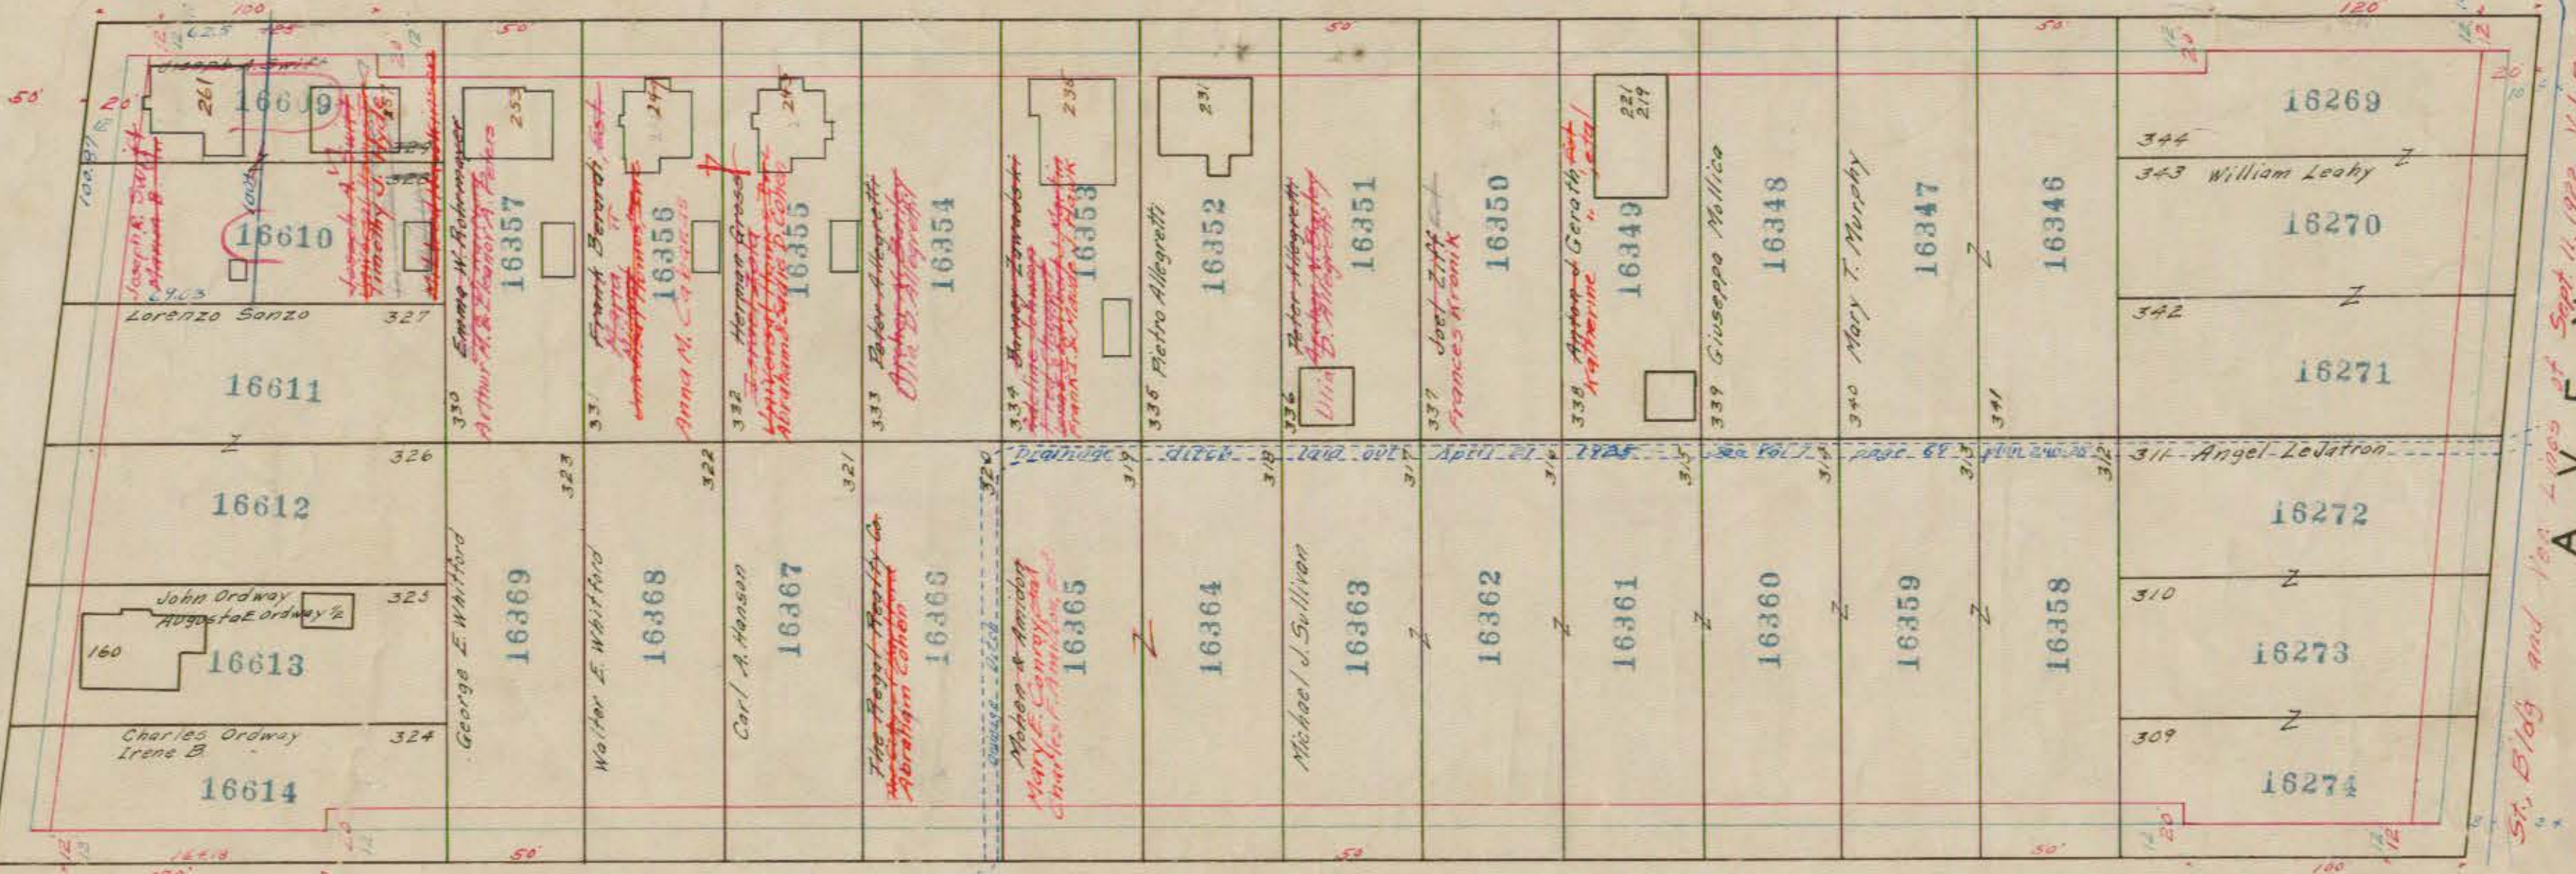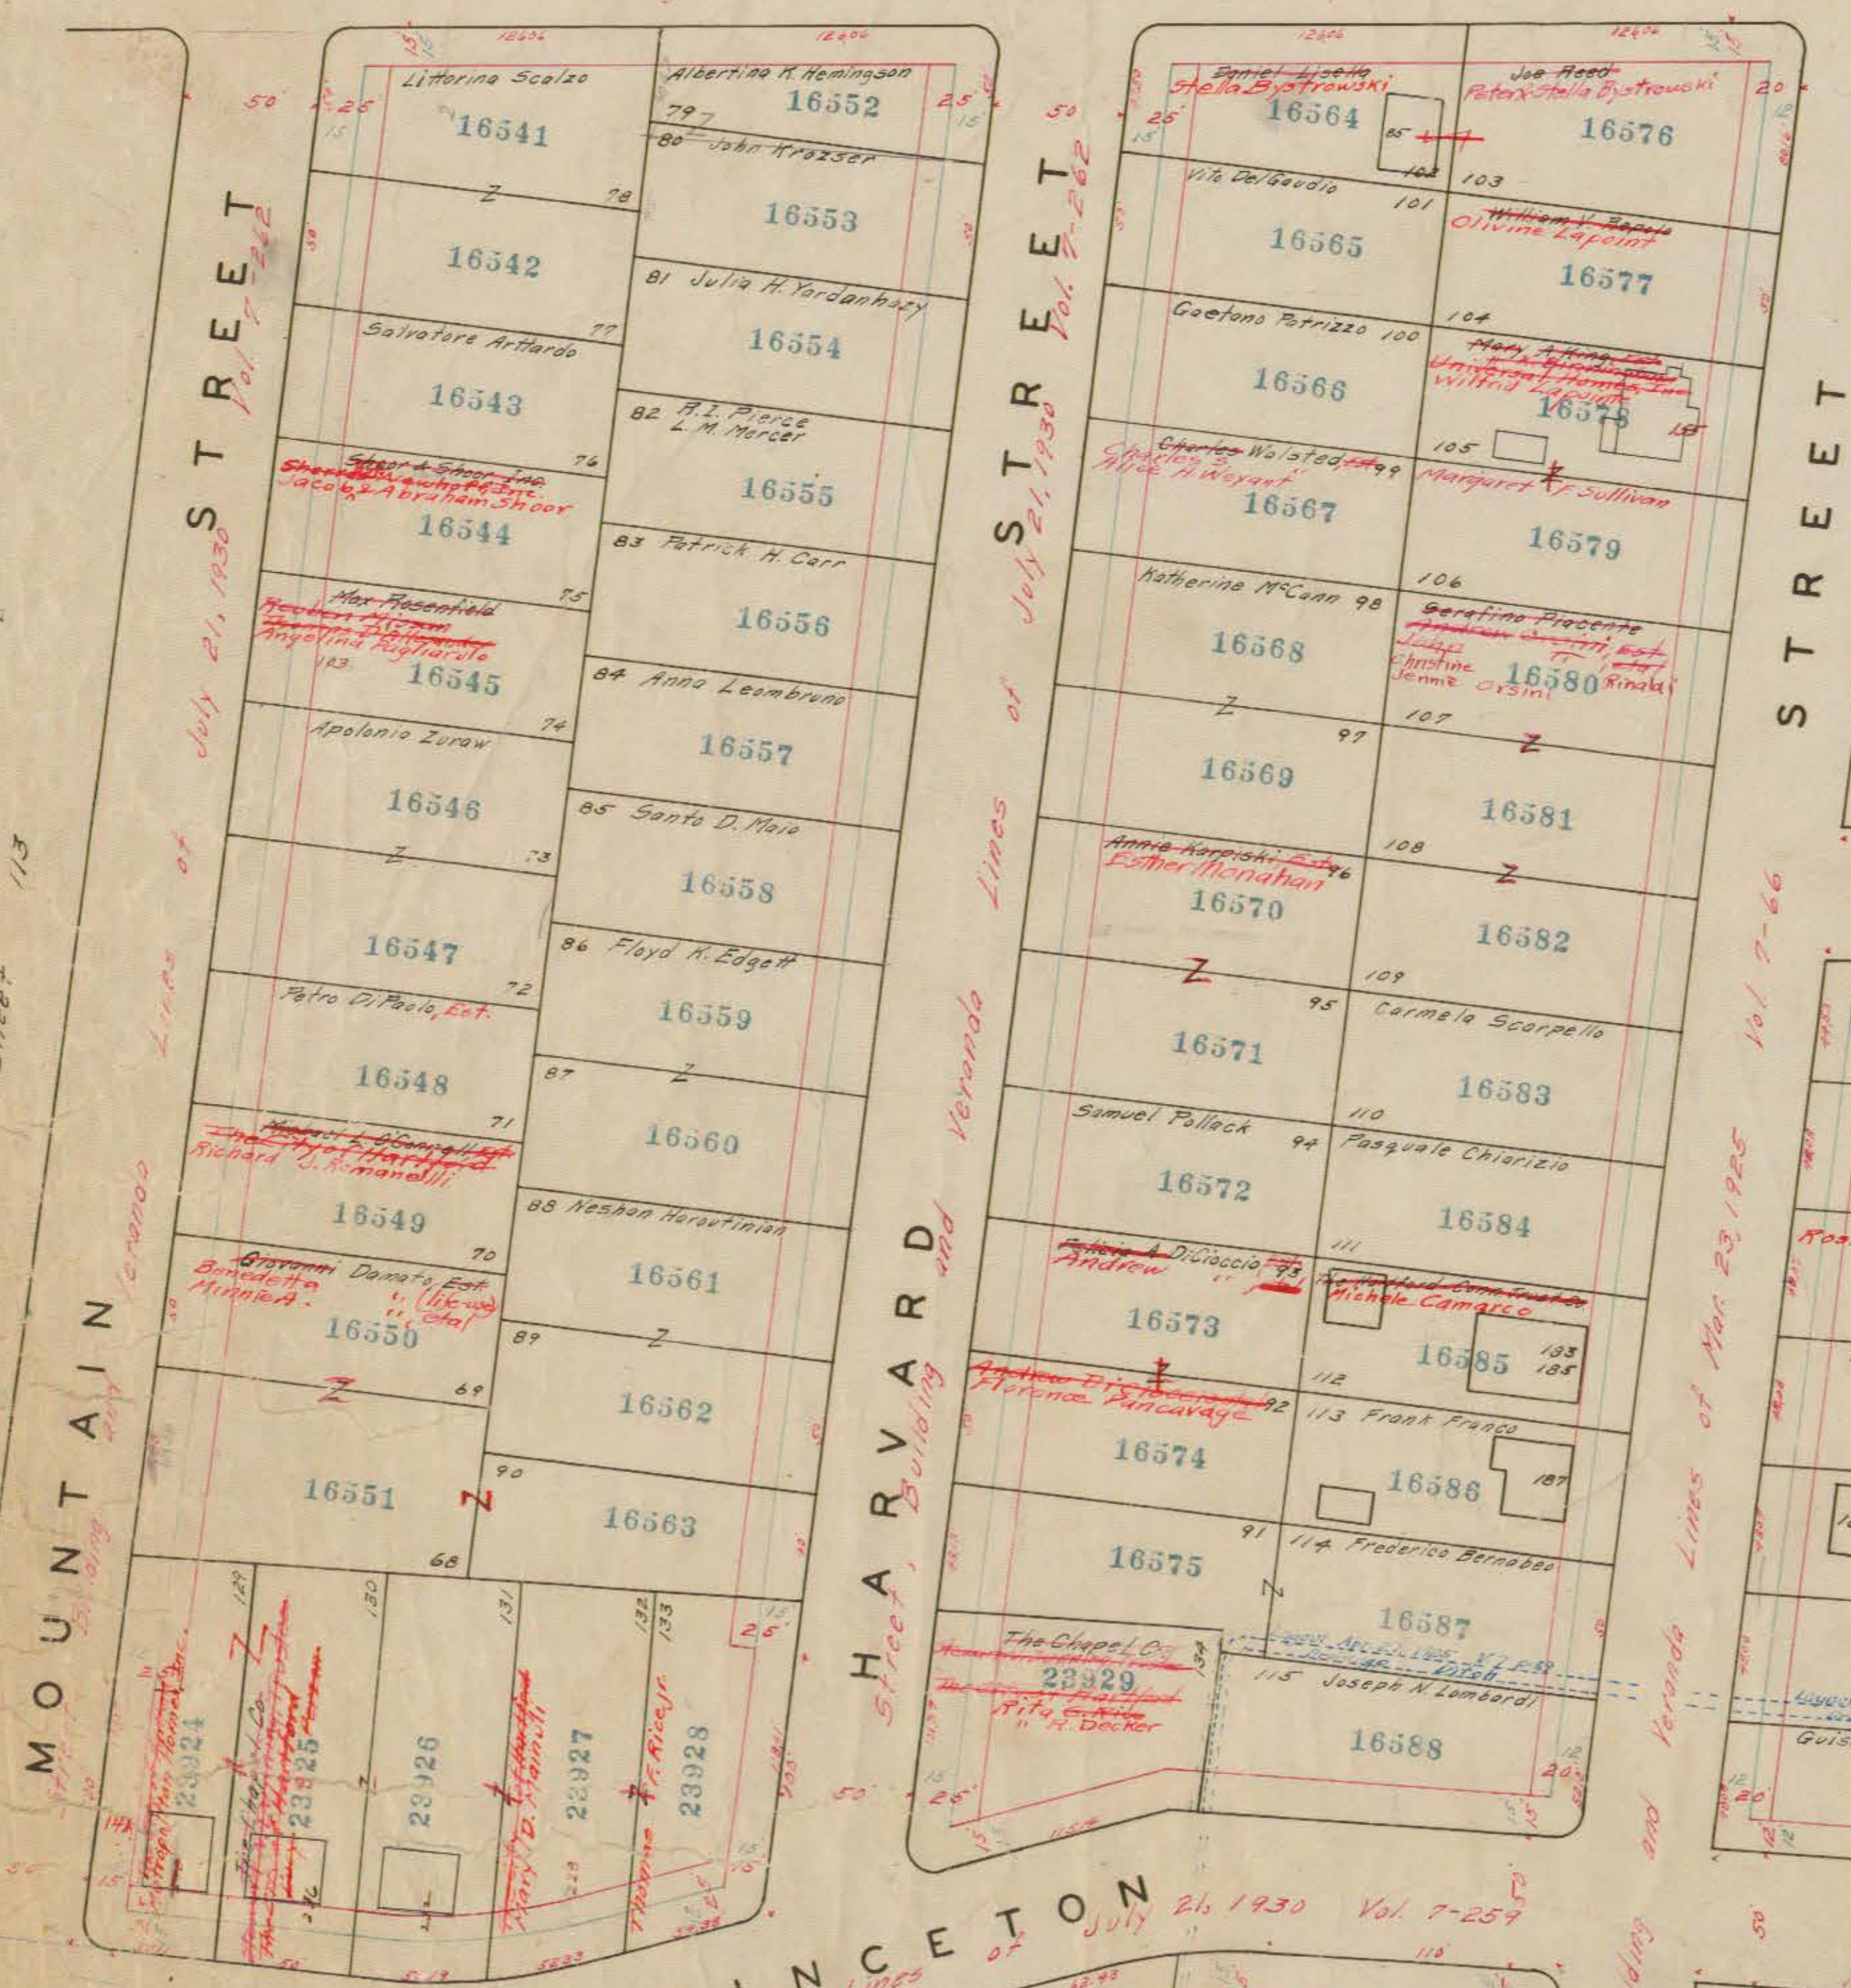


YALE STREET

Mar. 23, 1925 Vol. 7-66

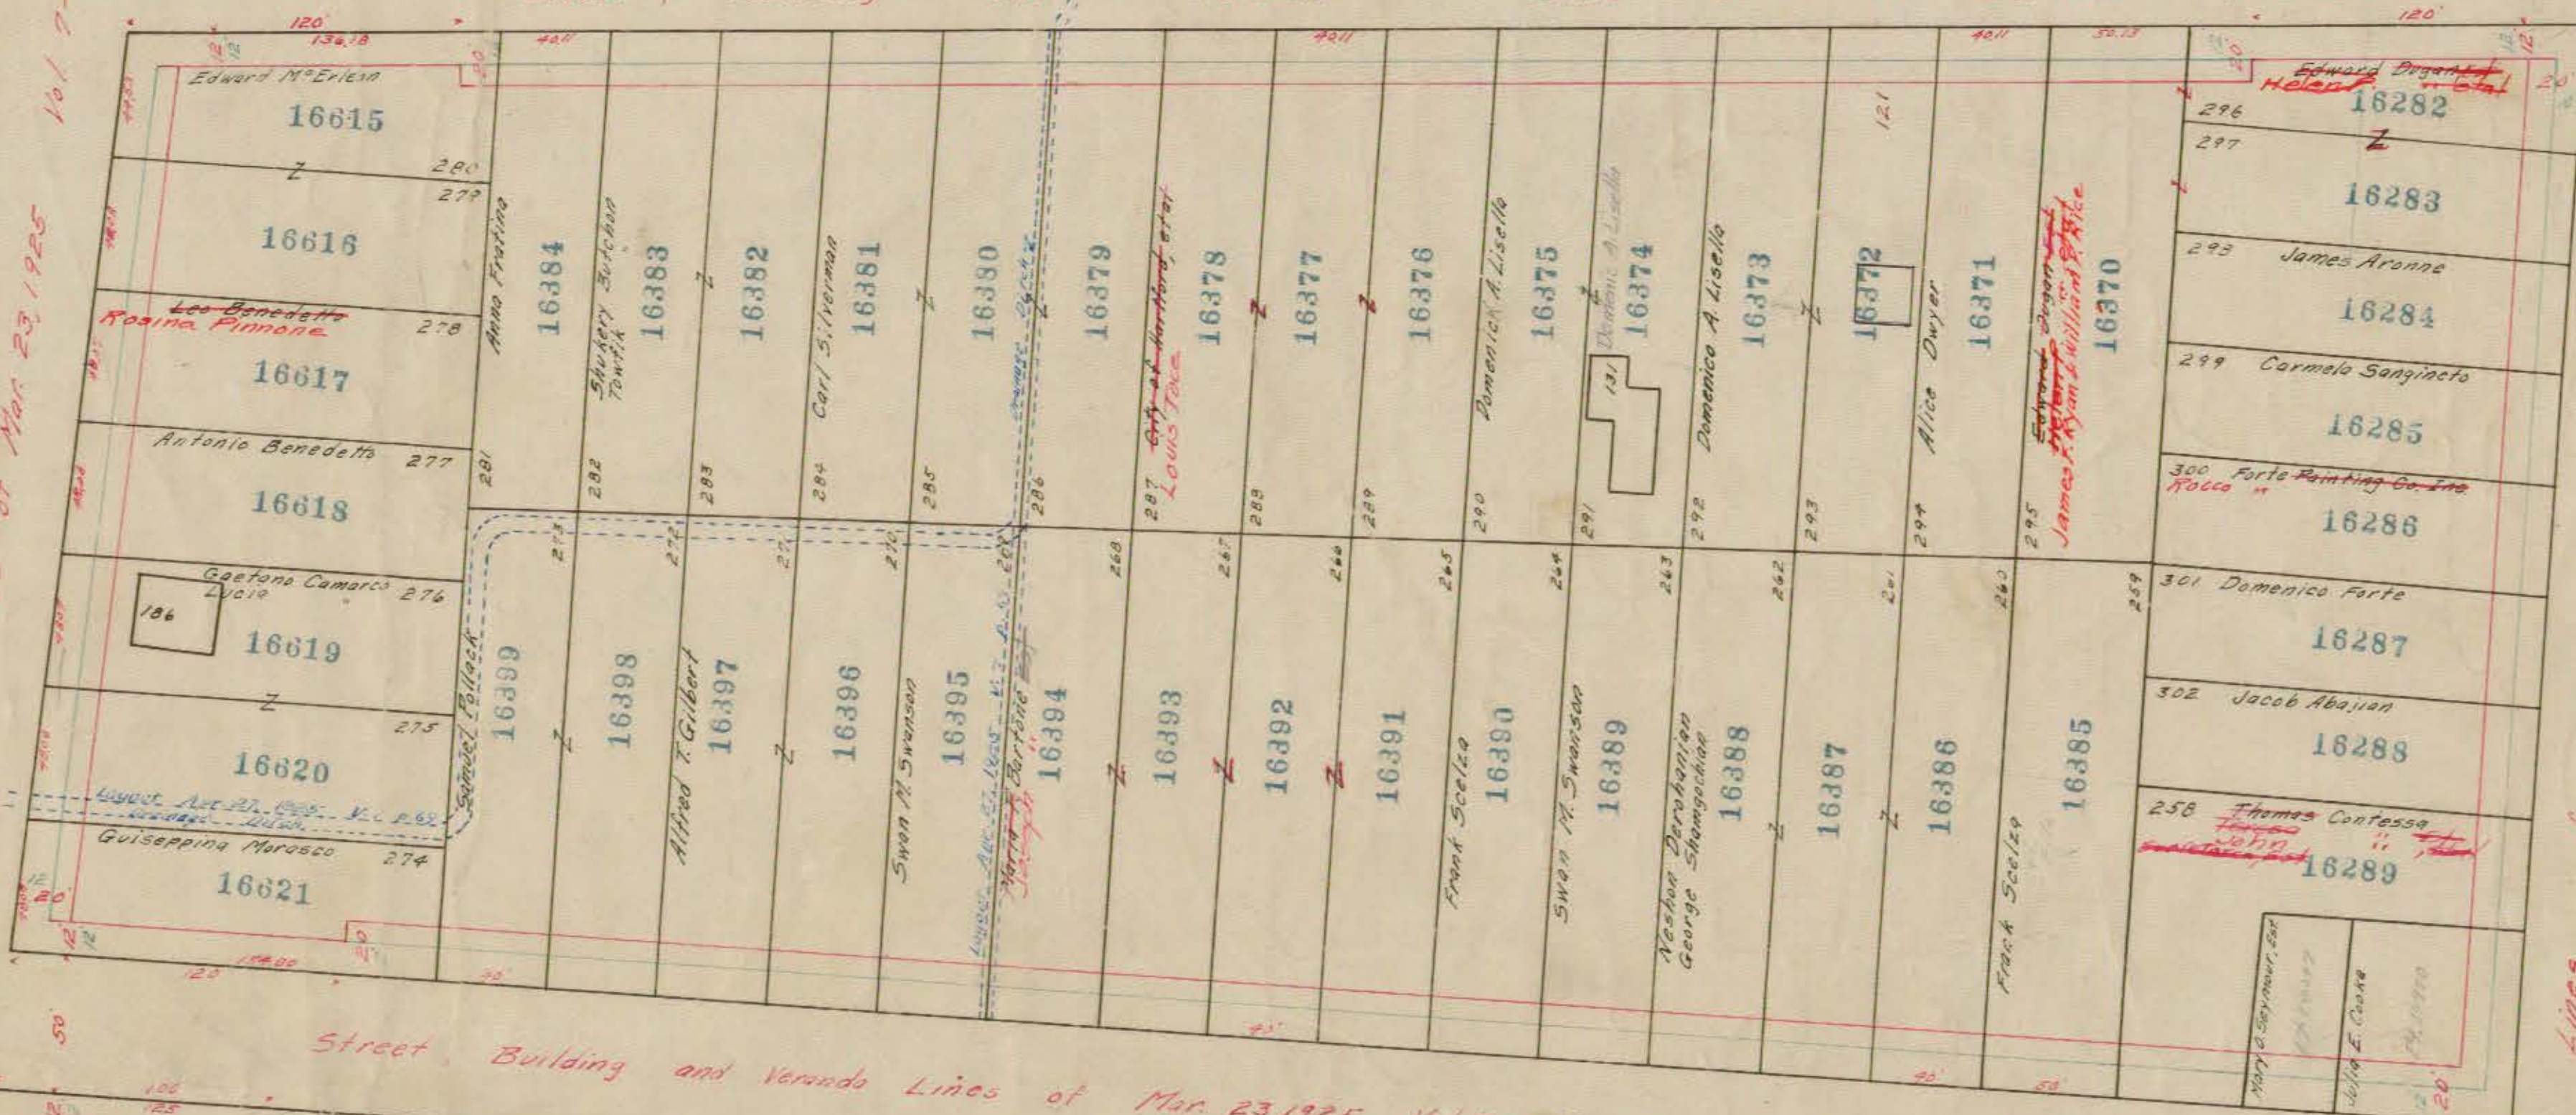

STREET

Mar. 23, 1925 Vol. 7-65

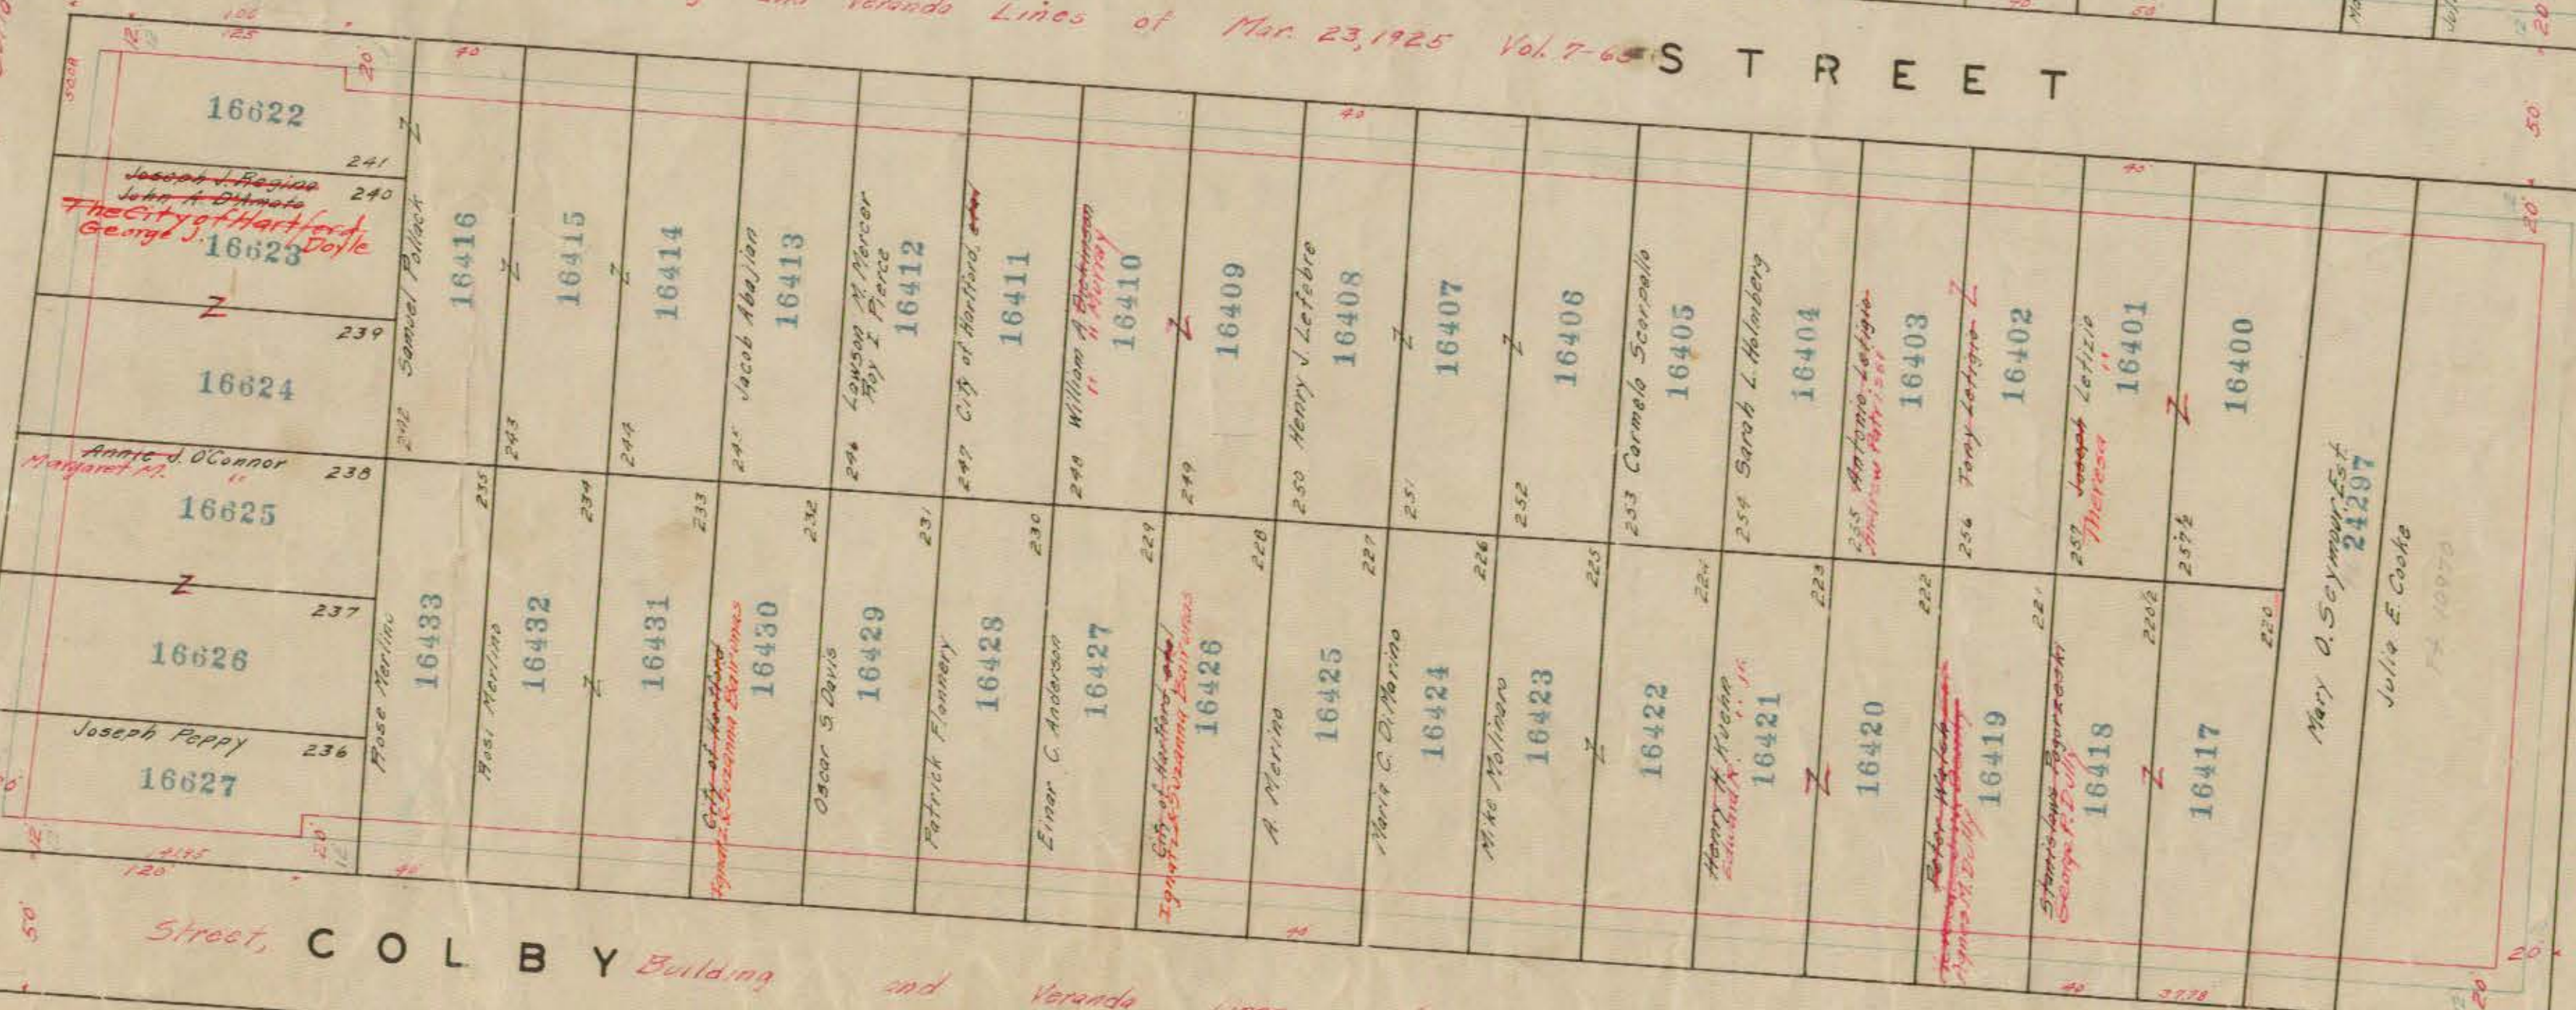

COLBY STREET

Mar. 23, 1925 Vol. 7-65

See Sheet 223

See Sheet 200