

SMITH STREET Center Line
735 SMITH ST. East Fence Line

734 735

CITY ENGINEER'S OFFICE,
HARTFORD, CONN.
STREET & MISCELLANEOUS DEPT.
Drawn Sep. 5, 1900 Day Book No. 0942.
City Engineer

SECTION PAPER, 10x10-1 INCH.

71.18 at E. Line of Smith St.

725 Intersection of
Center Lines

72.52
725 Intersection of
Center Lines

73.76 (PI 64600 1926
12.5 ft North of 6567)


CHADWICK AVENUE

SCALE - VERT. 1" = 10'
HORI. 1" = 50'

PI 64600 1926
12.5 ft North of 6567

Note - East-Curb changed grade
R.I. 1926

PI 64600 1926
12.5 ft North of 6567

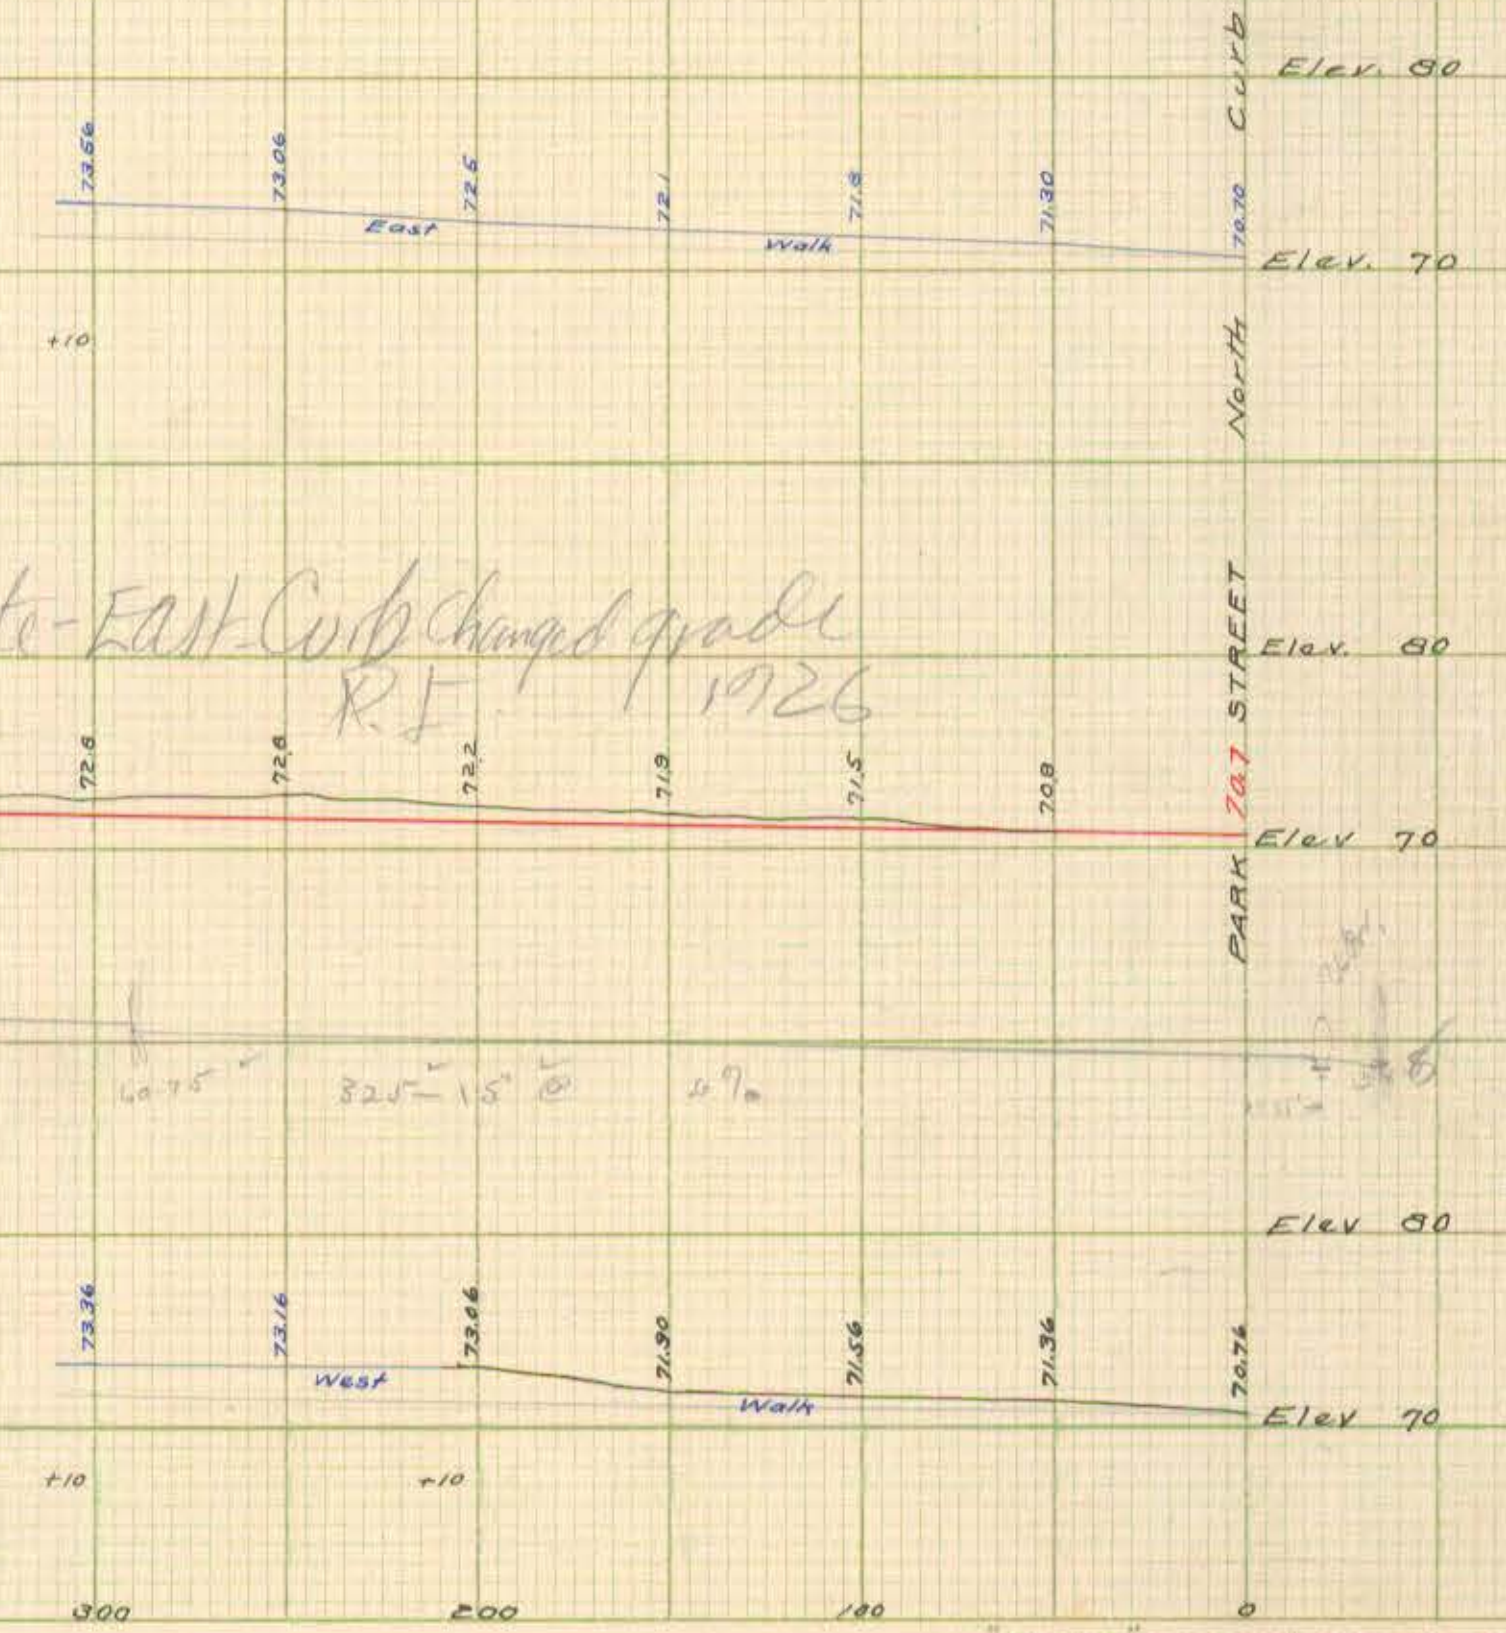

"Perfect" CROSS SECTION PAPER, 10x10-1 INCH.

"Perfect" CROSS SECTION PAPER, 10x10-1 INCH.