


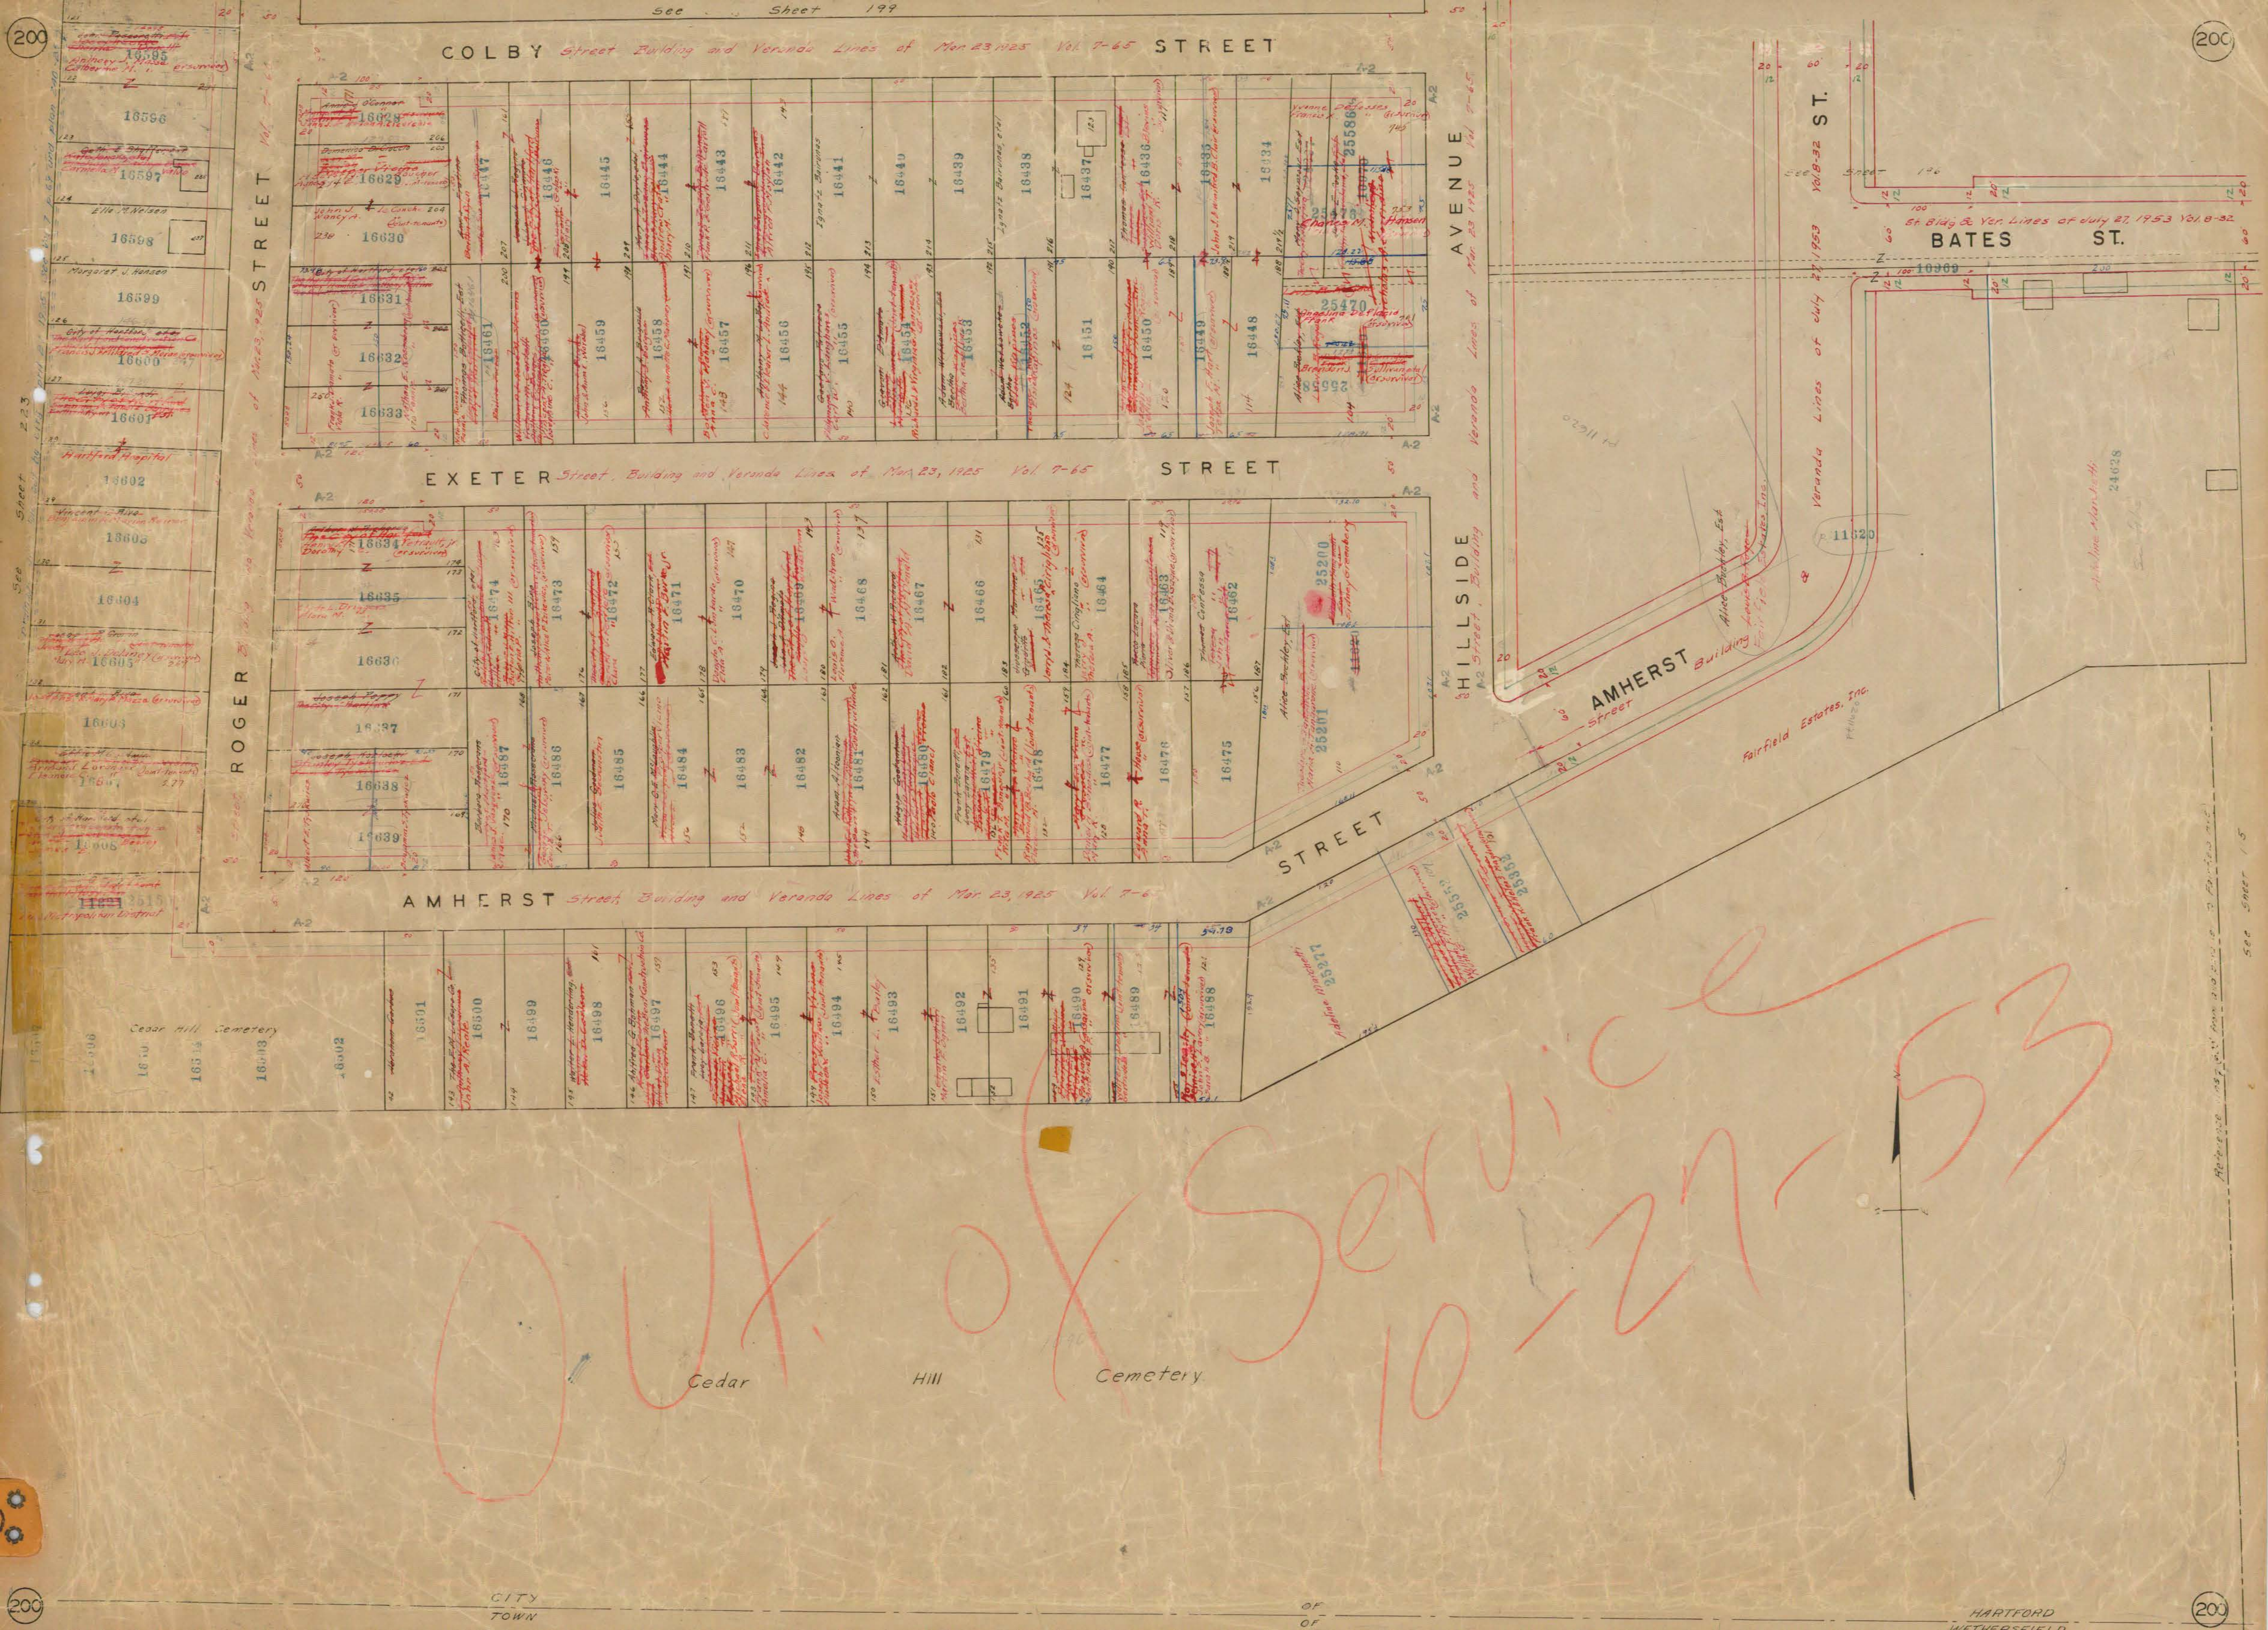

COLBY Street Building and Veranda Lines of Mar 23, 1925 Vol 7-65 STREET

EXETER Street Building and Veranda Lines of Mar 23, 1925 Vol 7-65 STREET

AMHERST Street Building and Veranda Lines of Mar 23, 1925 Vol 7-65

HILLSIDE AVENUE

BATES ST.

AMHERST STREET

Fairfield Estates, Inc.

Cedar Hill Cemetery

OUT OF SERVICE 10-27-53