


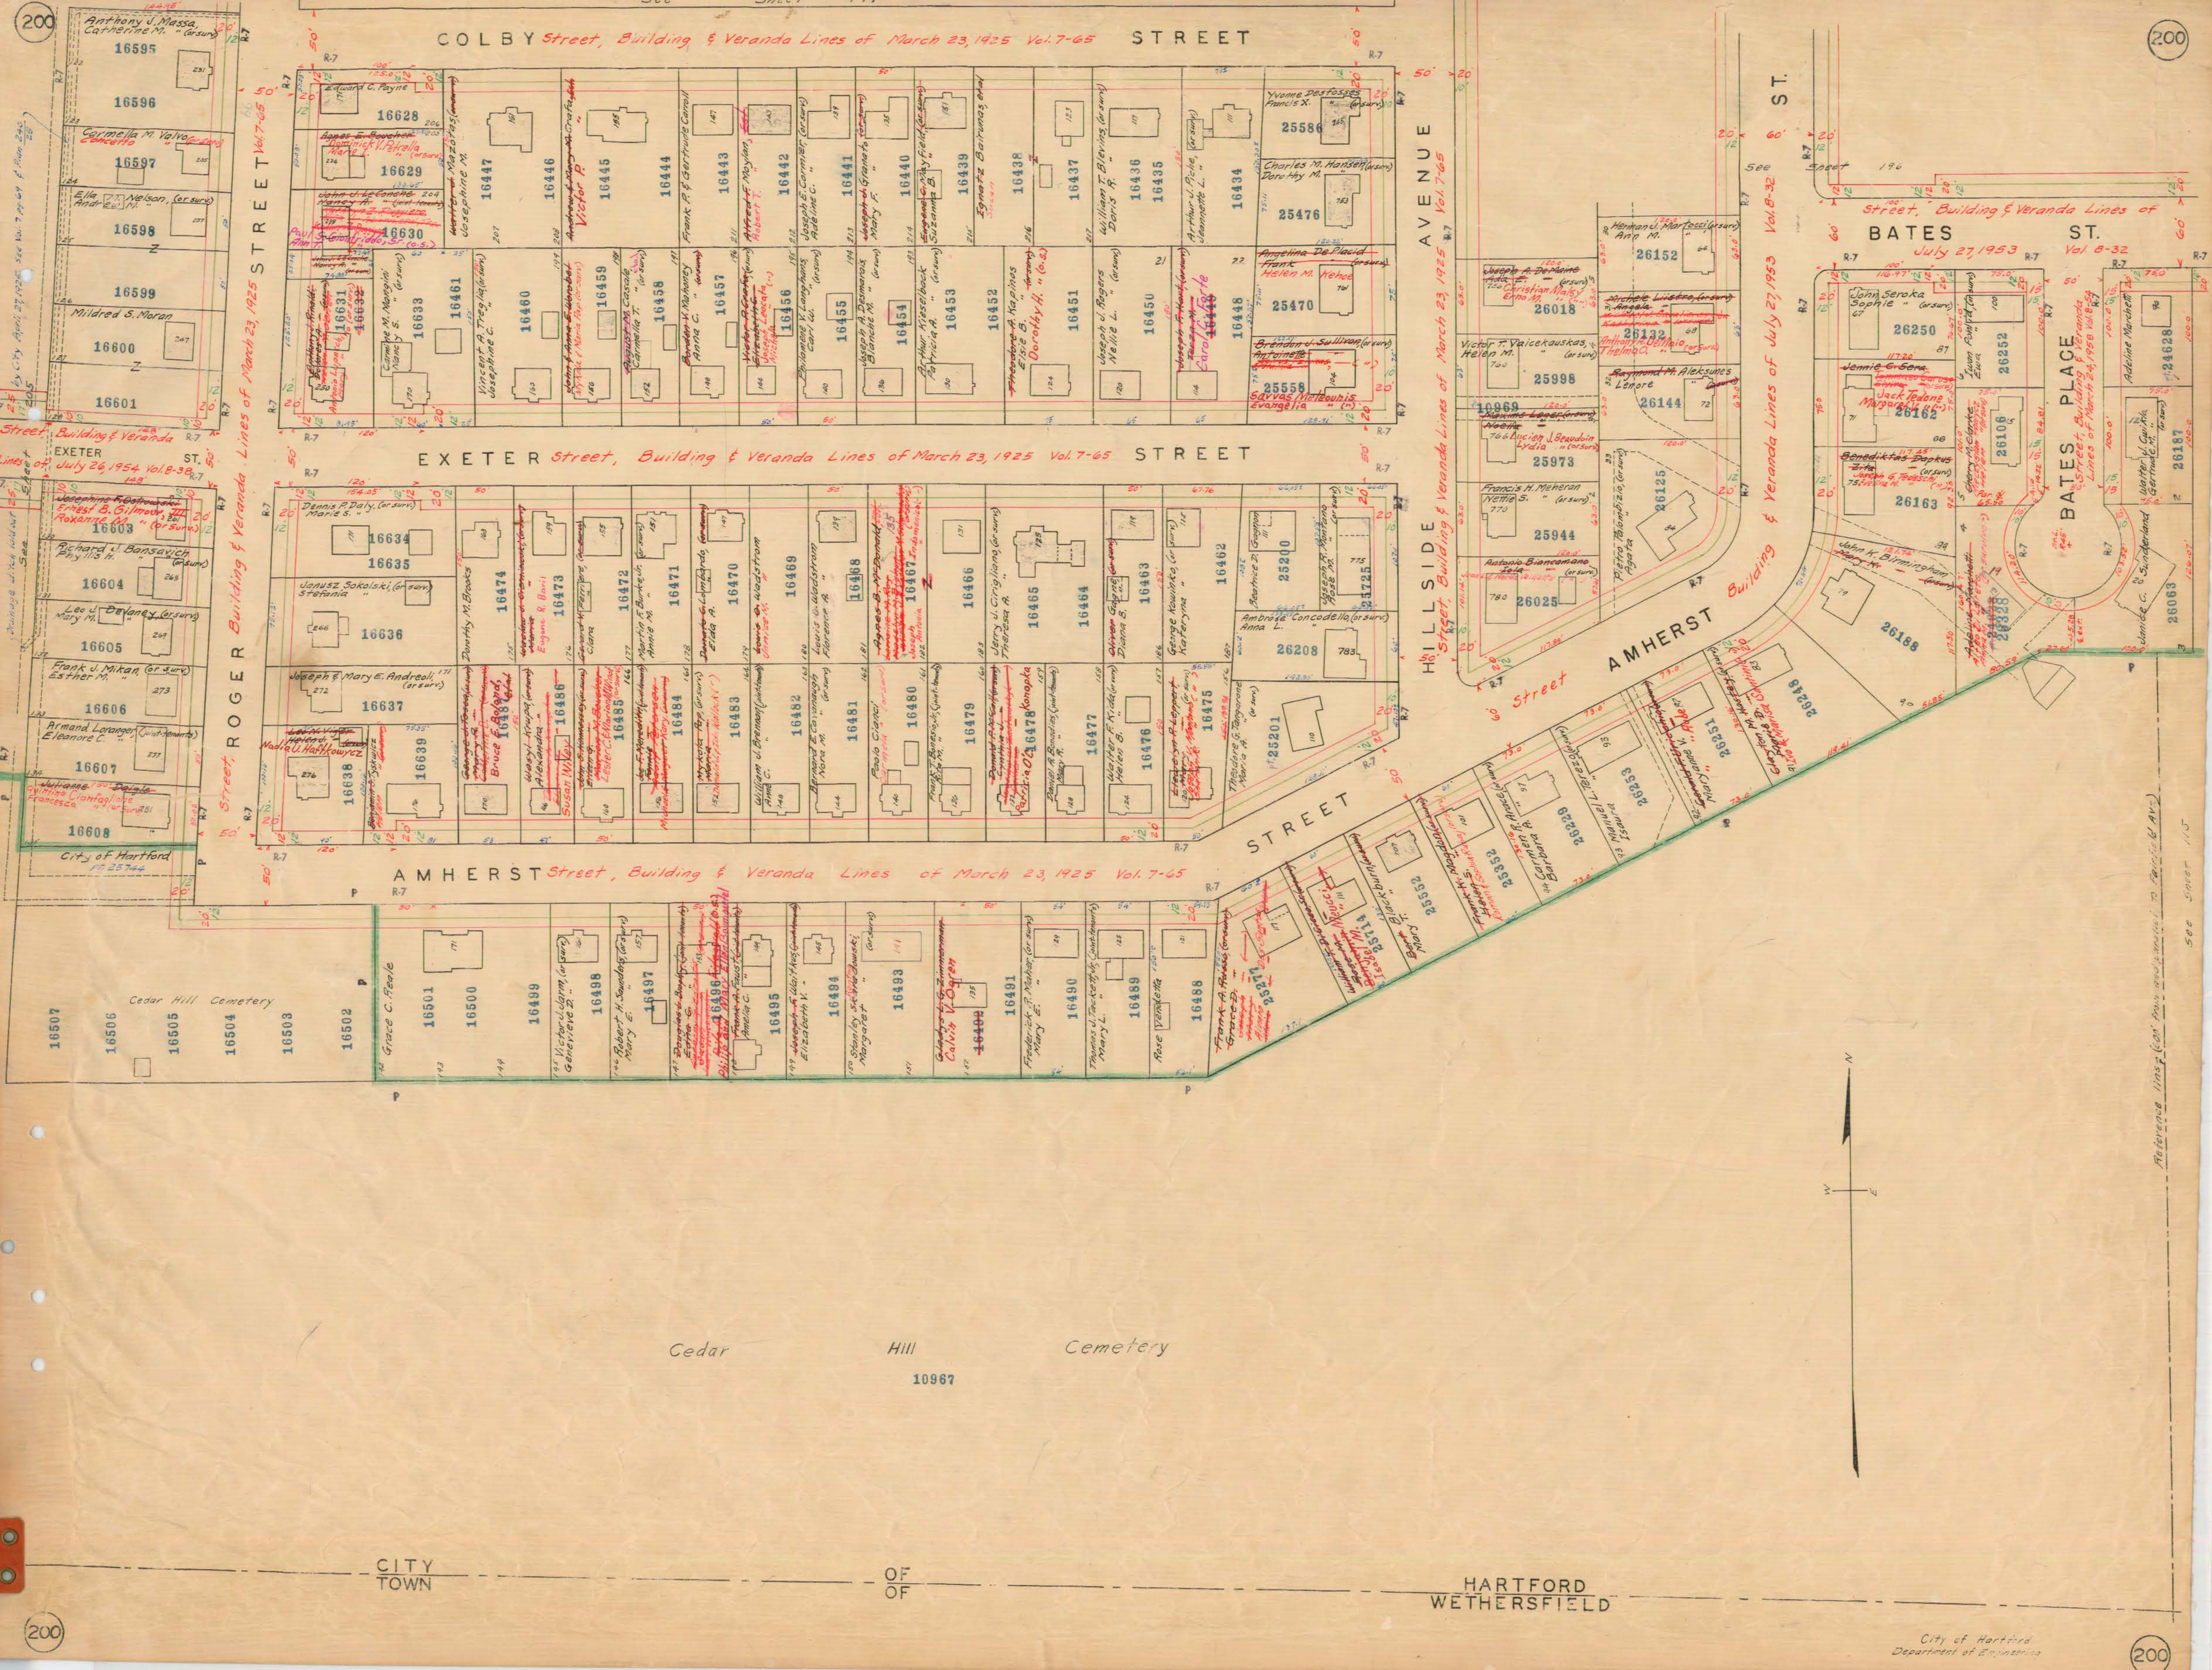

COLBY Street, Building & Veranda Lines of March 23, 1925 Vol. 7-65 STREET

EXETER Street, Building & Veranda Lines of March 23, 1925 Vol. 7-65 STREET

AMHERST Street, Building & Veranda Lines of March 23, 1925 Vol. 7-65

HILLSIDE AVENUE Street, Building & Veranda Lines of March 23, 1925 Vol. 7-65

BATES Street, Building & Veranda Lines of July 27, 1953 Vol. 8-32

BATES PLACE Street, Building & Veranda Lines of March 24, 1956 Vol. 8-32

CITY TOWN

OF

HARTFORD WETHERSFIELD

City of Hartford Department of Engineering