
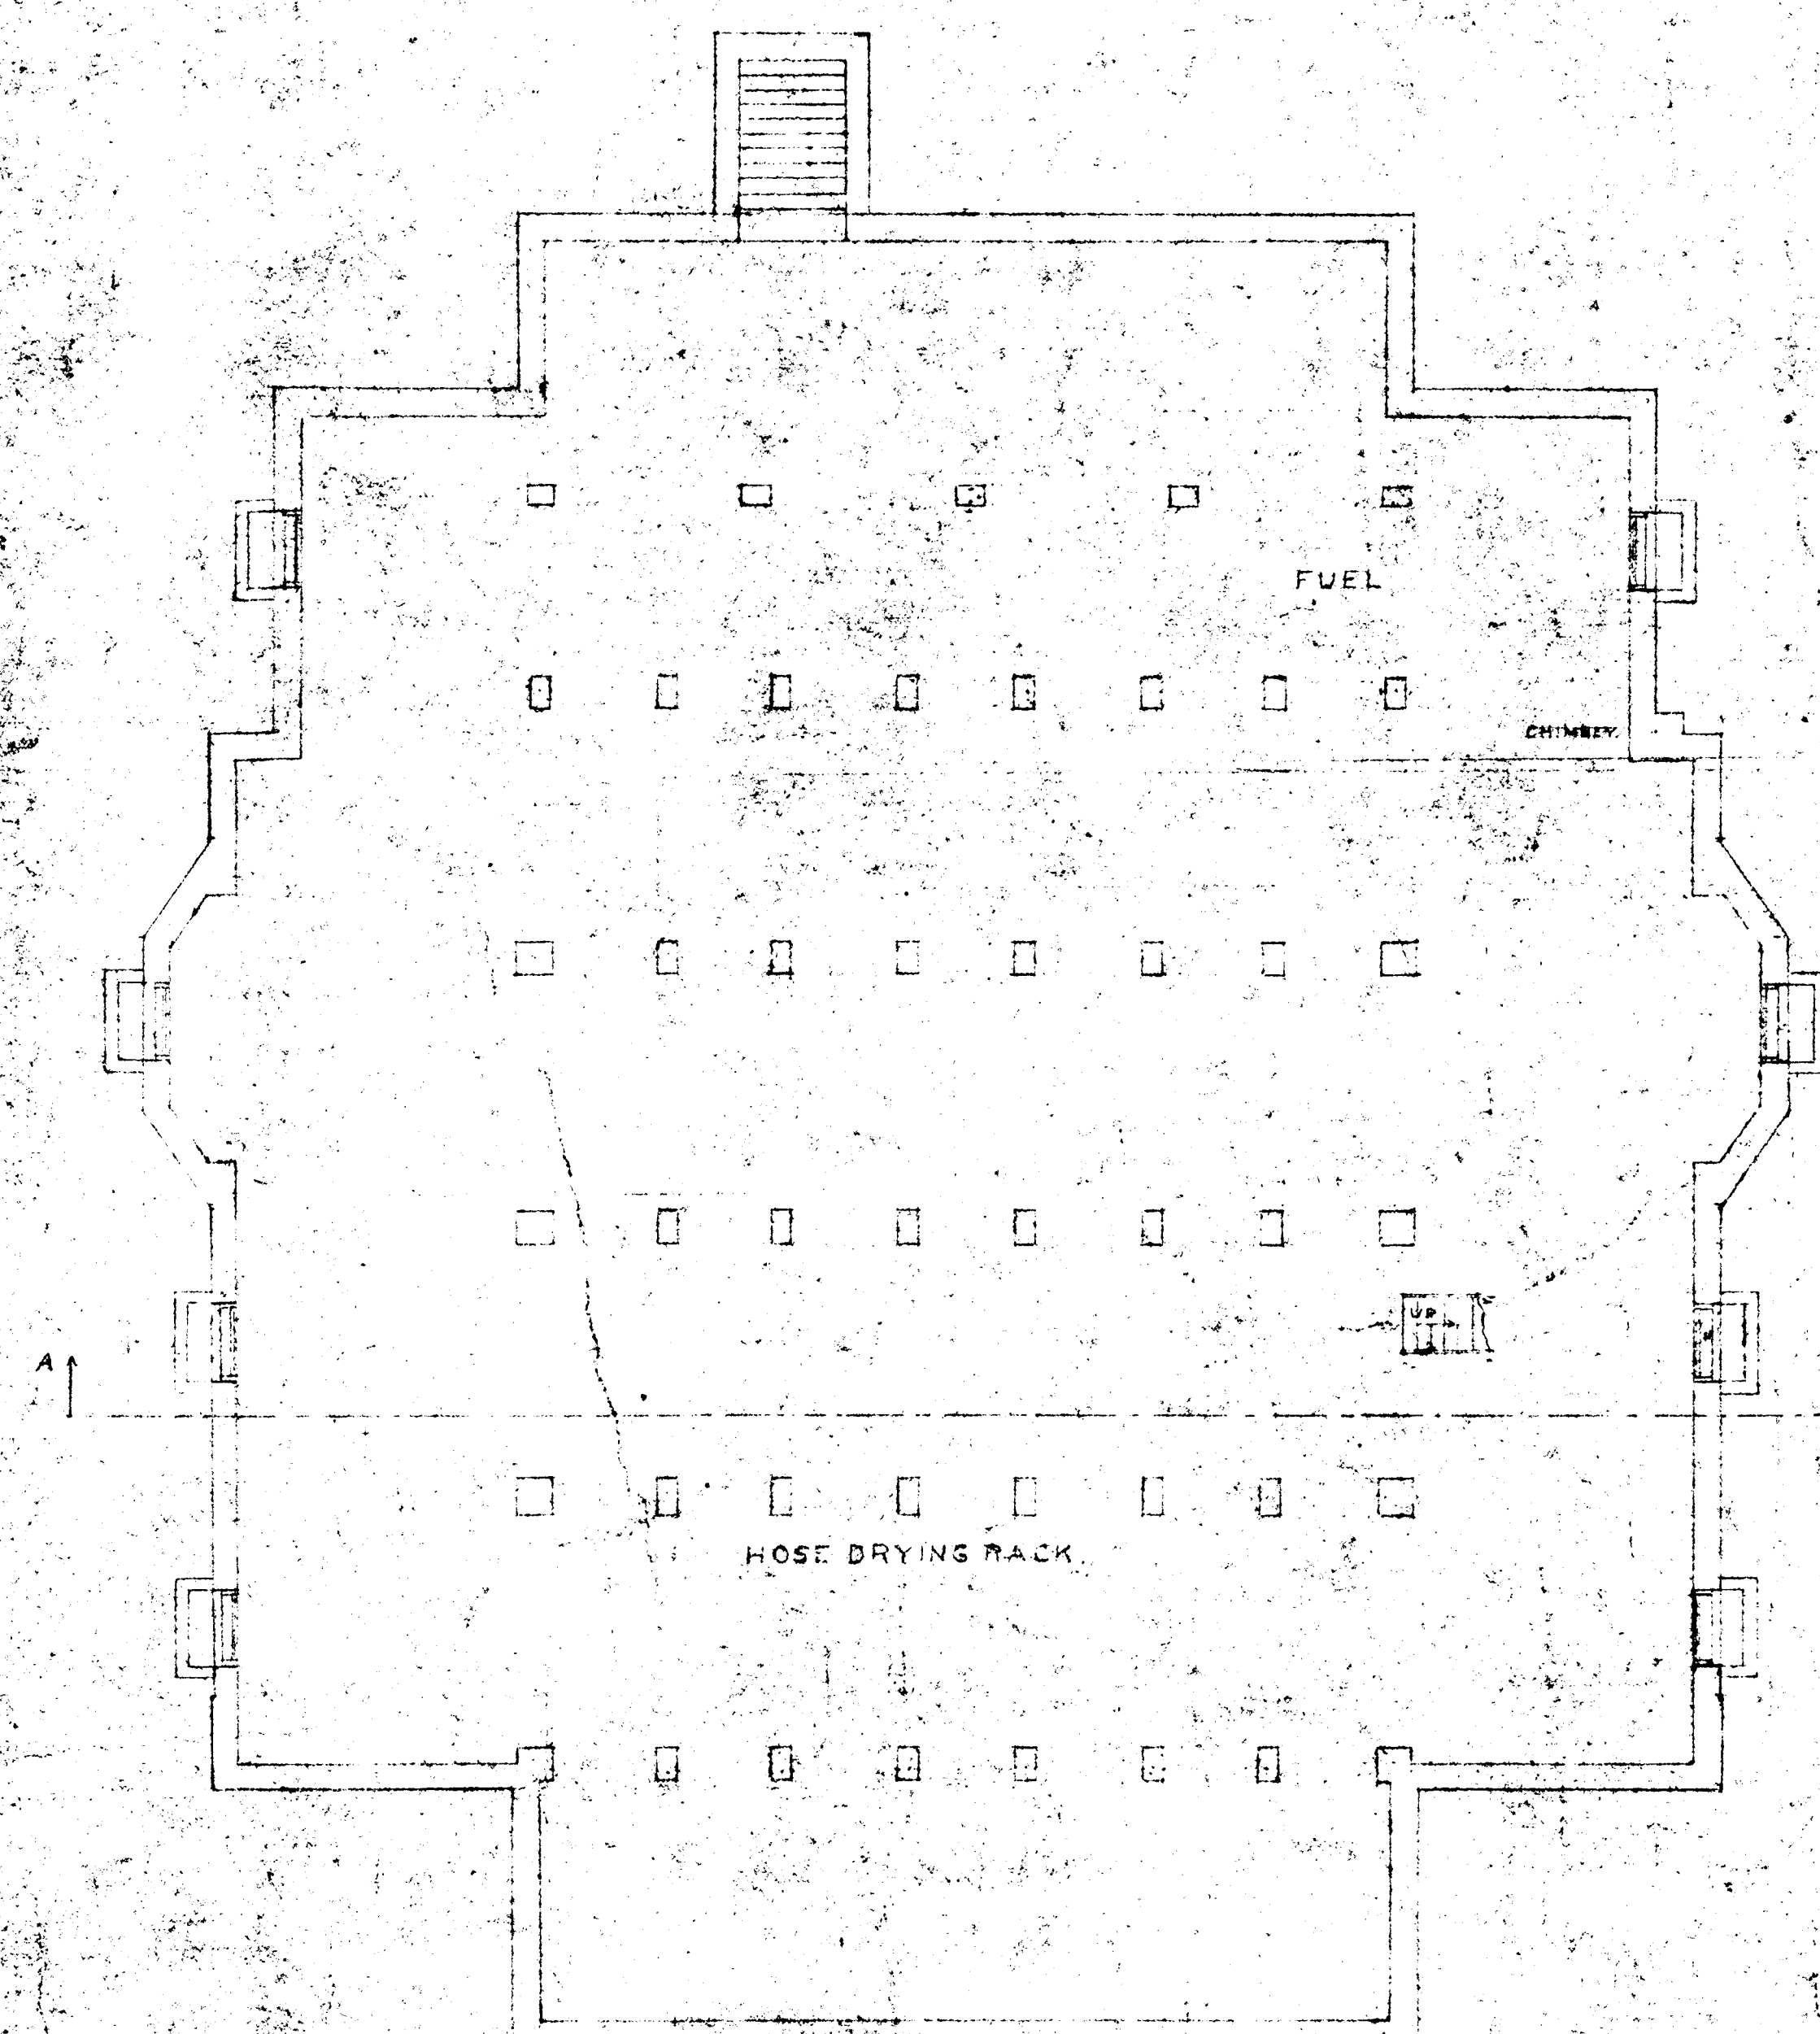
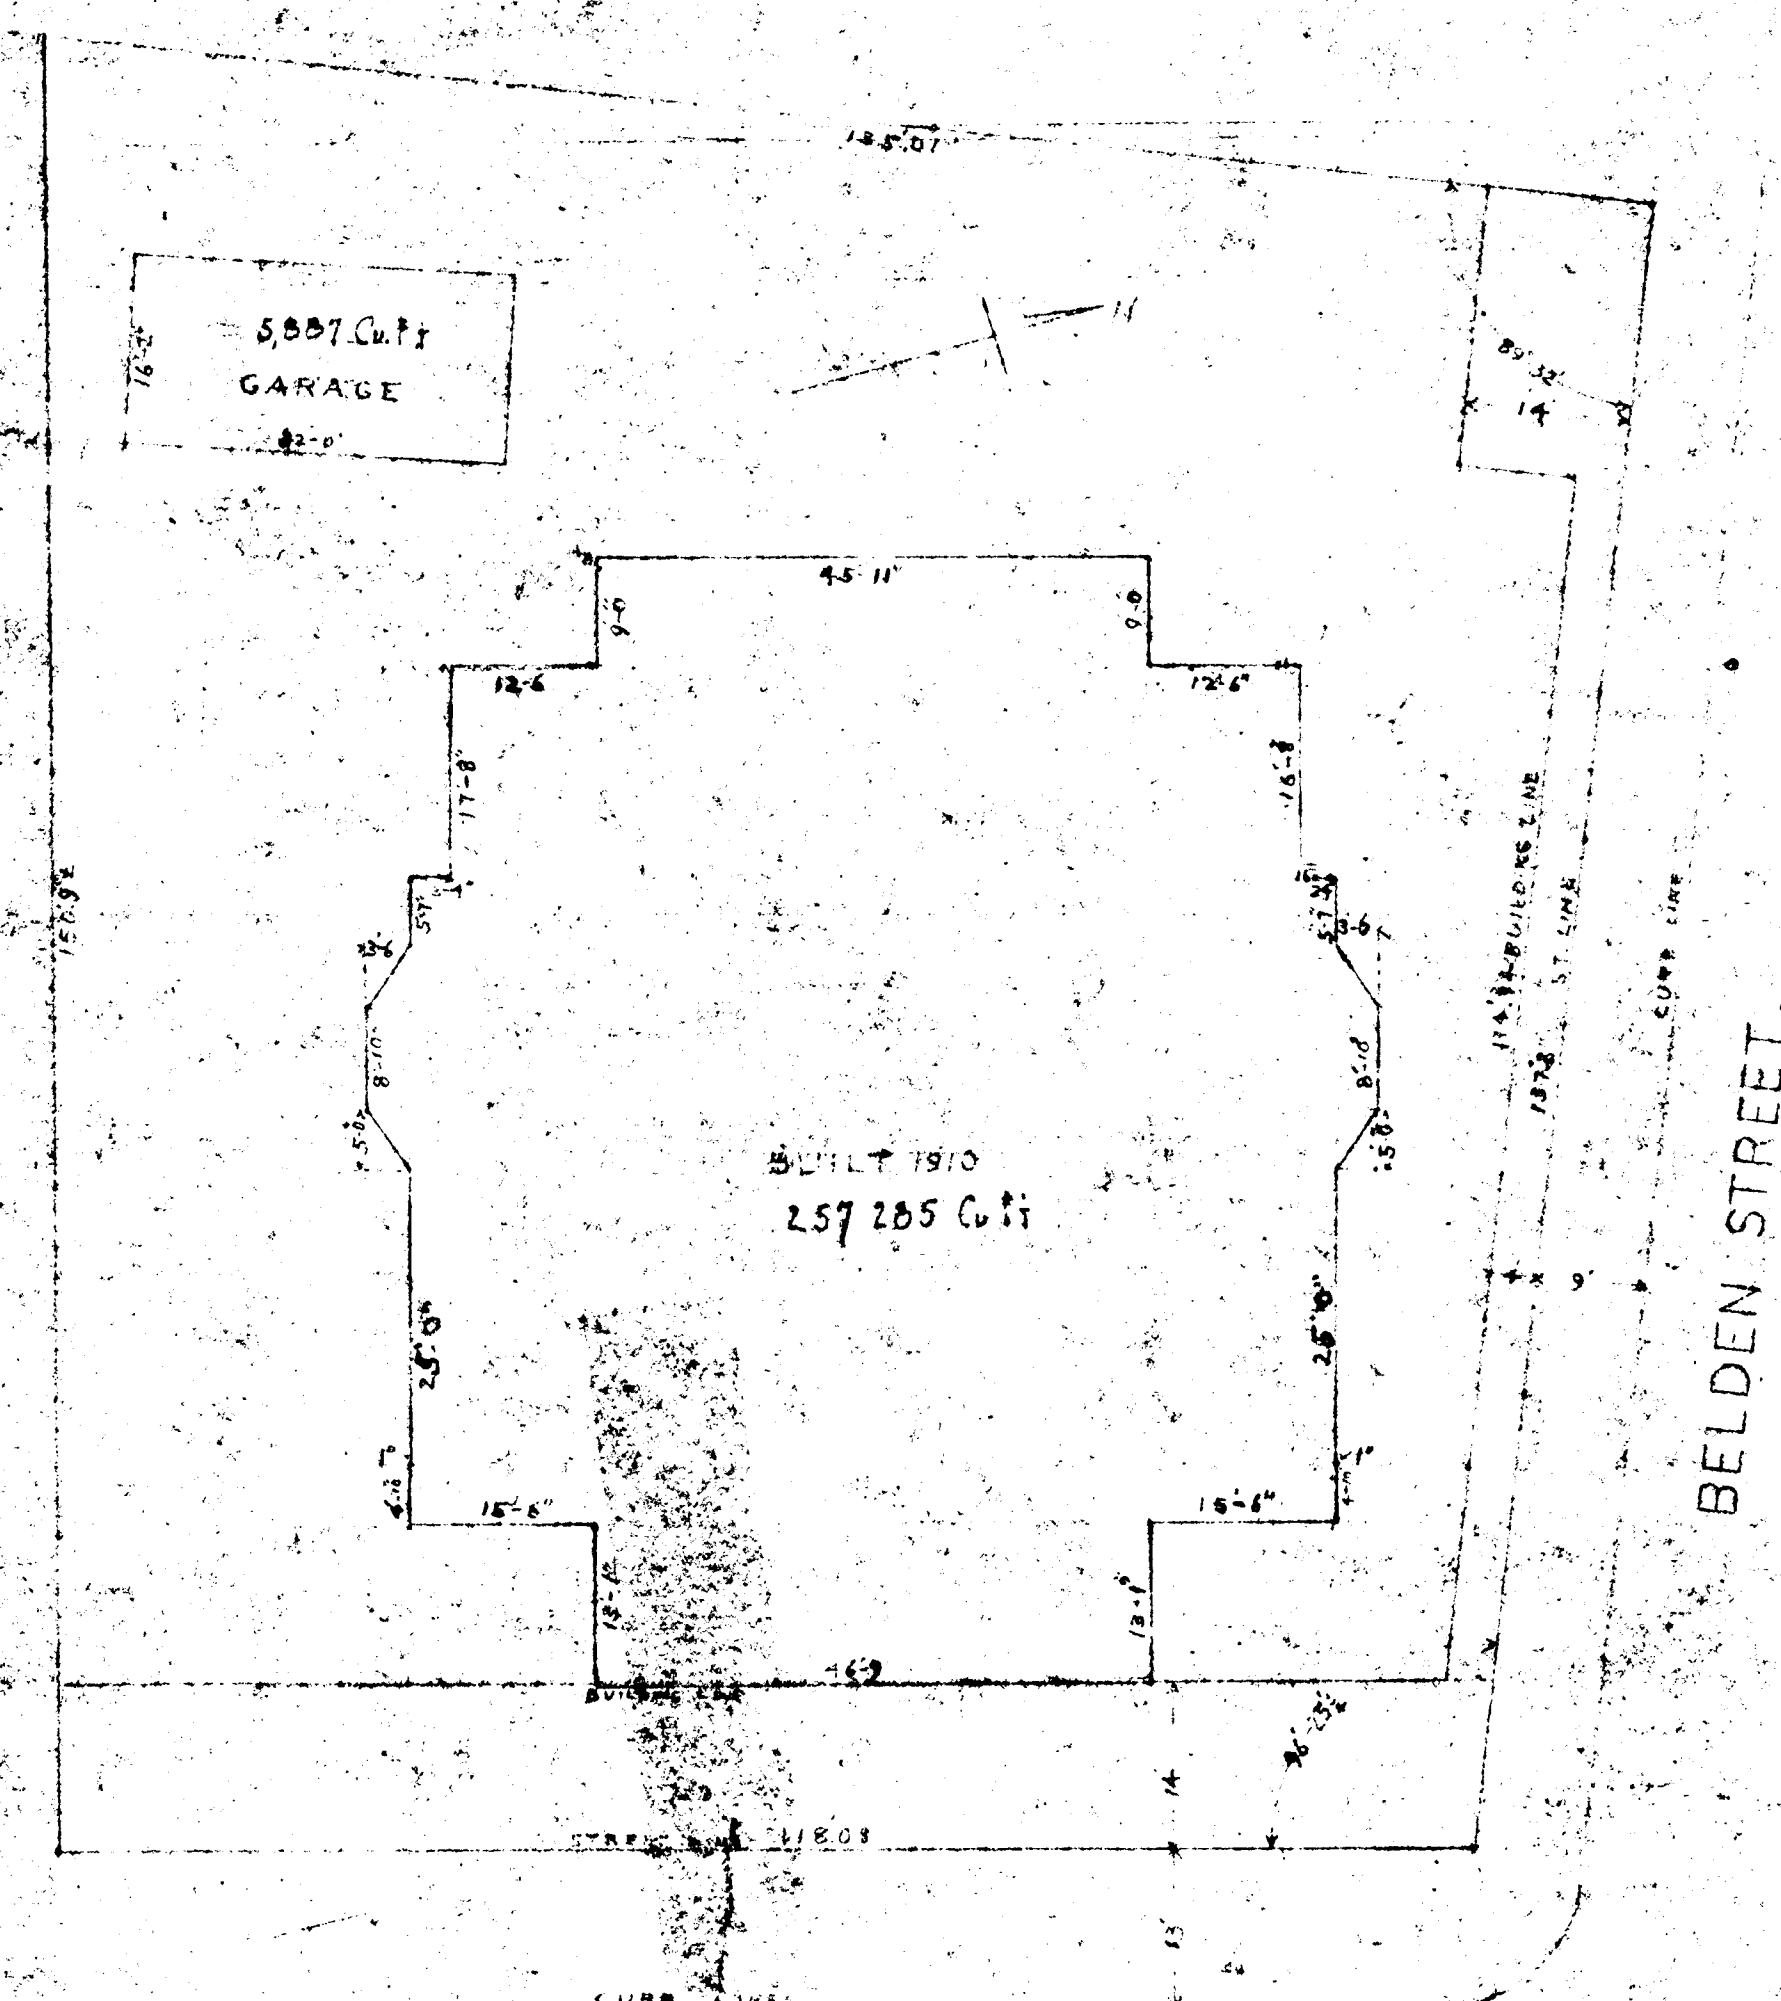


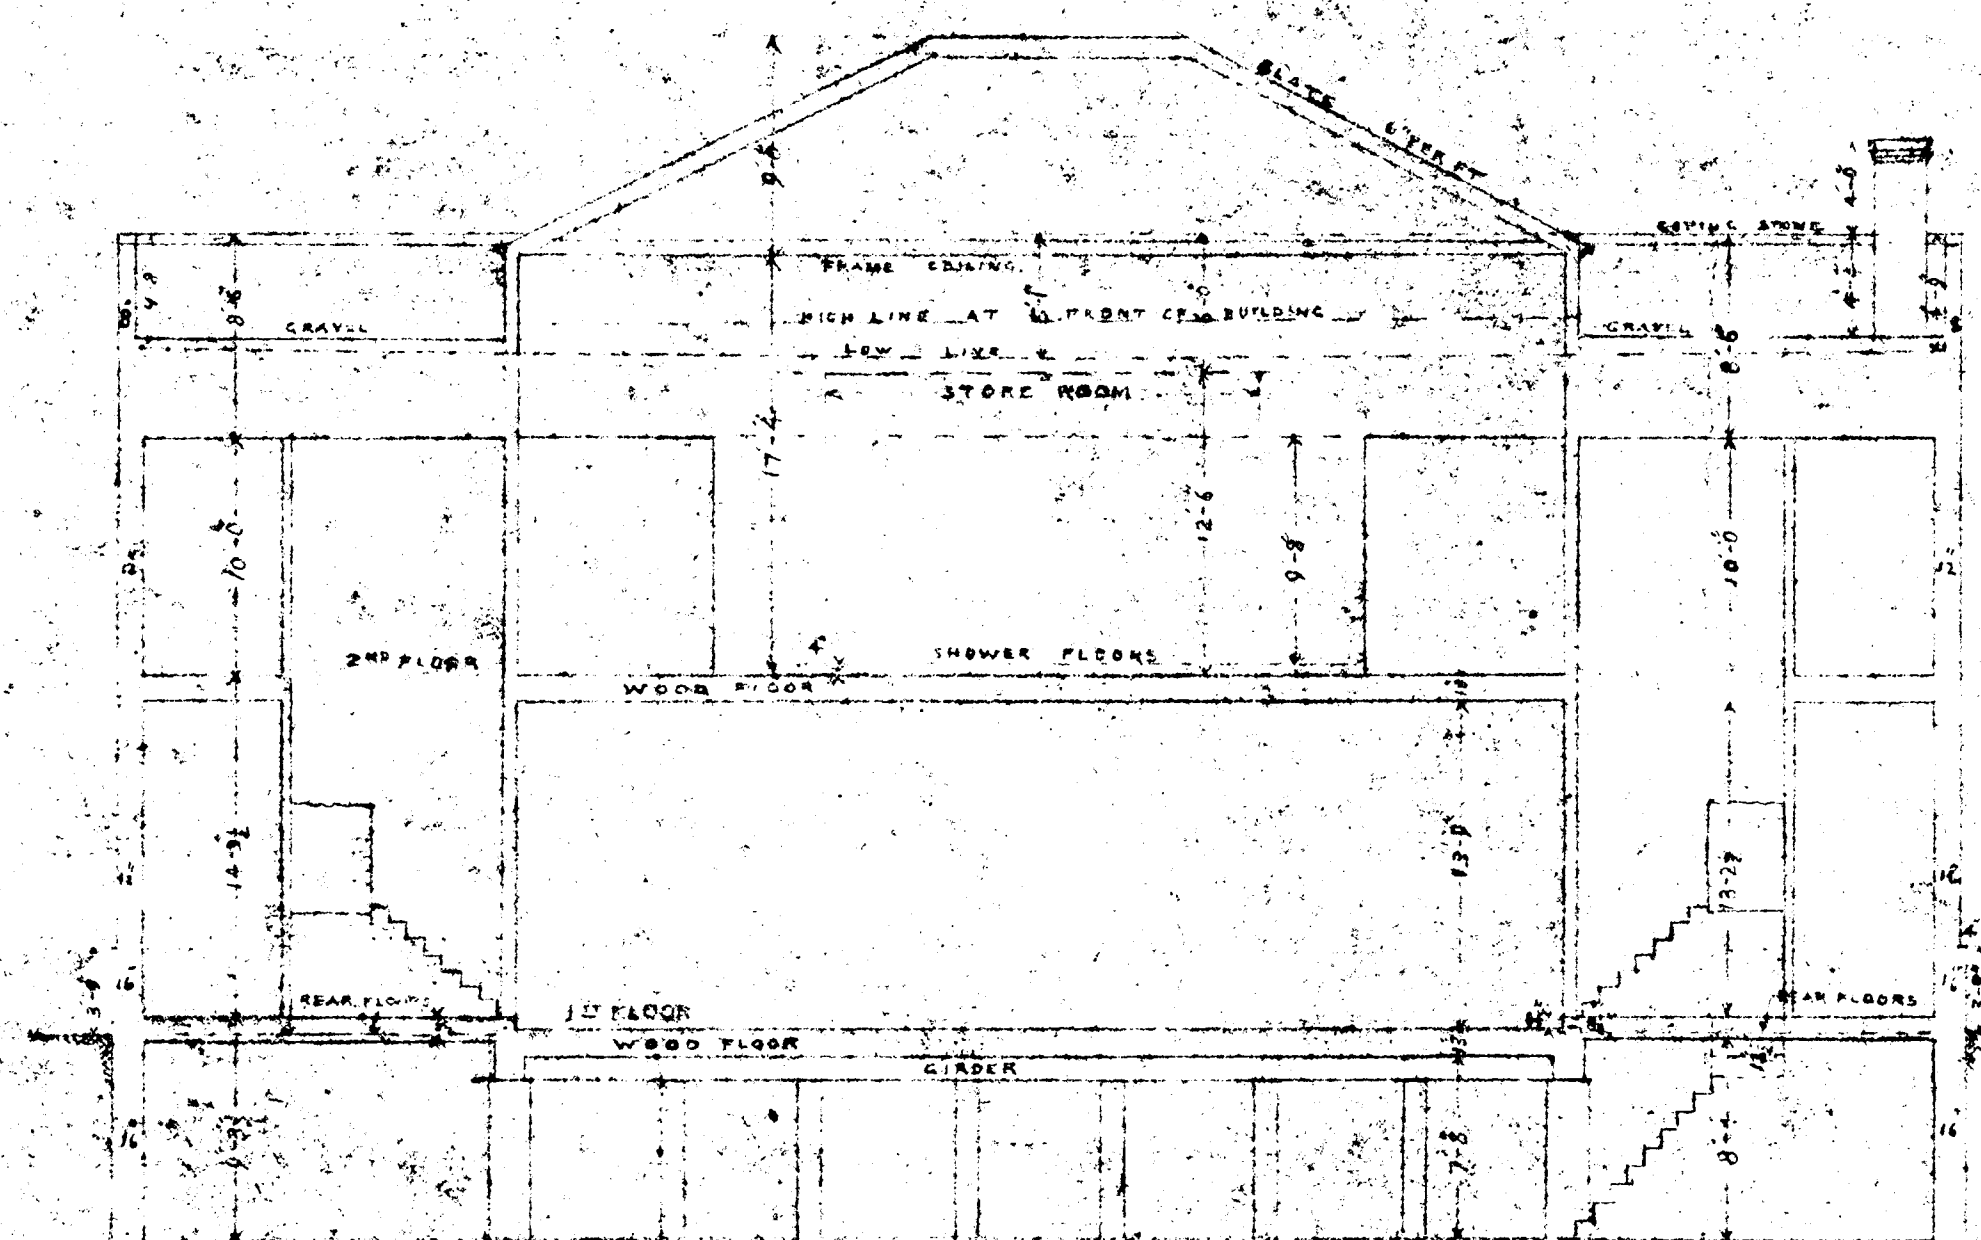

172M D-2

ENGINE HOUSE: N-2

1515 MAIN STREET

Date 6-13-34 Scale 1/8 in = 1 ft Drawn by J.S.

Area of site 30-214' Total floor area 14,458'

Area of building in ground level 11503'

Percentage of site occupied by building 39.0%

Subs. feet in building 263 ft 2