


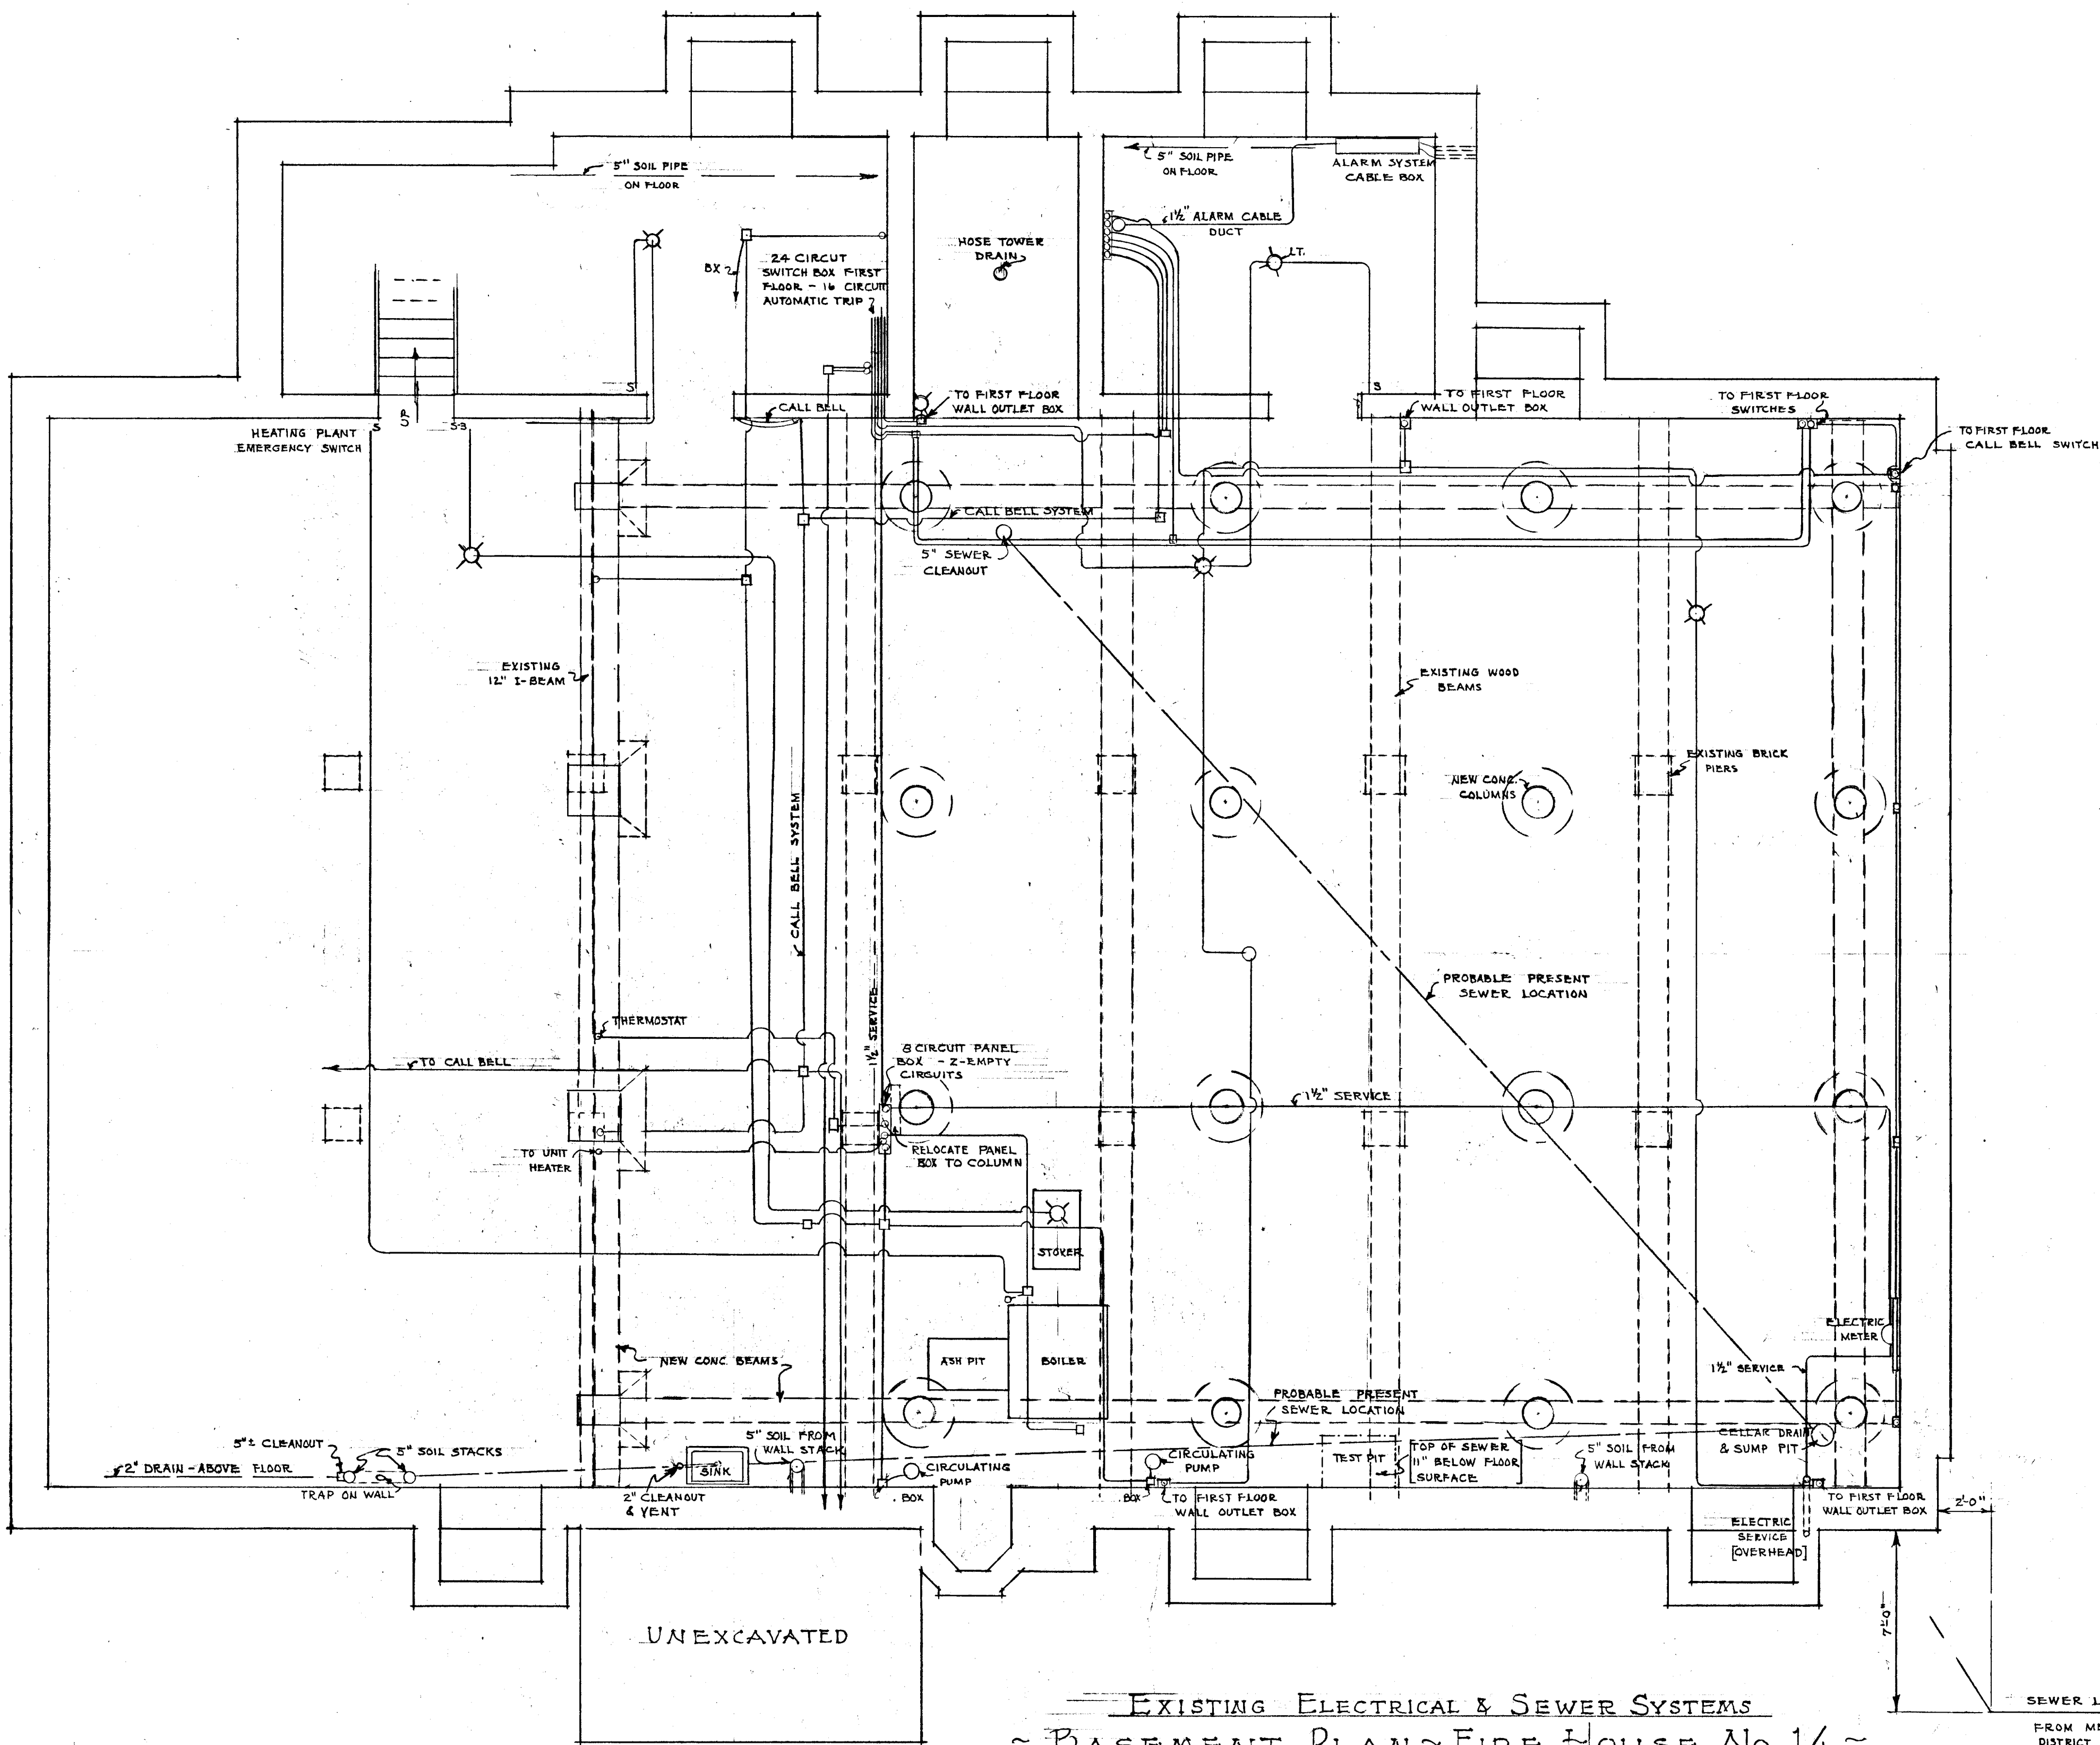

EXISTING ELECTRICAL & SEWER SYSTEMS
 ~ BASEMENT PLAN ~ FIRE HOUSE No. 14 ~
 25 BLUE HILLS AVE
 SCALE 1/4"=1'-0"

VERIFY EXISTING
 CONDITIONS AND
 DIMENSIONS AT
 BUILDING

SEWER LOCATION
 FROM METROPOLITAN
 DISTRICT RECORDS

CITY OF HARTFORD, CONNECTICUT
 DEPARTMENT OF ENGINEERING
 ~ FIRE HOUSE No. 14 ~
 No. 25 BLUE HILLS AVENUE
 NEW CONCRETE FLOORS & REED ALTERATIONS
 SCALE 1/4"=1'-0"

David J. Teller - Engineer
 Wm. J. W. Dwyer - Engineer

SHEET
 3
 OF 7 SHEETS
 DATE AUGUST 24, 1950