


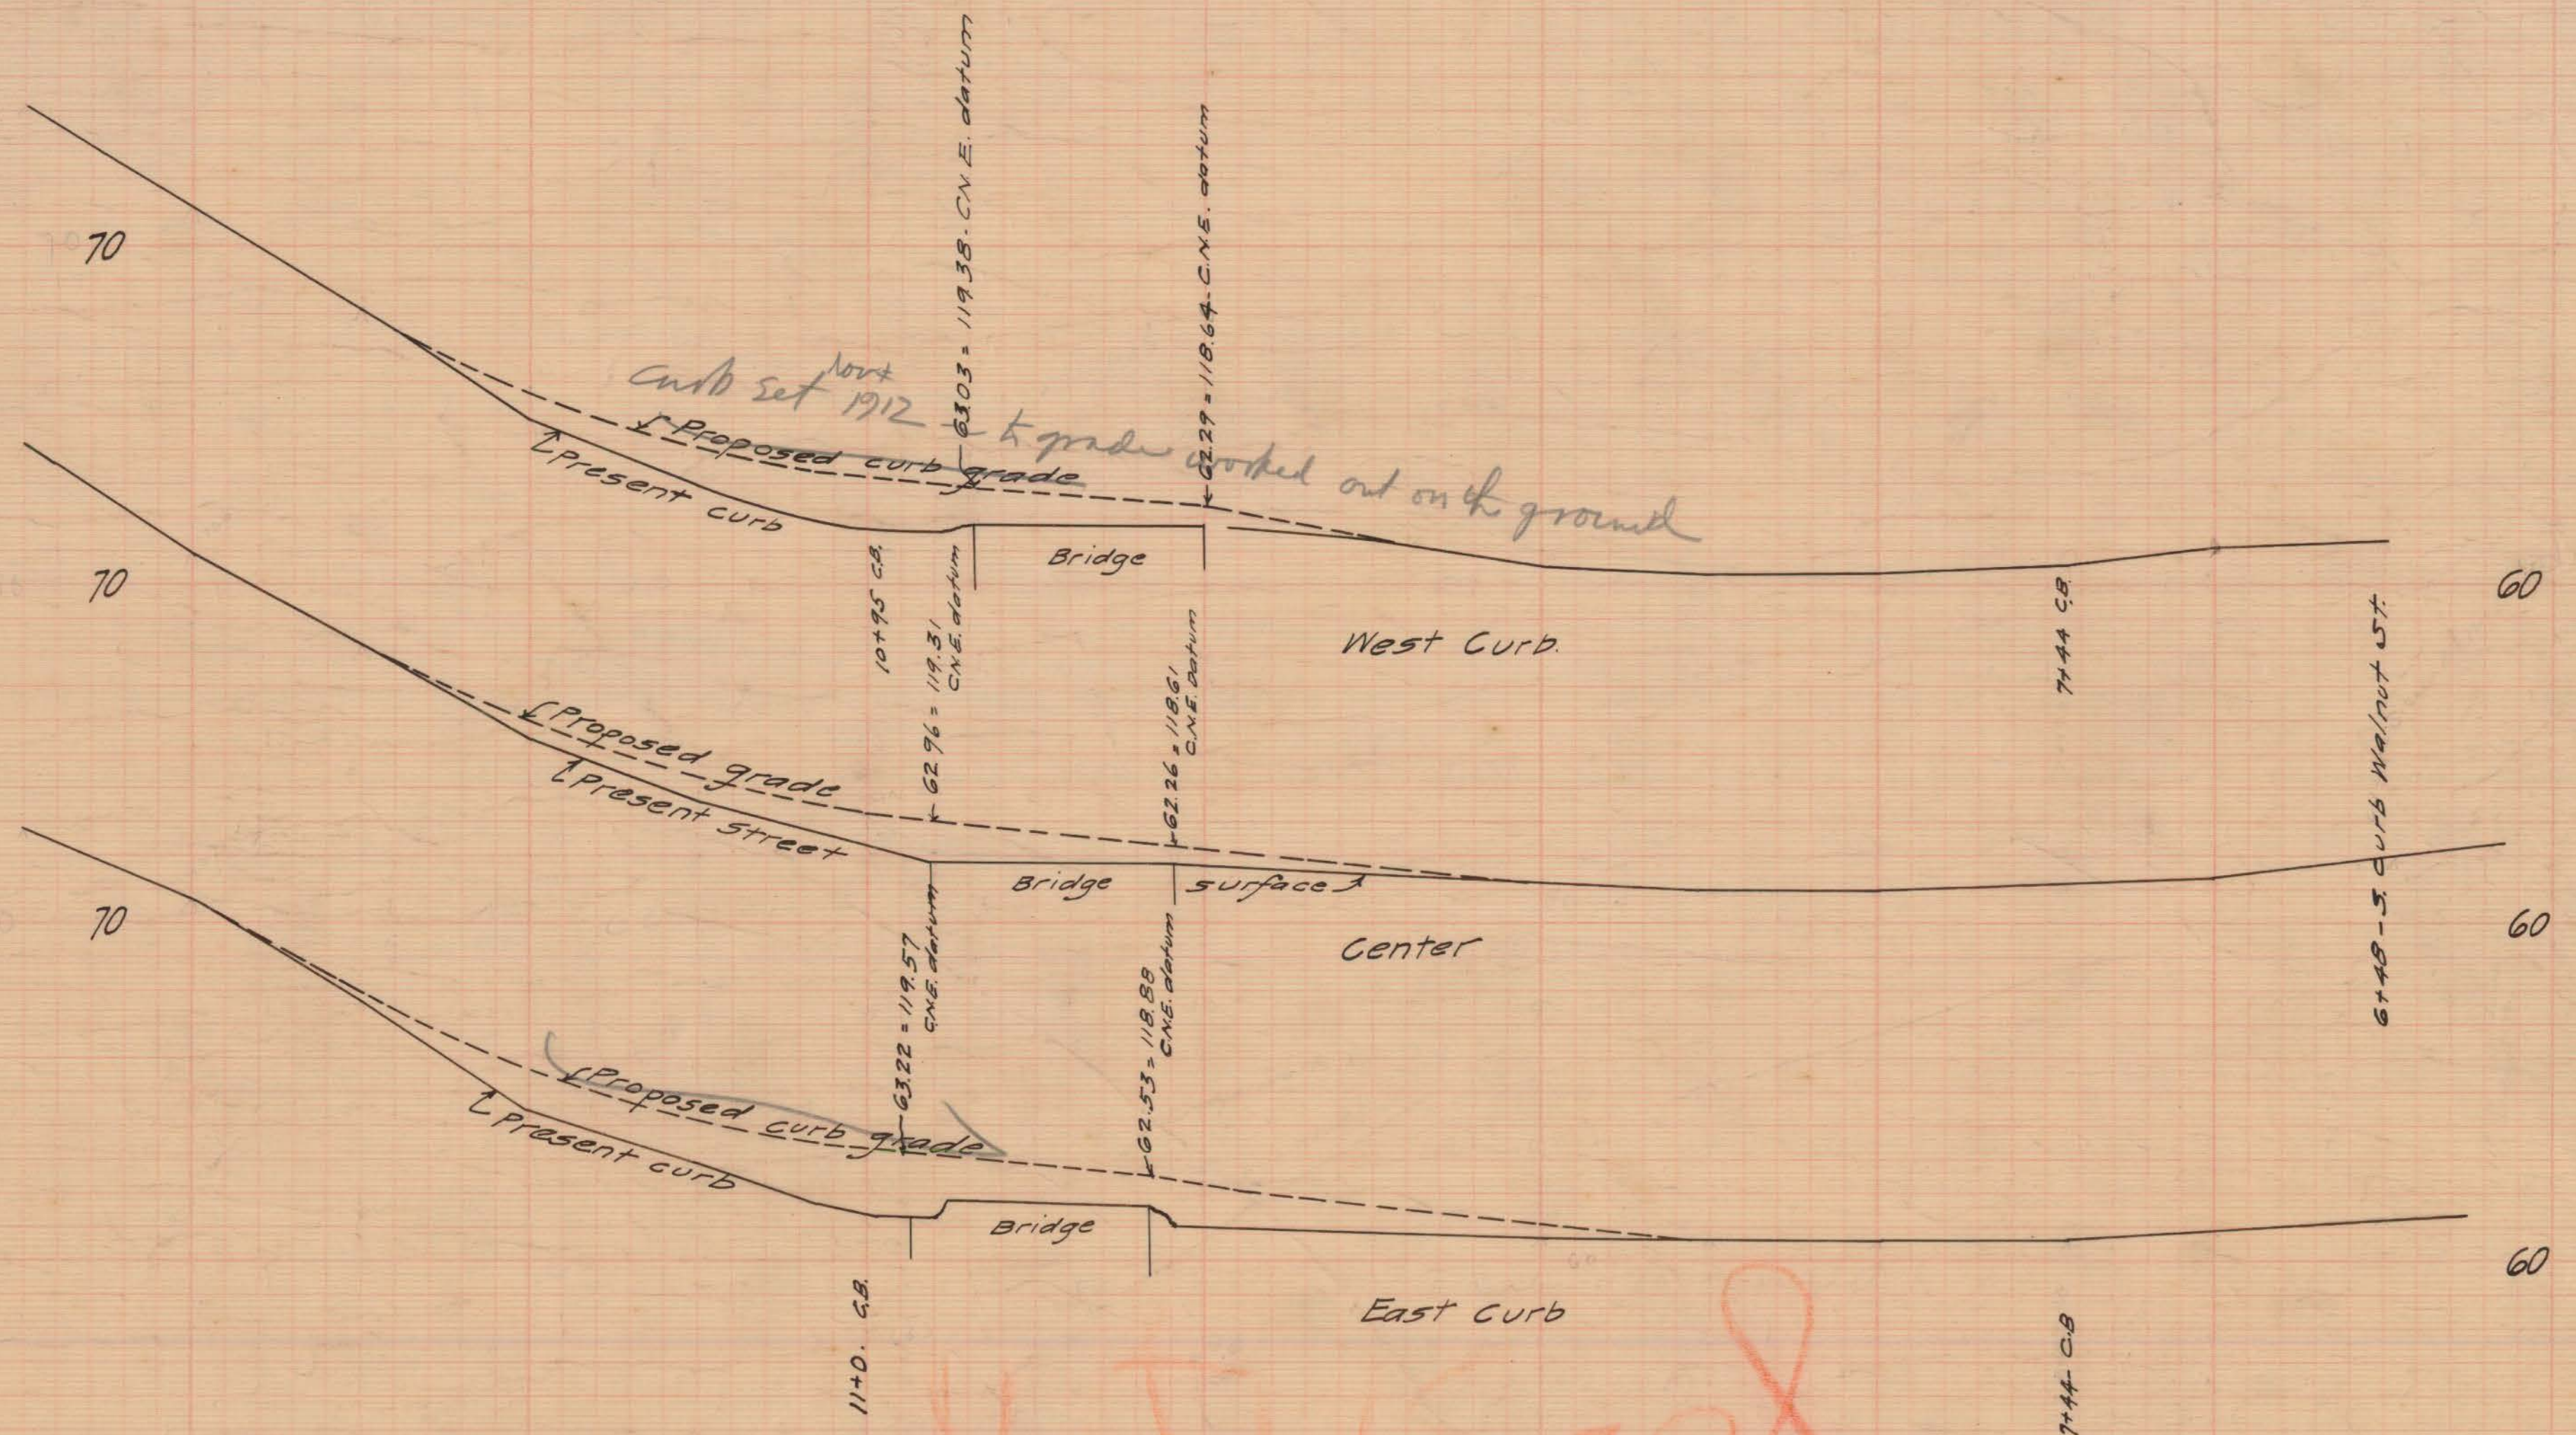

Note: Stations same as those on print of
C.N.E.R.R.
Elev. 0.0 on this profile (city datum)
= elev. 56.35 C.N.E. datum.

Not Used

City of Hartford.
Department of Engineering
Profile of Edwards Street
Dec 5 1911
Day Book No. 02781
Drawer 106 Sheet 3
200 23

Elev. 39.82 Top rail = 96.17 C.N.E. datum

14 13 12 11 10 9 8 7 6