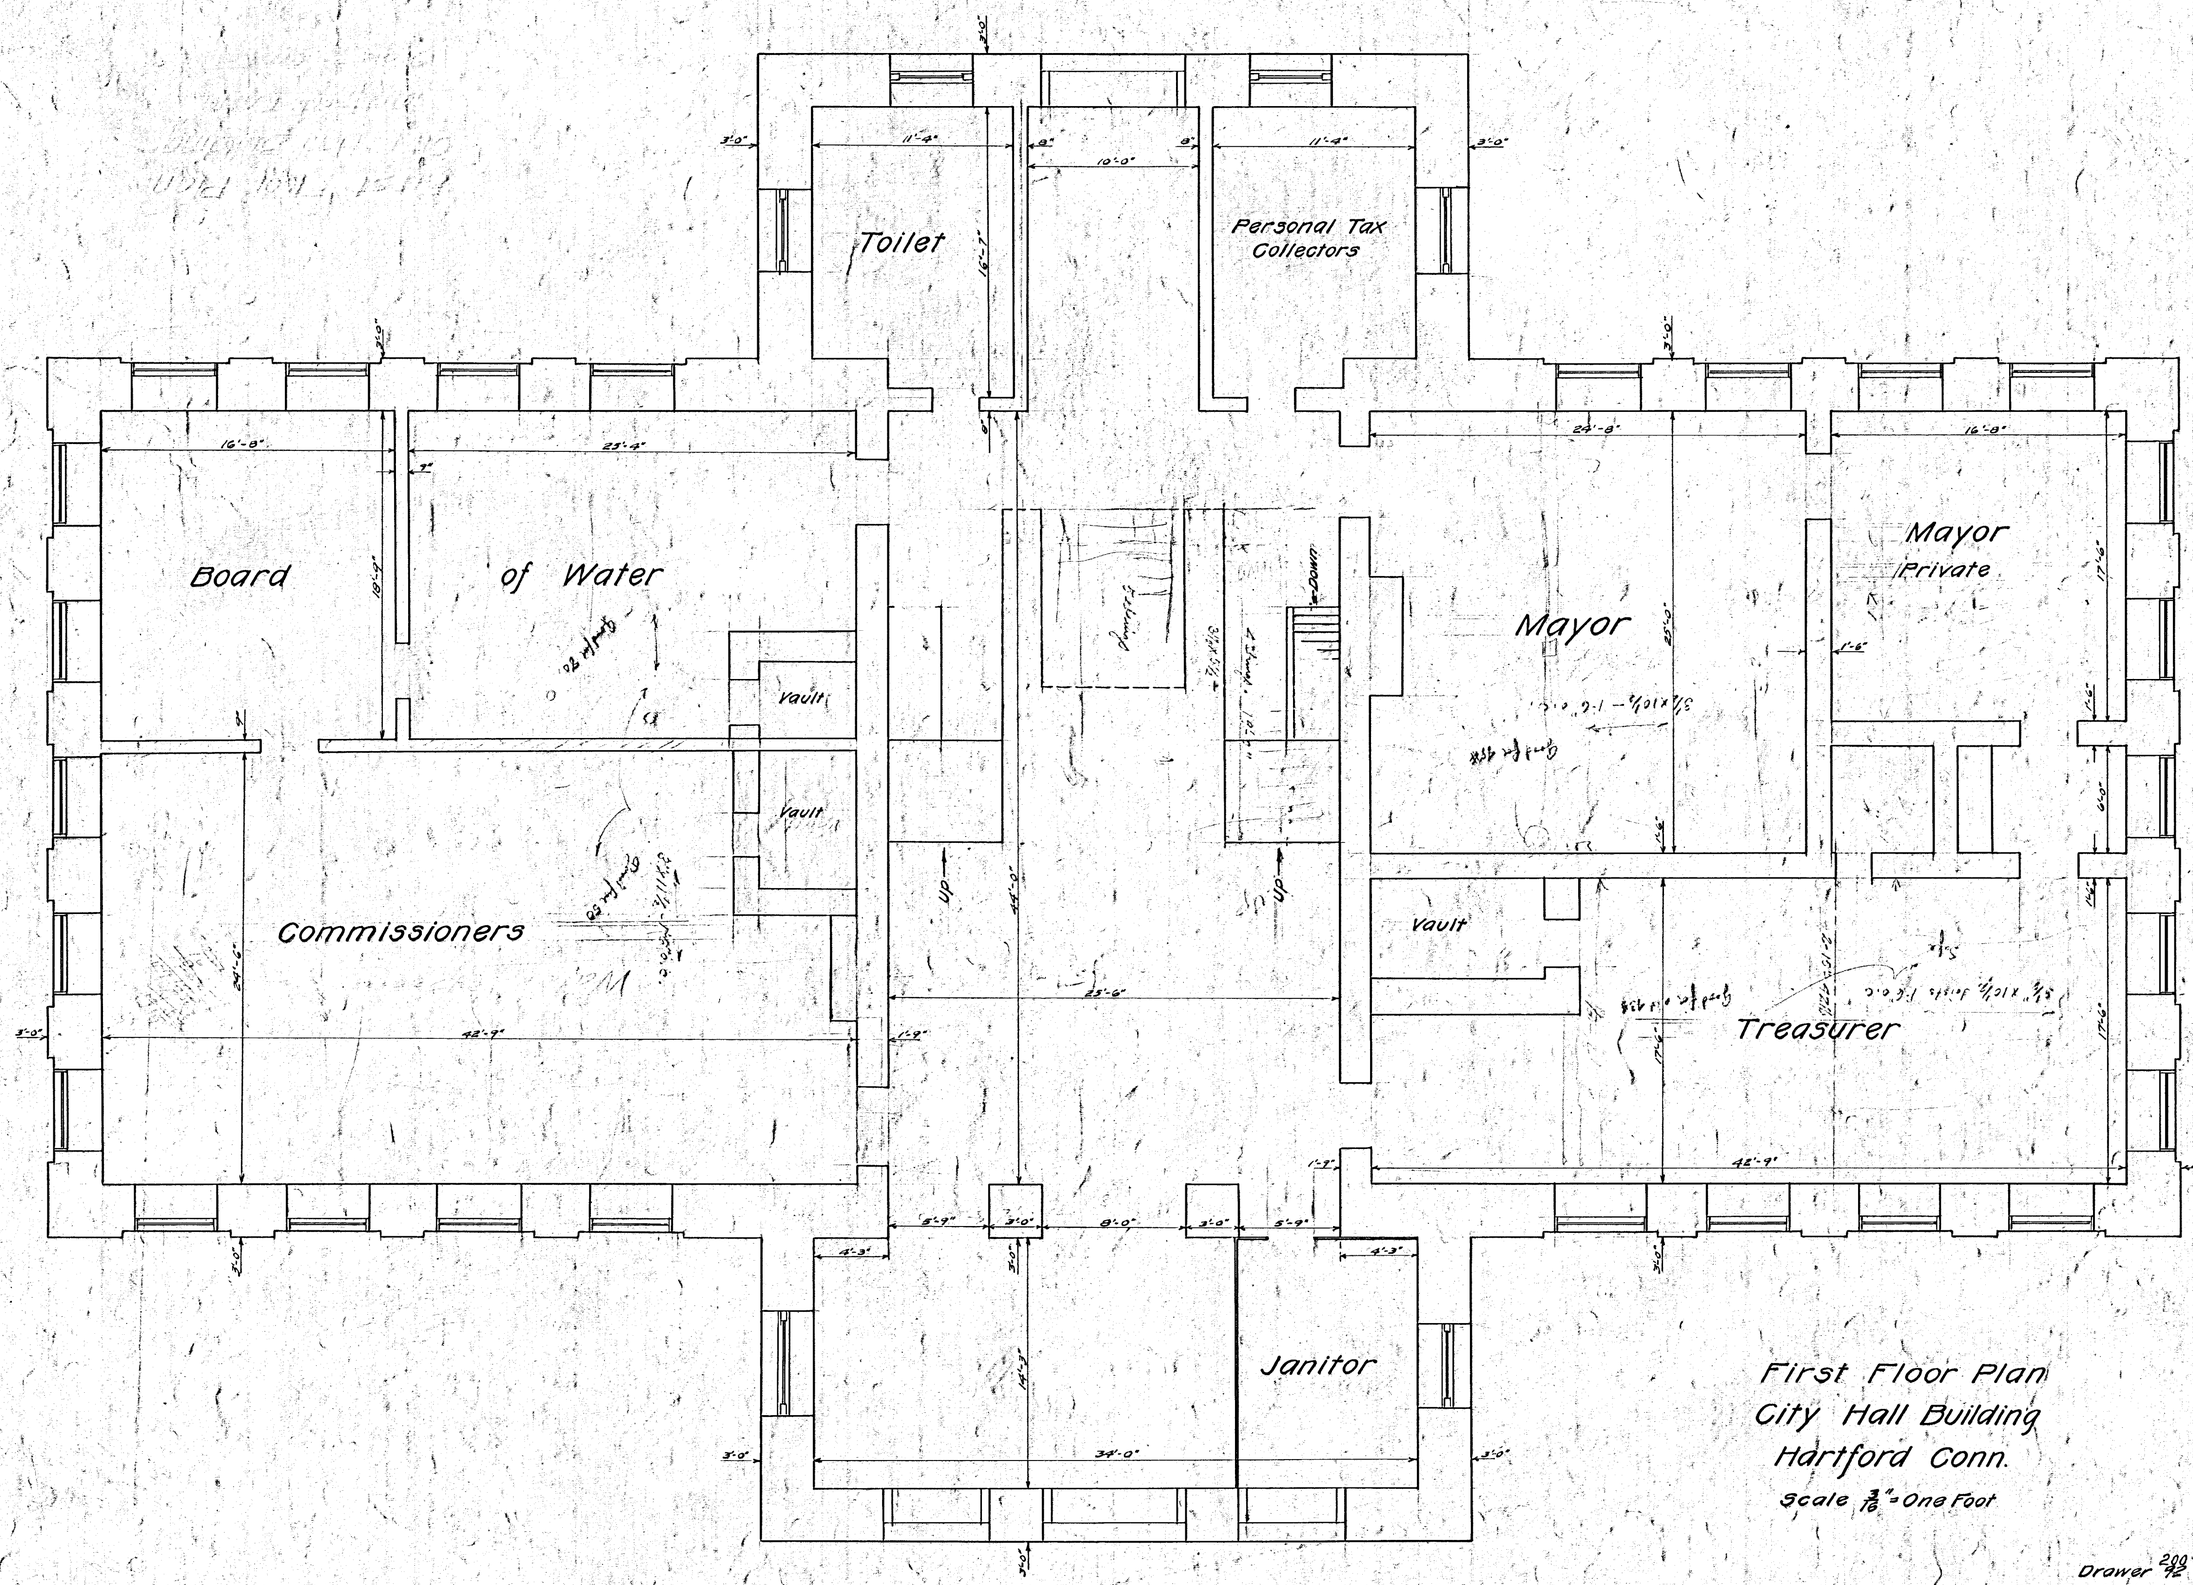

First Floor Plan
City Hall Building
Hartford Conn.
Scale 3/16" = One Foot

Drawer 200/12 Sheet 27/24
Day Book No. 03879 Jan. 1916

Department of Engineering
Hartford Conn.