


58
500

58
500

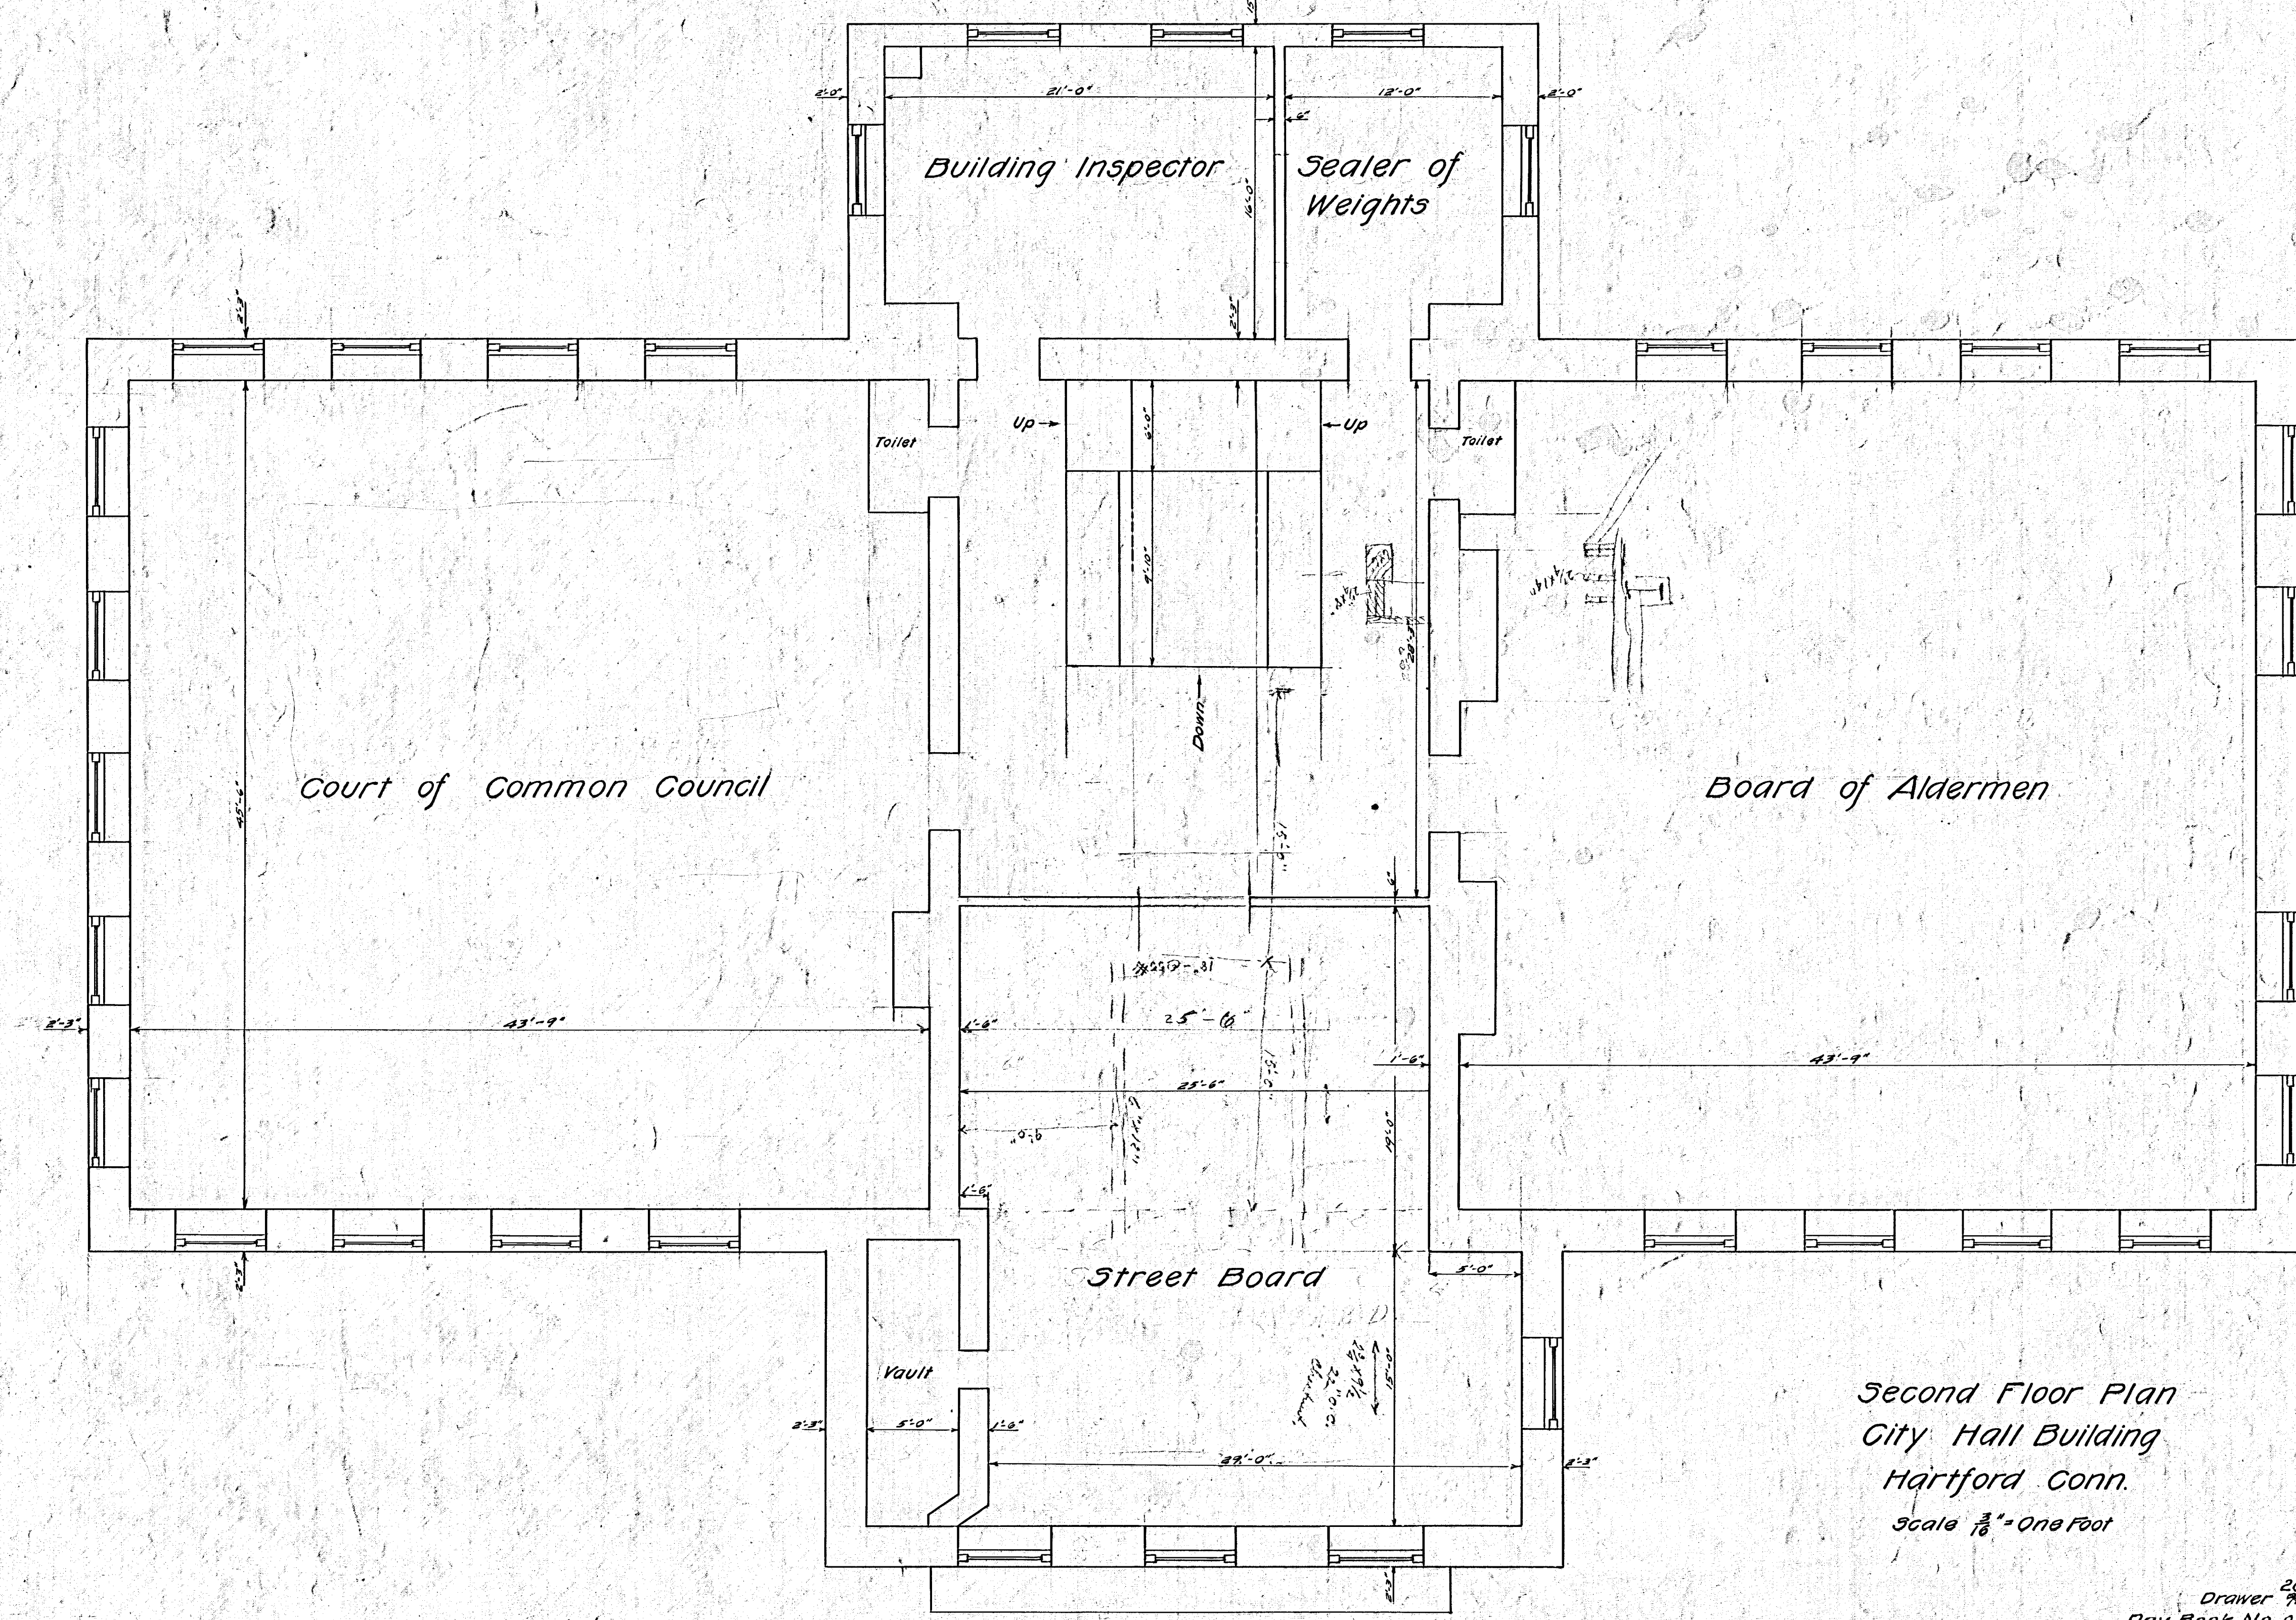

Second Floor Plan
City Hall Building
Hartford Conn.
Scale $\frac{3}{16}'' = \text{One Foot}$

58
500

58
500