


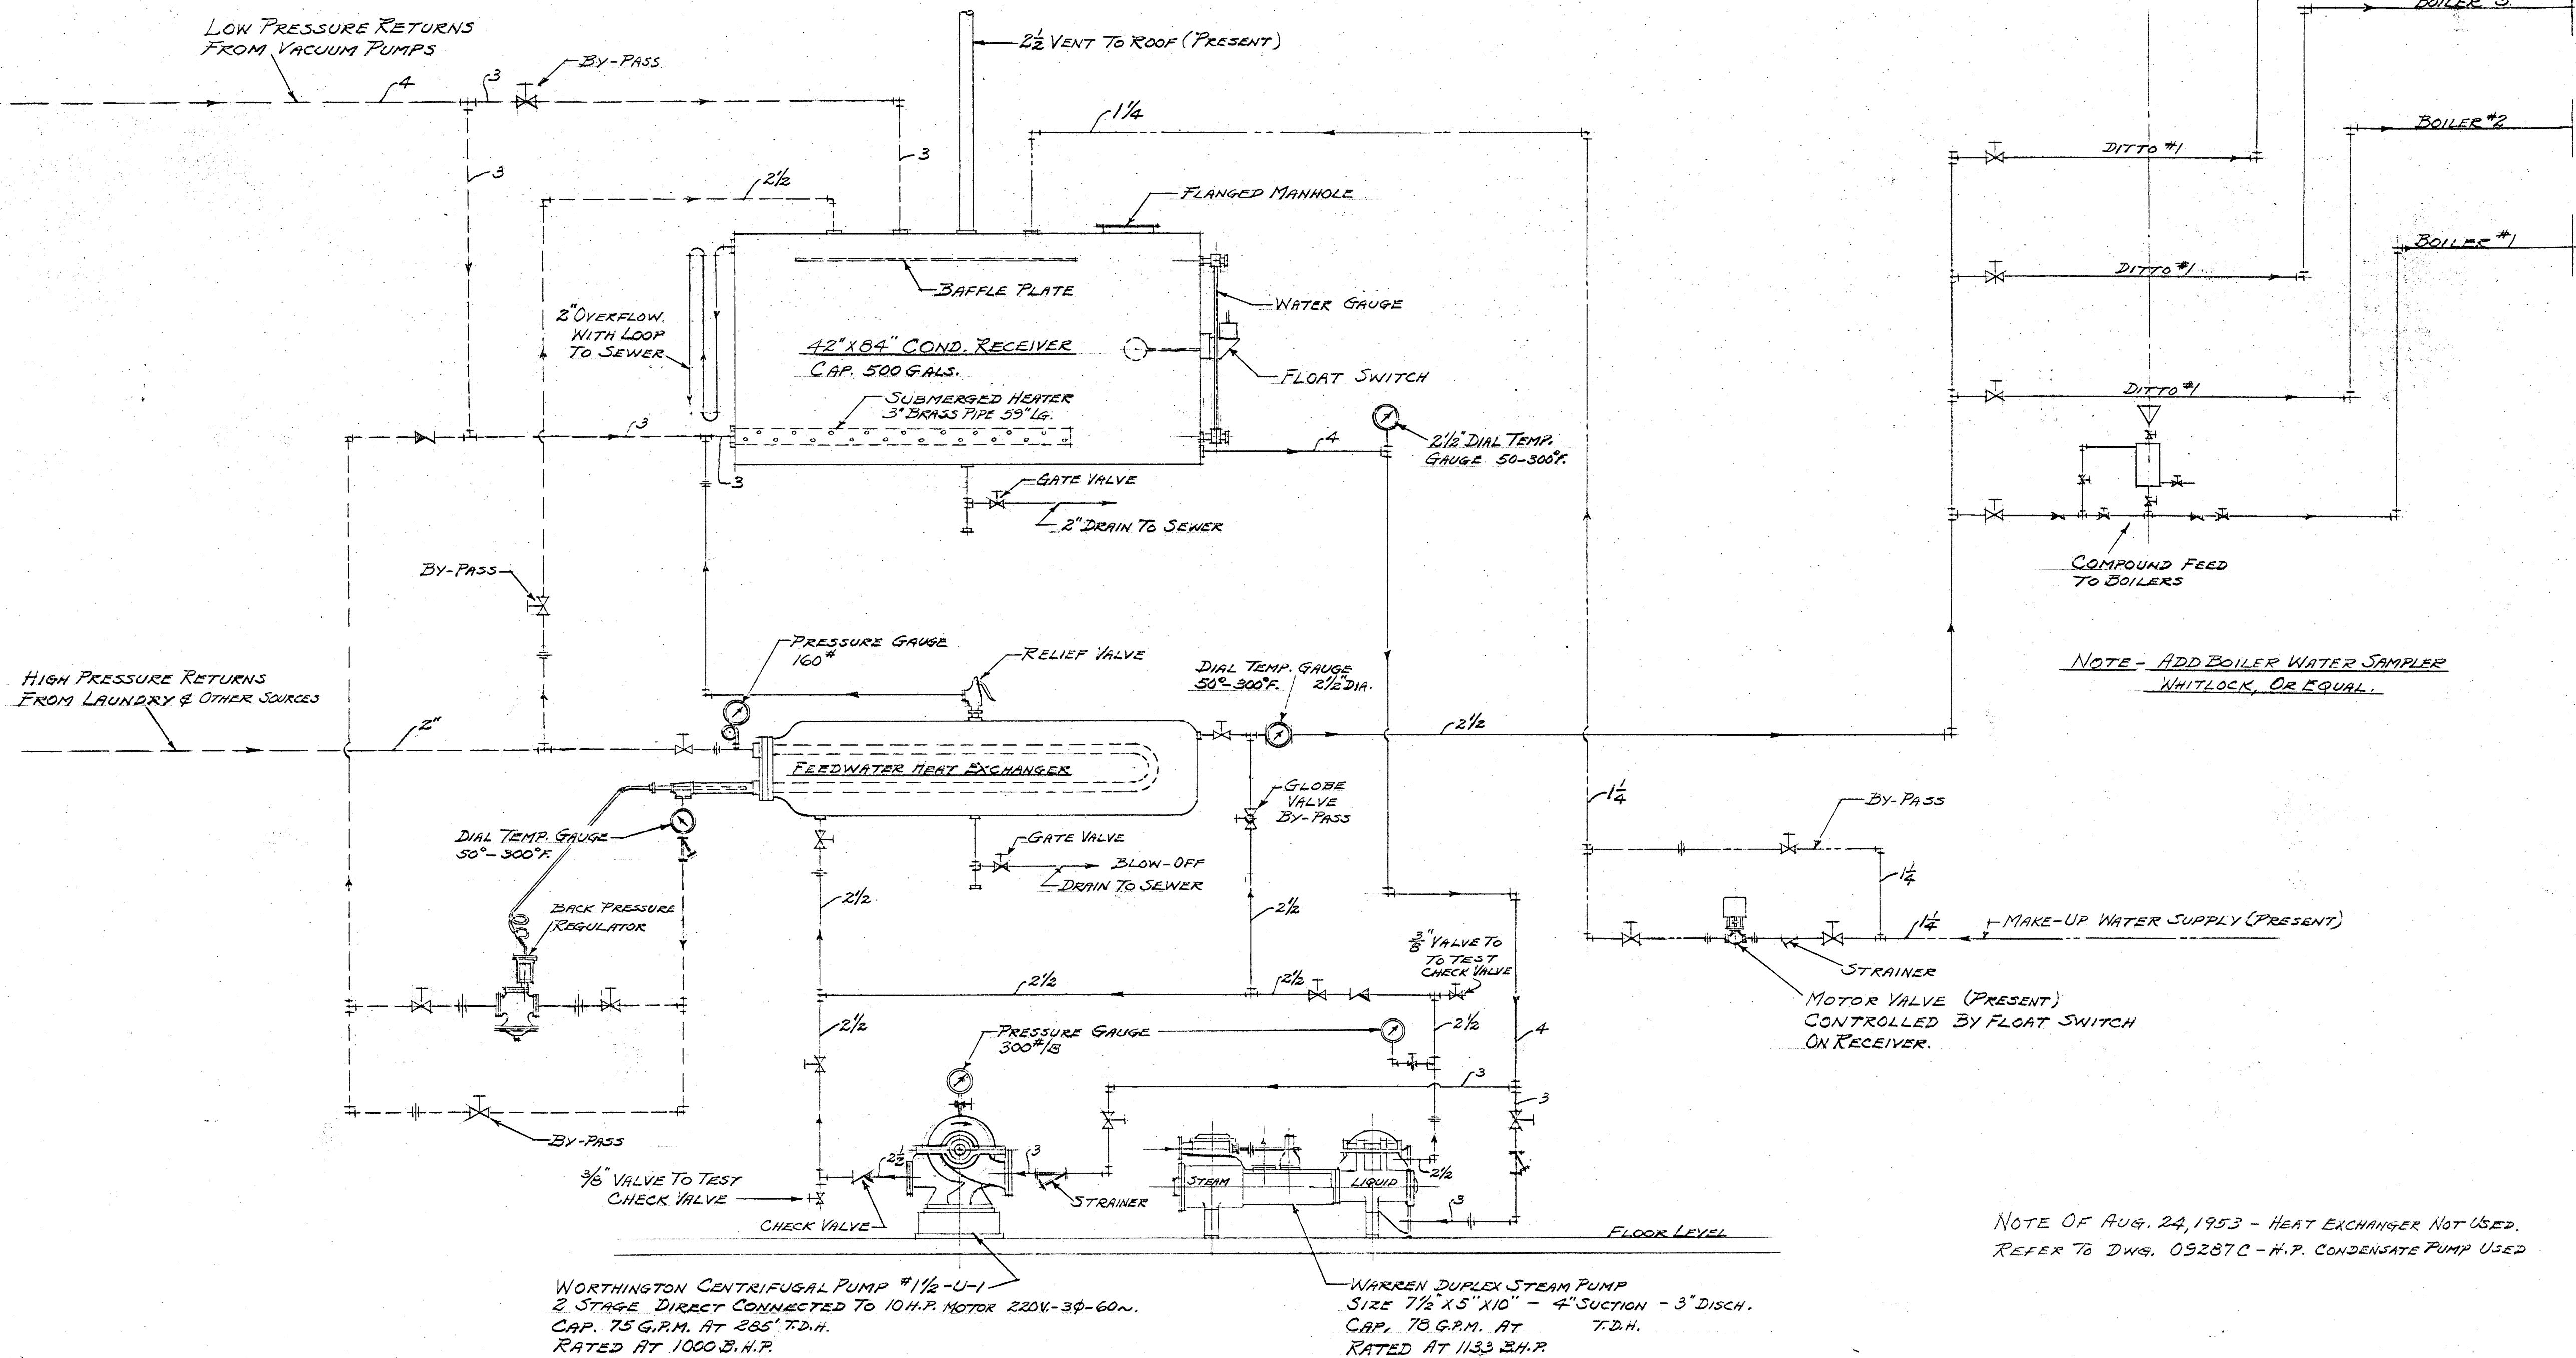

NOTE OF AUG. 24, 1953 - HEAT EXCHANGER NOT USED.
REFER TO DWG. 09287C - H.P. CONDENSATE PUMP USED

VERIFY EXISTING
CONDITIONS AND
DIMENSIONS AT
BUILDING

No. 3 OF 3 SHEETS		
CITY OF HARTFORD, CONNECTICUT DEPARTMENT OF ENGINEERING		
BOILER FEED PUMP AND CONDENSATE RECEIVER		
HEAT RECLAIM DIAGRAM		
JOHN J. MCCOOK MEMORIAL HOSPITAL 2 HOLCOMB STREET		
DESIGNED BY <i>Daniel J. Farrell</i>	DRAWN BY <i>B. J. J.</i>	CHECKED BY <i>W. J. J.</i>
DATE OCT. 26, 1951	DAYBOOK NO. 09171-C	