


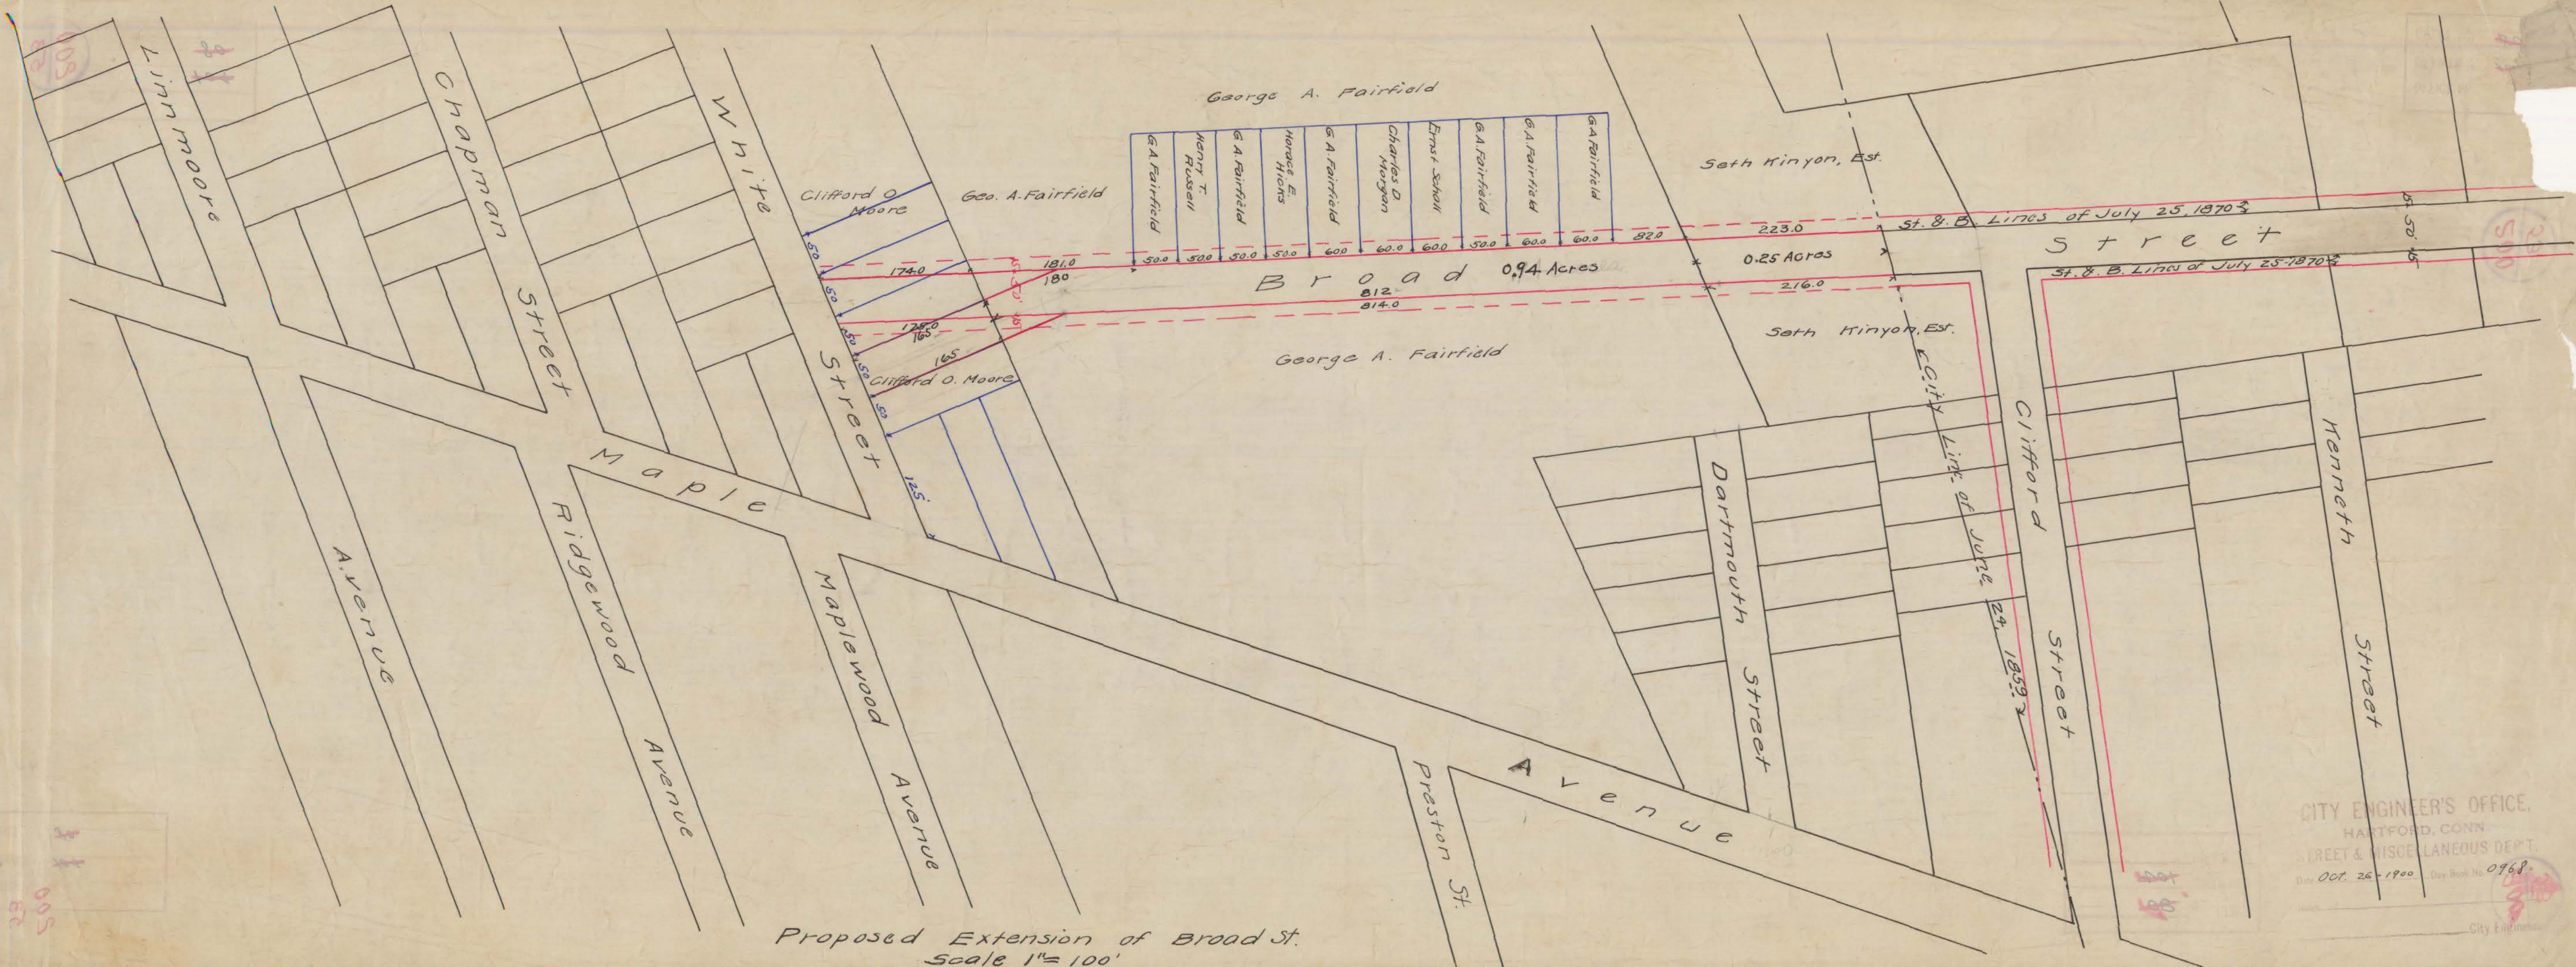

Proposed Extension of Broad St.  
Scale 1" = 100'

CITY ENGINEER'S OFFICE,  
HARTFORD, CONN.  
STREET & MISCELLANEOUS DEPT.  
Date OCT. 26 - 1900 Day Book No. 0968.  
City Engineer