



SHEET 88
 DRAWN BY 108
 DATE 108

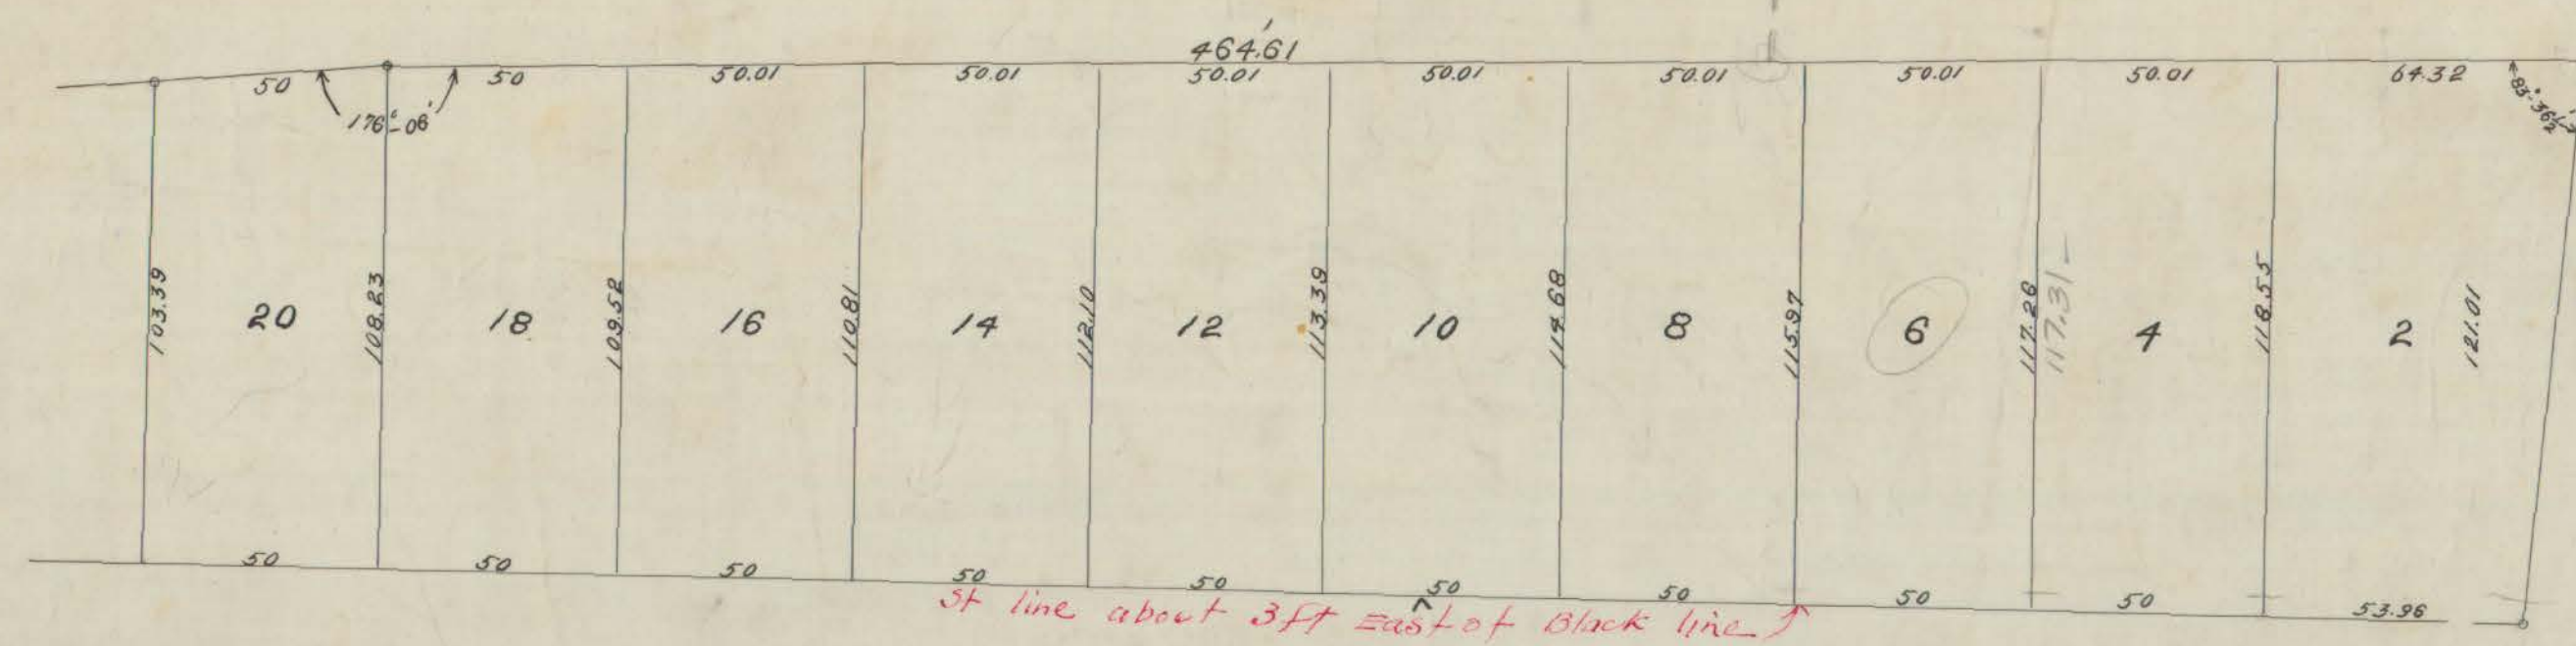

LENNOX

PLACE.

Note - Feb. 1910 - Present street line not as shown - none of these depths are right

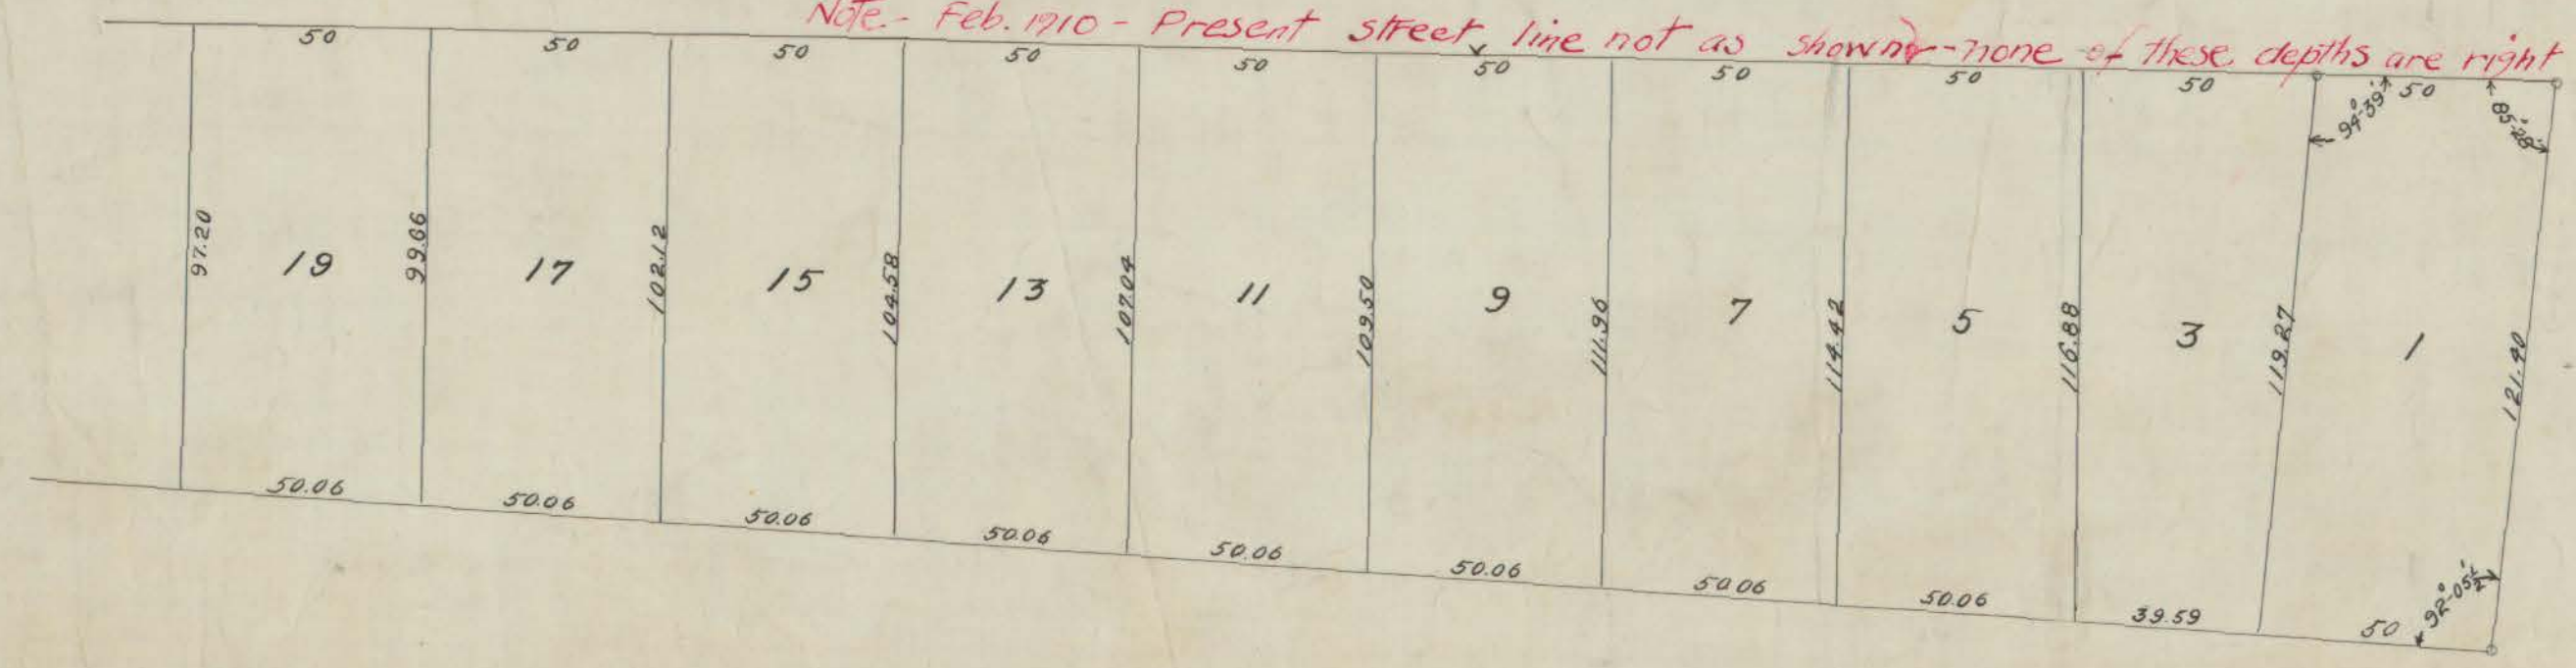

PLAN
 of
 Property of
 JAMES DOWD

Surveyed by
 WOLCOTT & DARBY
 OCT. 12, 1897.
 Scale 1" = 40'

SHEET 88
 DRAWN BY 108
 DATE 108