


82
164
192




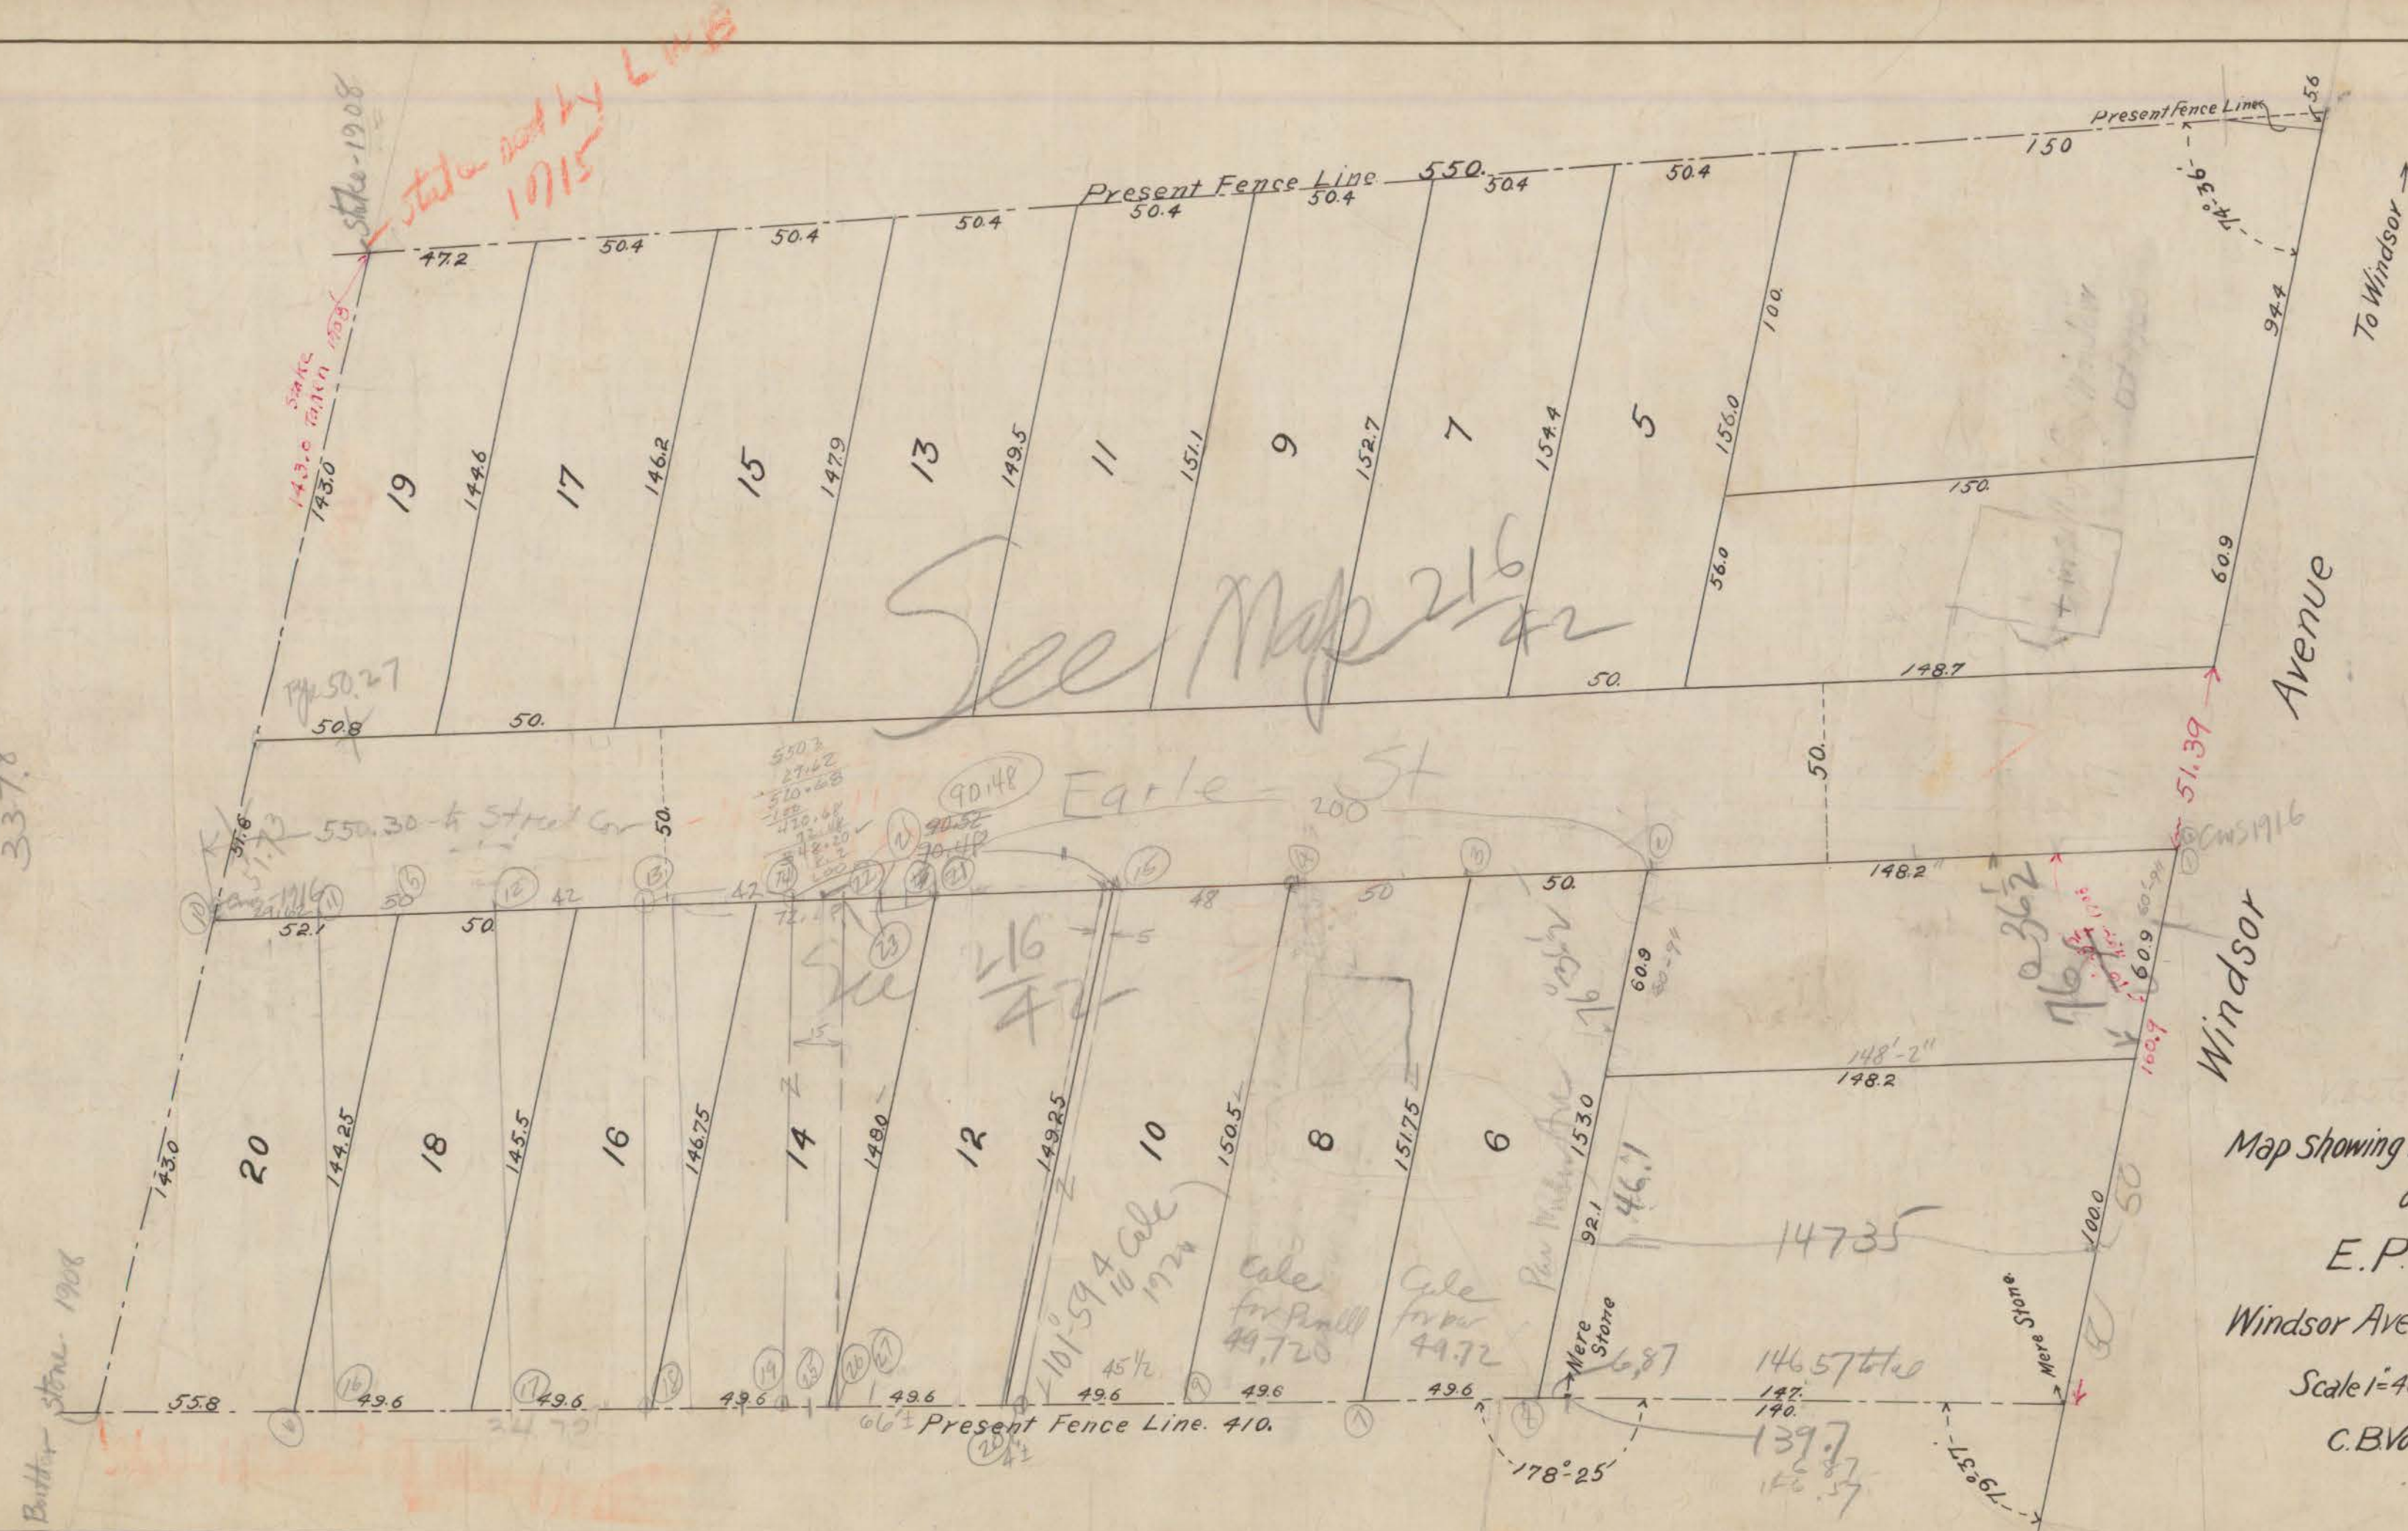

See Map 216/42

Tube checked - 1915 - Mt 372
Center line of Earl St 1706 South of east end of cellar window sill - under the bay window in the south side of the house on the N.W. cor. of Windsor Ave - 90° to Earl St. also 5103 North of the N.W. cor. of the House 240° west of Windsor Ave from woodwork at 90° to St Line - H.G.C. Oct 1908
Mt 372 - P1000

Map showing Property of
E.P. Yates.
Windsor Ave. Martford Ct.
Scale 1"=40' May 1900
C.B. Vorce Engr.

