


200
630

200
630

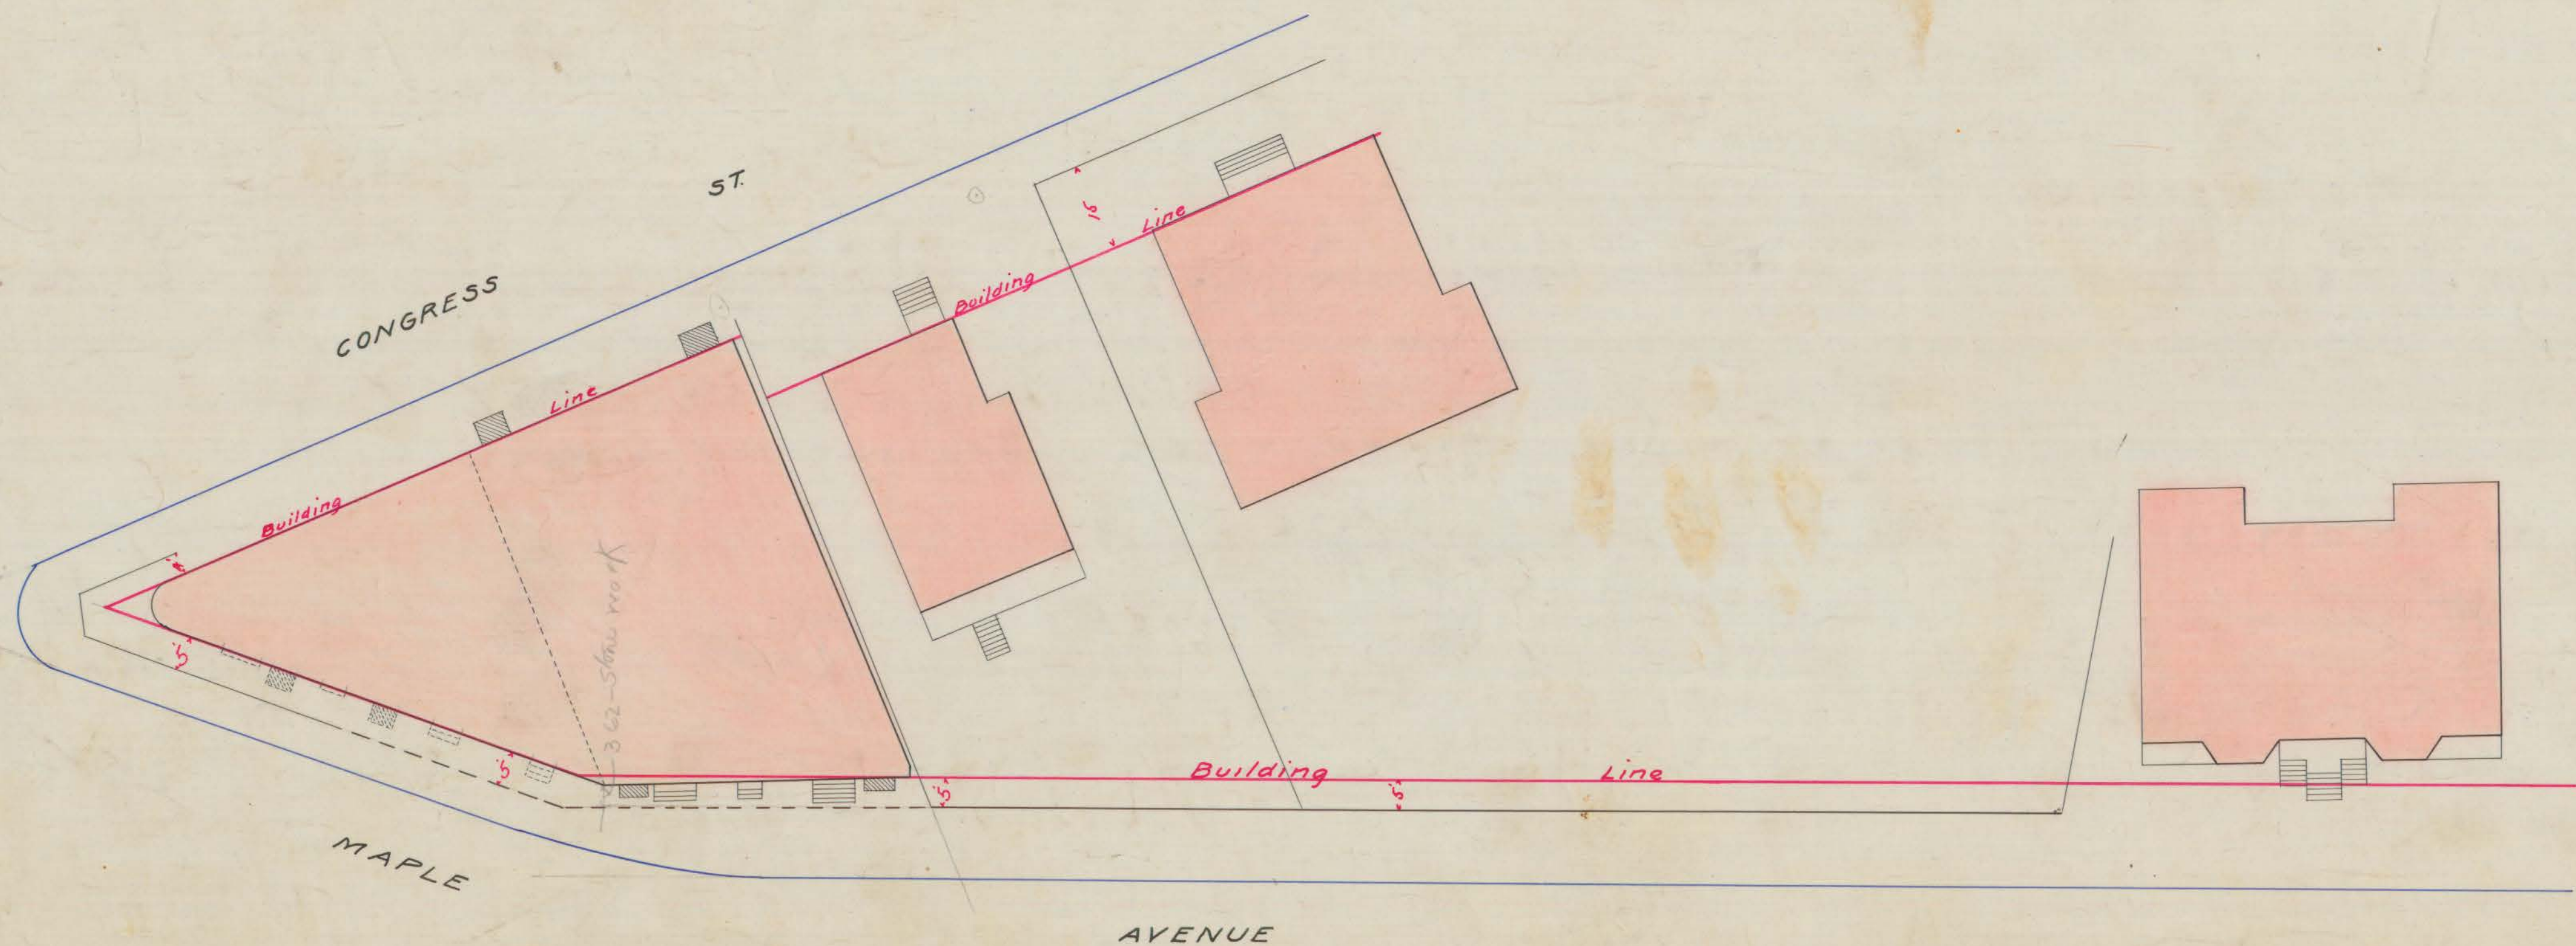

CITY ENGINEER'S OFFICE,
HARTFORD, CONN.
STREET & MISCELLANEOUS DEPT.
Date July 11, 1900 Day Book No. 0913
Notes Vol. 156 PP. 132 - 133

200
630

200
630