


SHEET 1
 50
 00
 00

50
 00
 00

Cedar Hill Cemetery

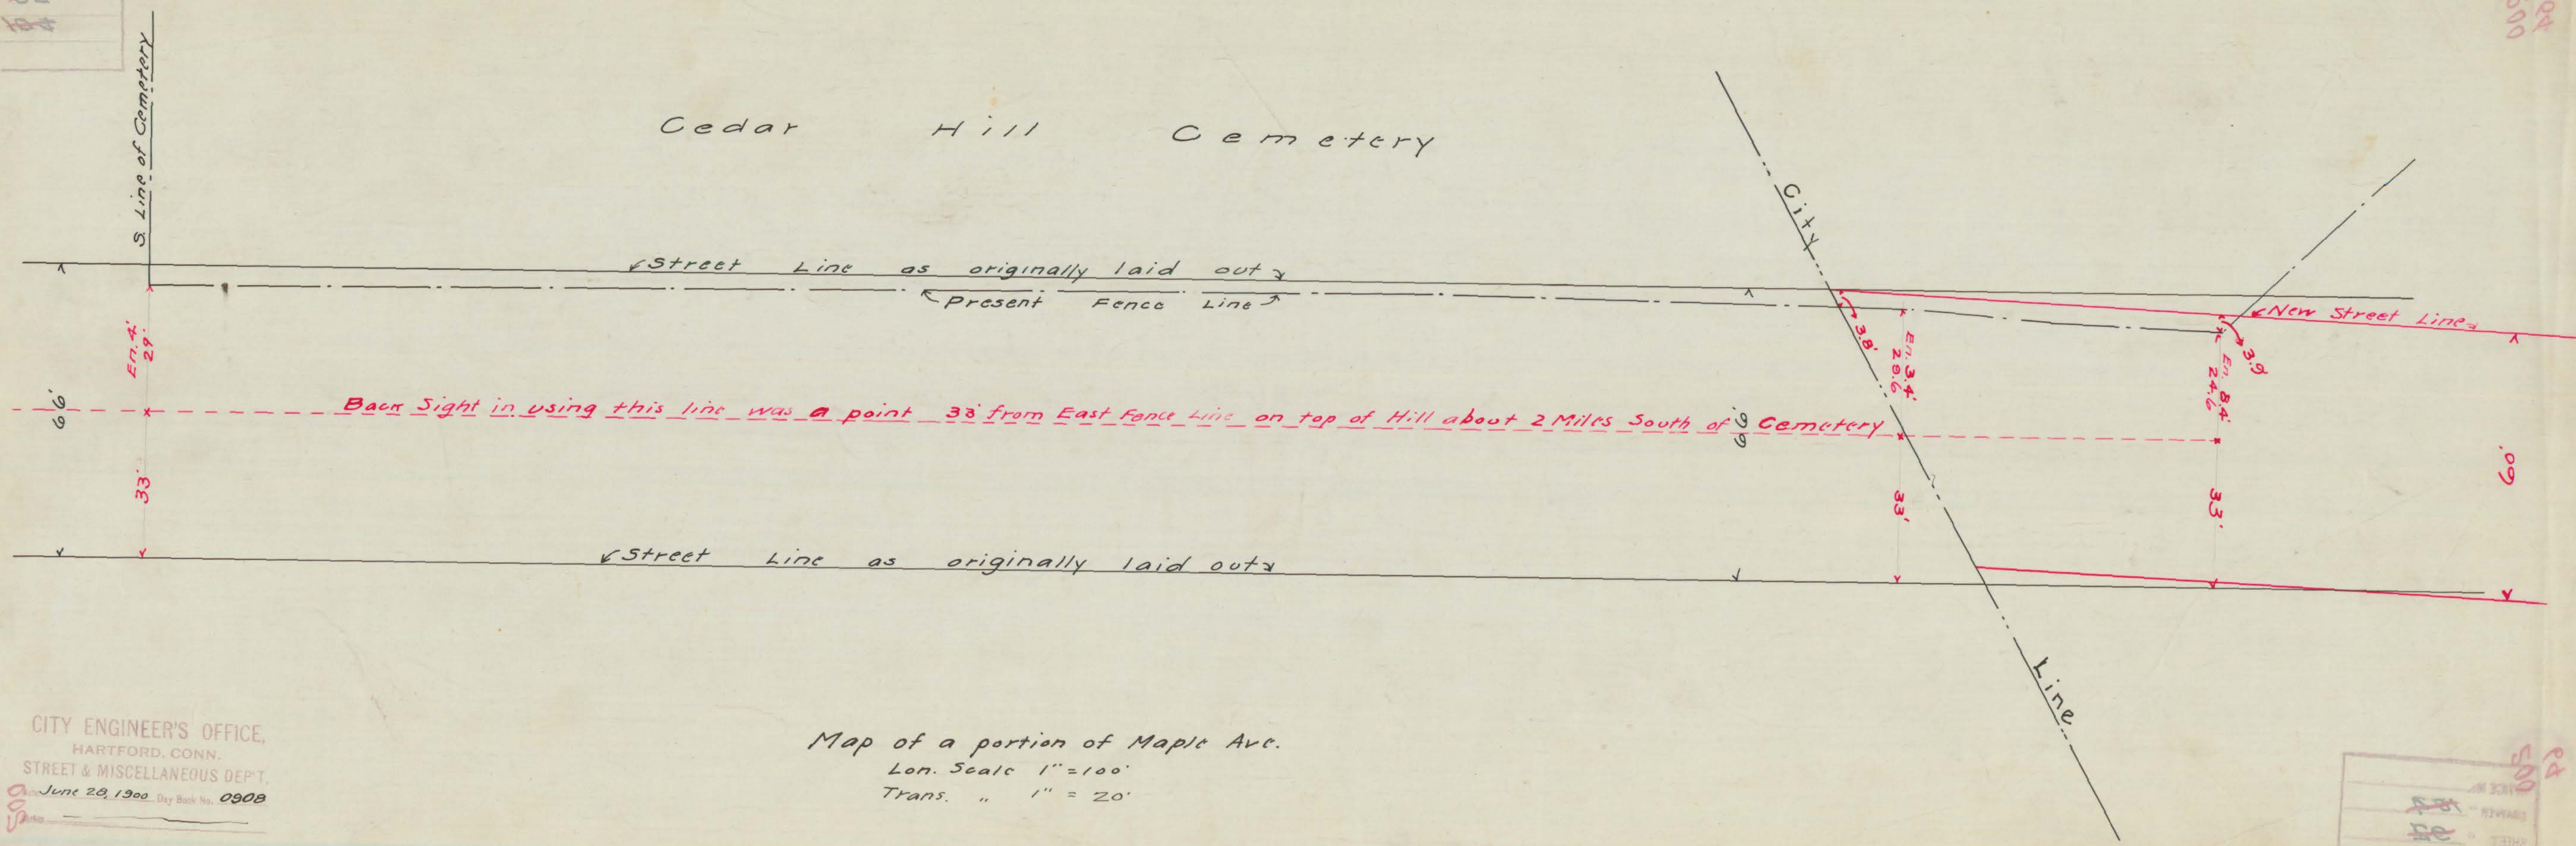

CITY ENGINEER'S OFFICE,
 HARTFORD, CONN.
 STREET & MISCELLANEOUS DEPT.
 June 28, 1900 Day Book No. 0908
 City Engineer

Map of a portion of Maple Ave.
 Lon. Scale 1" = 100'
 Trans. " 1" = 20'

SHEET 1
 50
 00
 00