



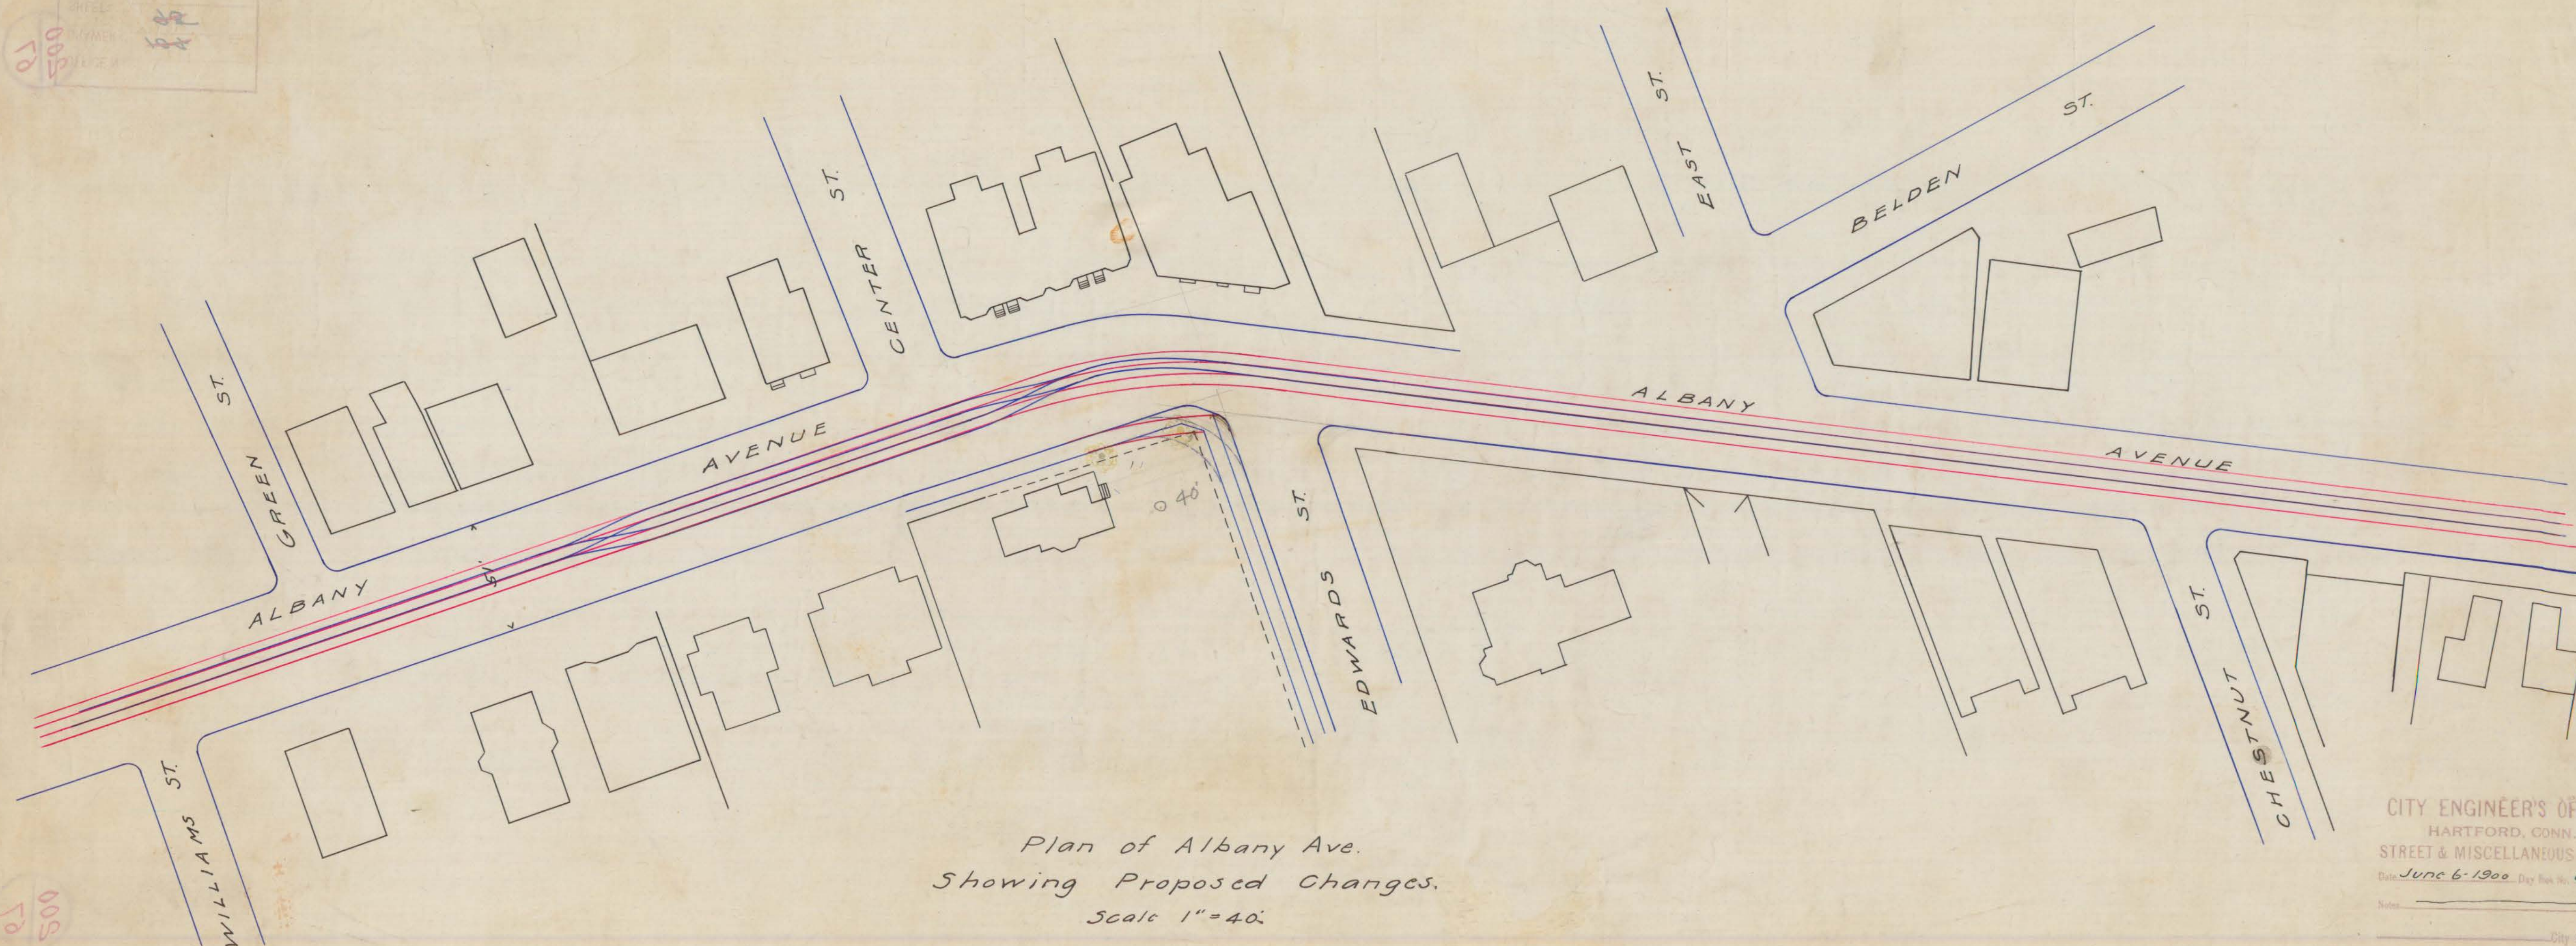

Plan of Albany Ave.
Showing Proposed Changes.
Scale 1"=40'

CITY ENGINEER'S OFFICE,
HARTFORD, CONN.
STREET & MISCELLANEOUS DEPT.
Date June 6-1900 Day Book No. 0890
Notes _____
City Engineer.


