


MAP No. 2
 FREDERICK MAHL'S.
 PROPERTY
 SCALE 50 FEET TO AN INCH
 H.G. & F. W. LOOMIS. C.E.

50-67
 5'08
 123.53

1500

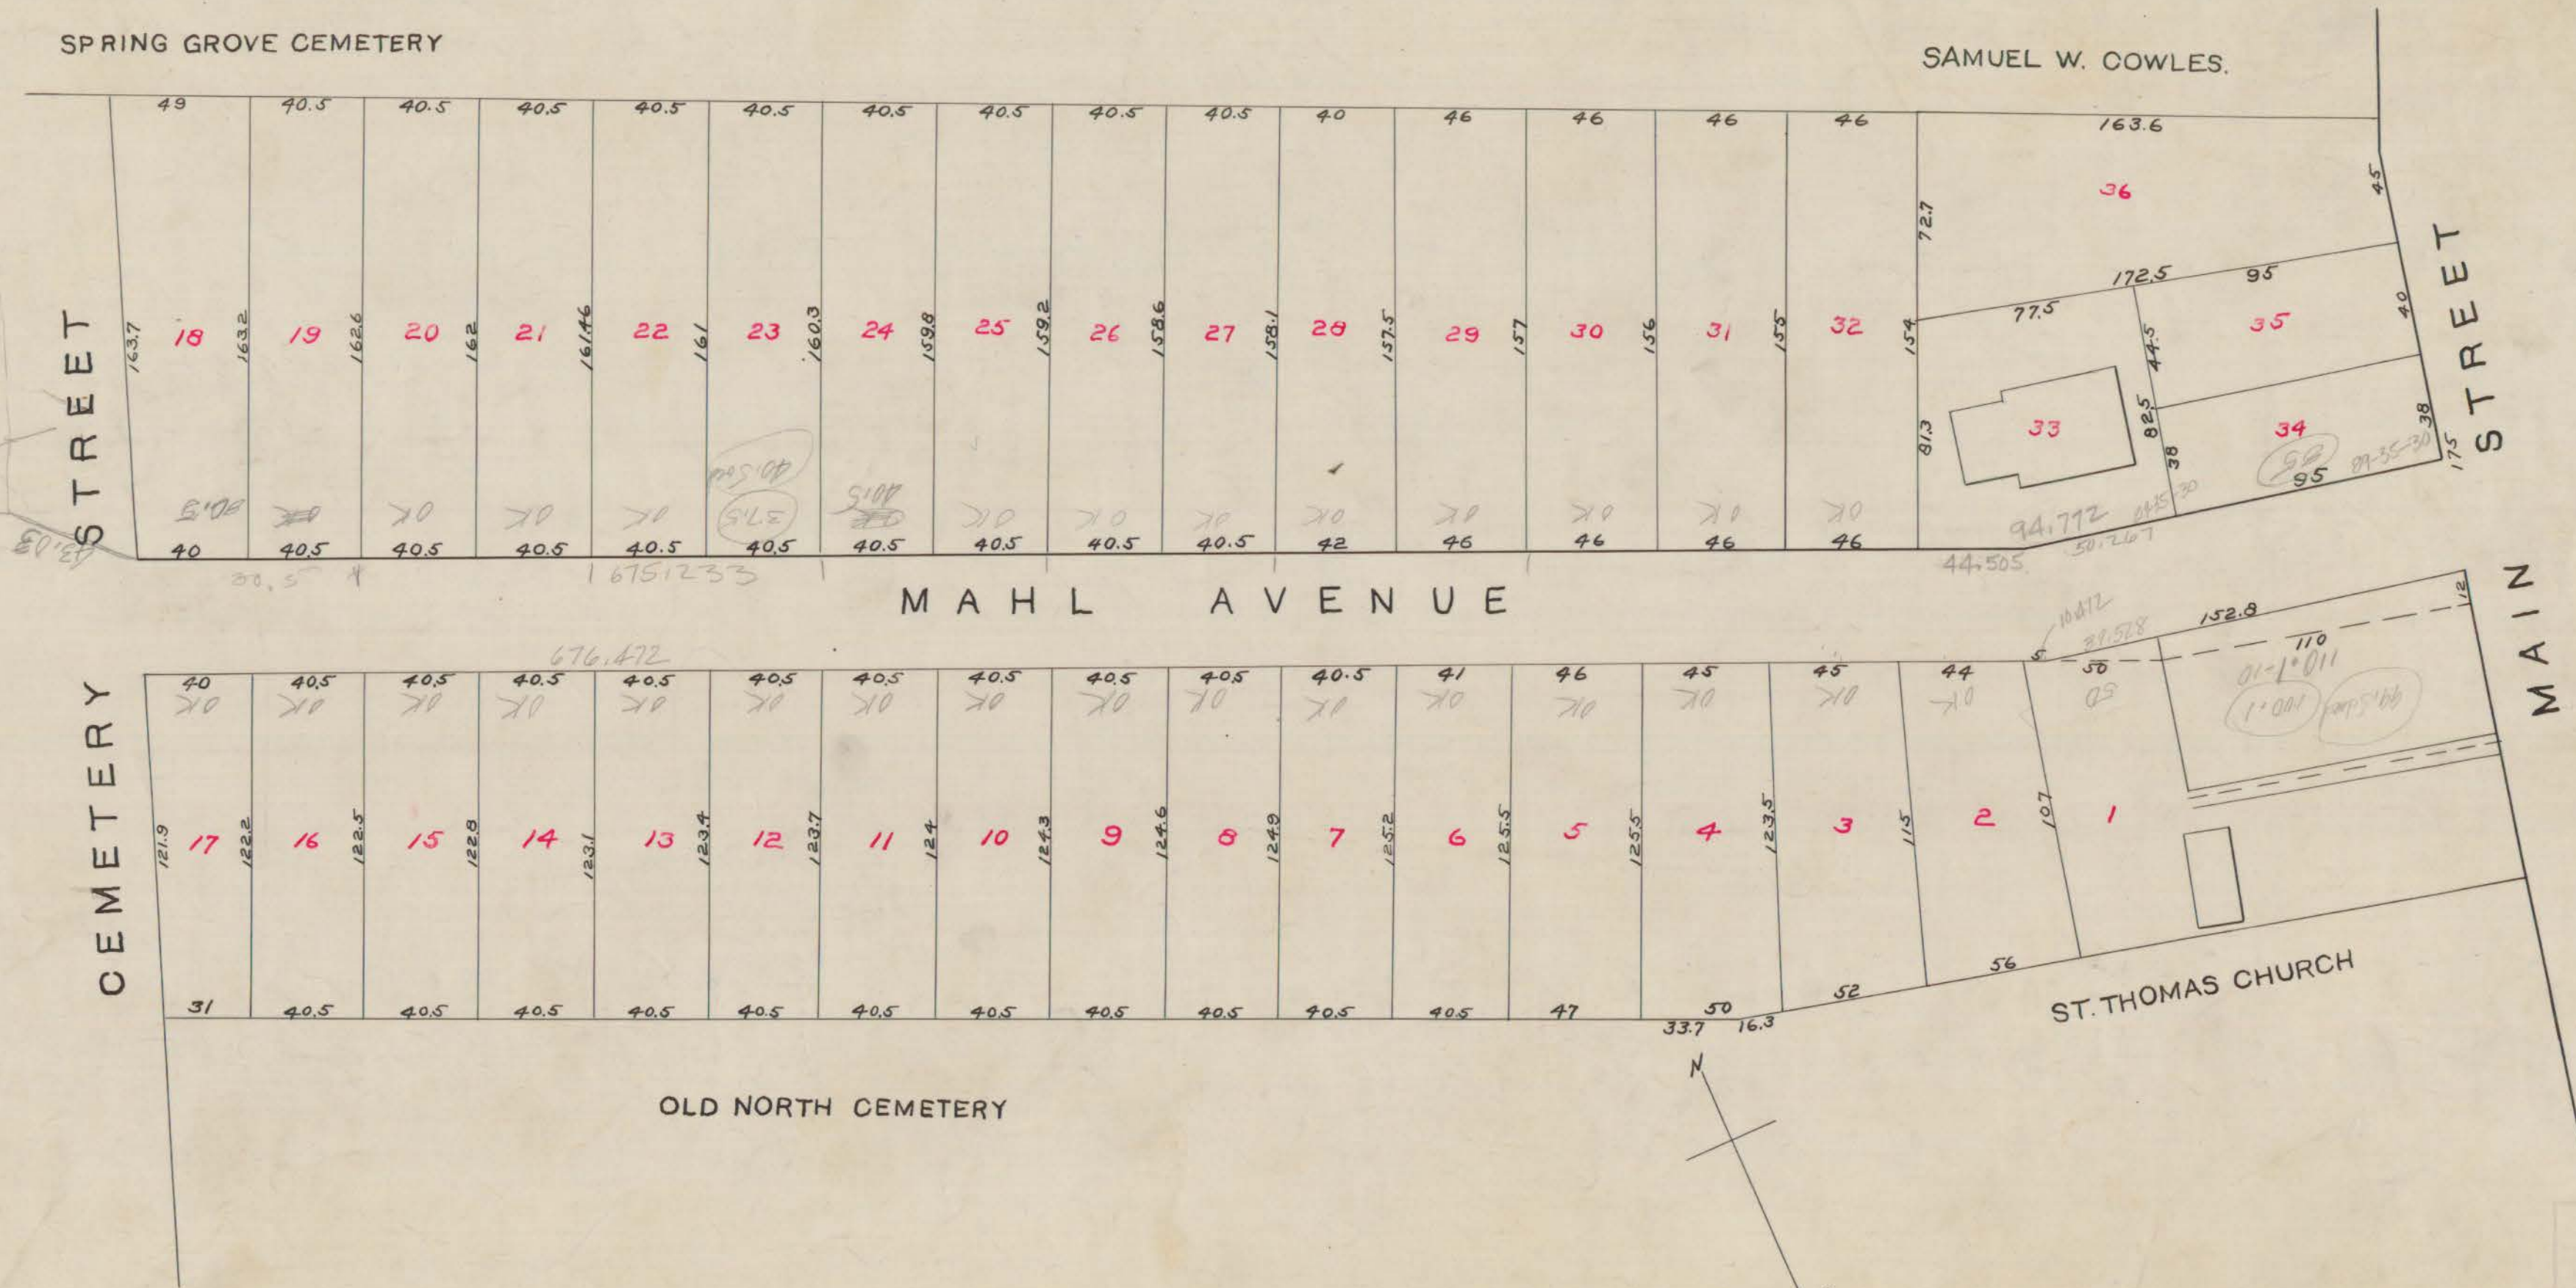

CITY ENGINEER'S OFFICE,
 HARTFORD, CONN.
 STREET & MISCELLANEOUS DEPT.
 Date Feb. 13, 1900. Day Book No. 0784

City Engineer.

104

