
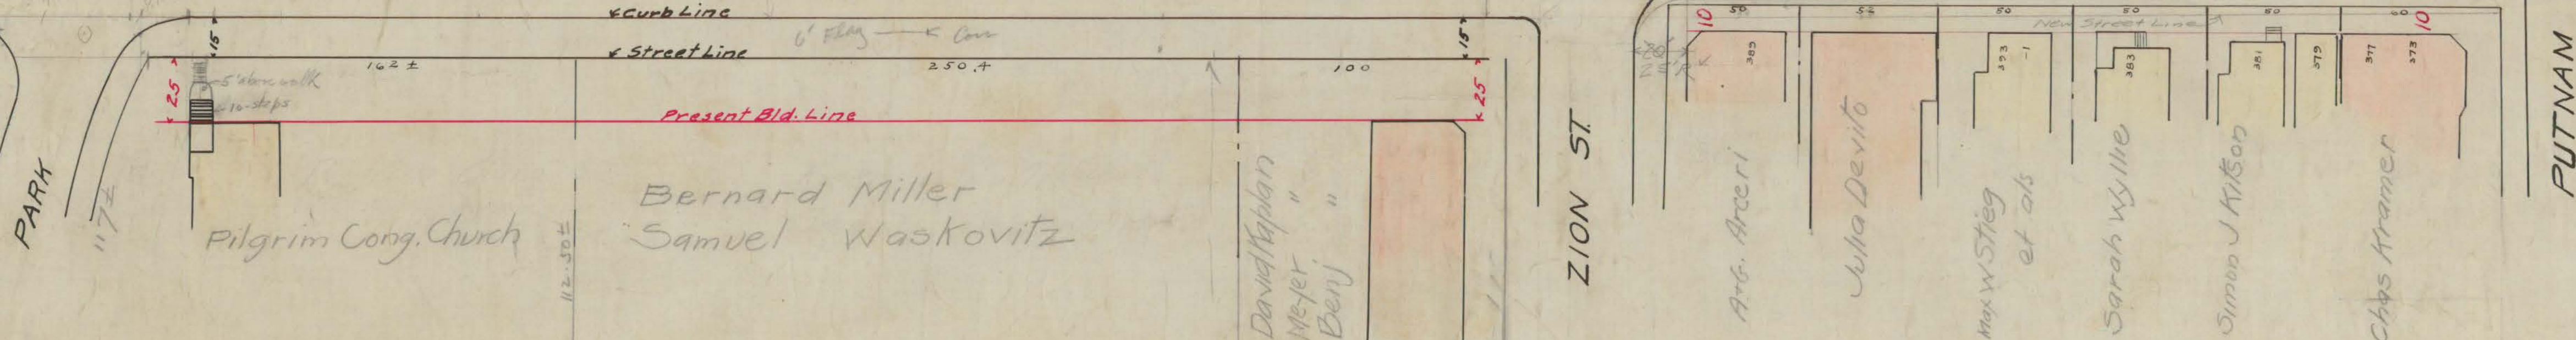


PARK STREET

SCALE 1" = 40'

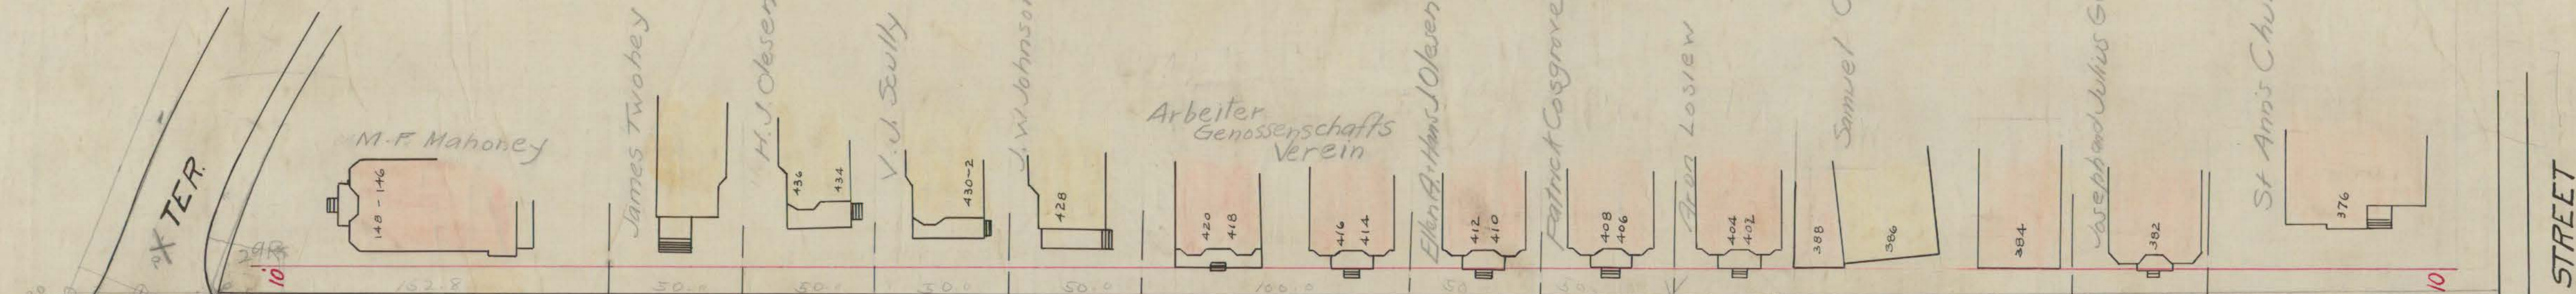

OFFICE OF CITY ENGINEER
HARTFORD, CONN.

Date Jan - 1913

03142