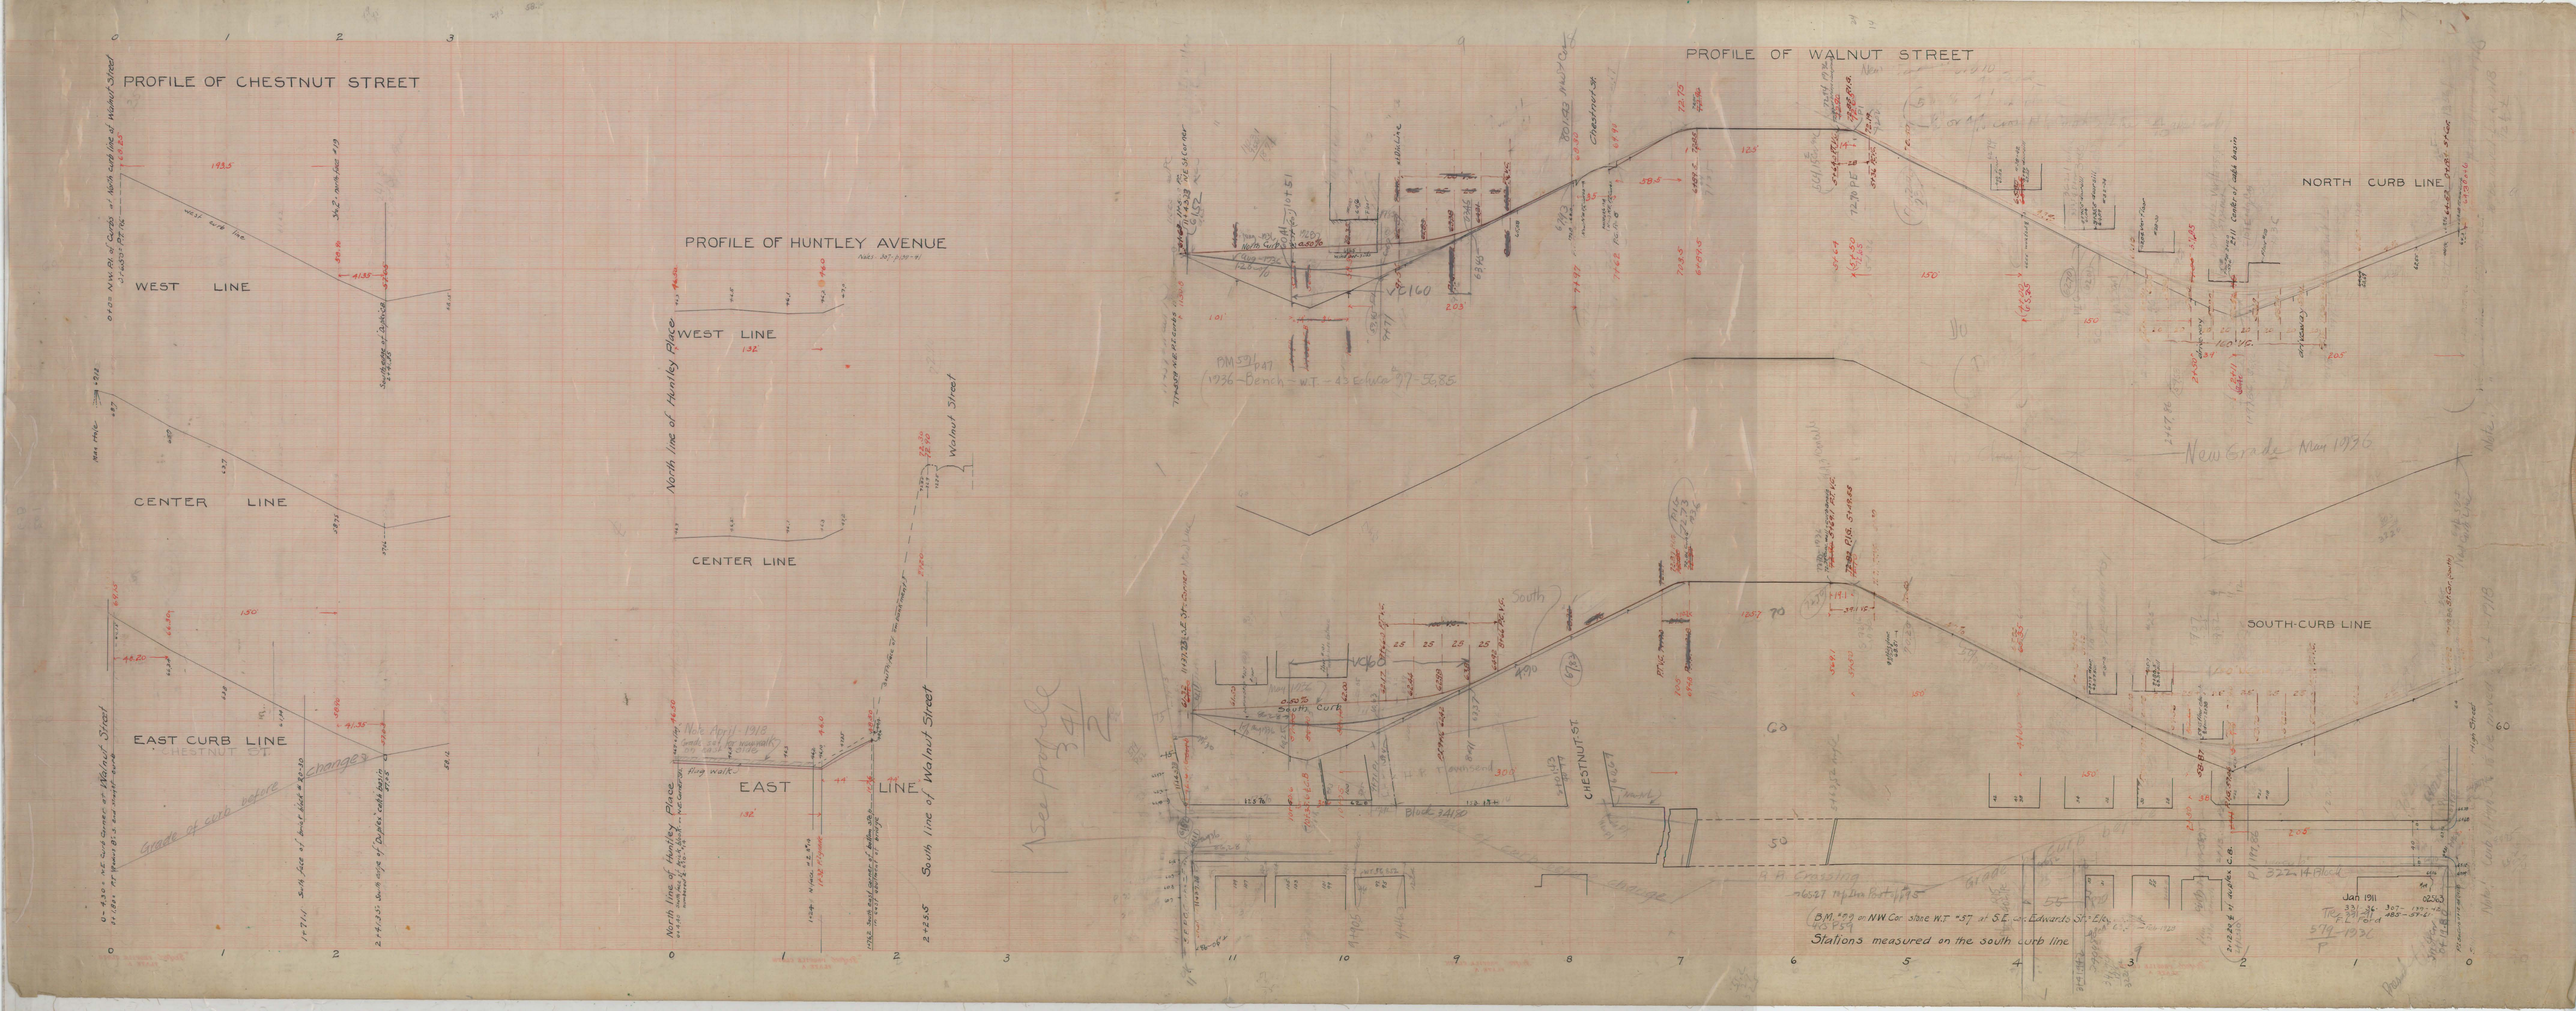
PROFILE OF CHESTNUT STREET
WEST LINE
CENTER LINE
EAST CURB LINE
Grade of curb before changes
PROFILE OF HUNTLEY AVENUE
WEST LINE
CENTER LINE
EAST LINE
North line of Huntley Place
South line of Walnut Street
Walnut Street
Note April 1918
PROFILE OF WALNUT STREET
NORTH CURB LINE
SOUTH-CURB LINE
New Grade May 1936
CHESTNUT ST
Block 34160
4 A Crossing
BM 559 on N.W. Cor. base W.T. #57 at S.E. Cor. Edwards St. Elev.
Stations measured on the south curb line
Jan 1911
See Profile 34 1/2