

CHARTER OAK AVENUE



GOVERNOR STREET

KINSELLA SCHOOL
GRADING PLAN
SCALE: 1"=20'




Existing elevations shown thus - 37.00
 Proposed elevations shown thus - 37.00

- LEGEND**
- Excavate, place 10" processed trap rock base, 2 1/2" bit concrete and seal surface.
 - Excavate, place 8" processed trap rock base, 2" bit concrete and seal surface.

NOTE: 1965 Paving Added 6-22-65

Revision of Aug 2, 1949 - Flow line elevations of catch basin (Section A-A) raised

DAYBOOK No. 09032

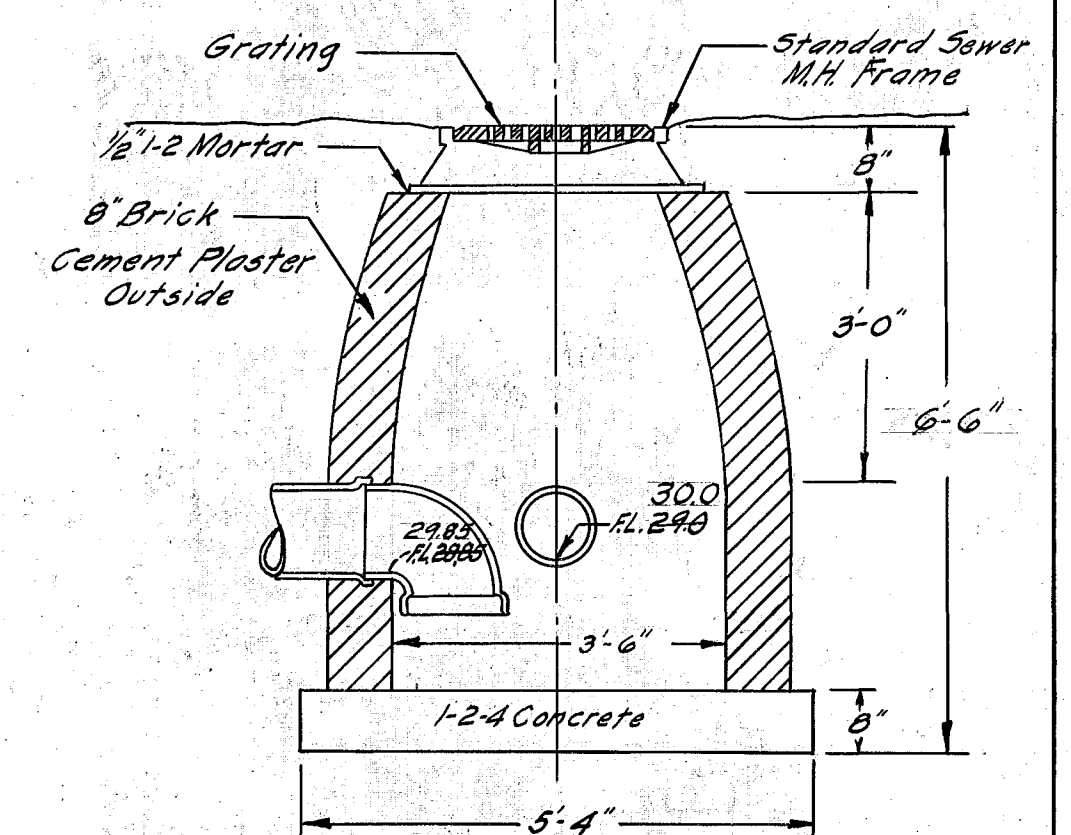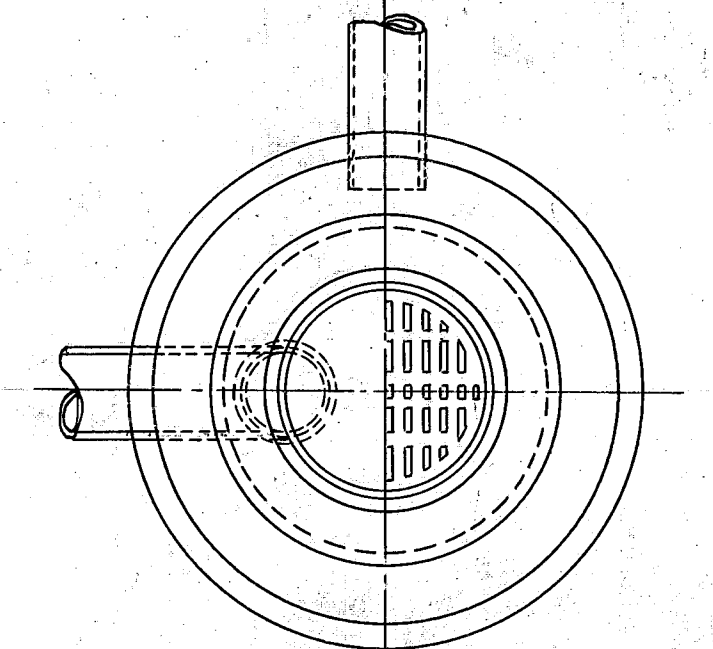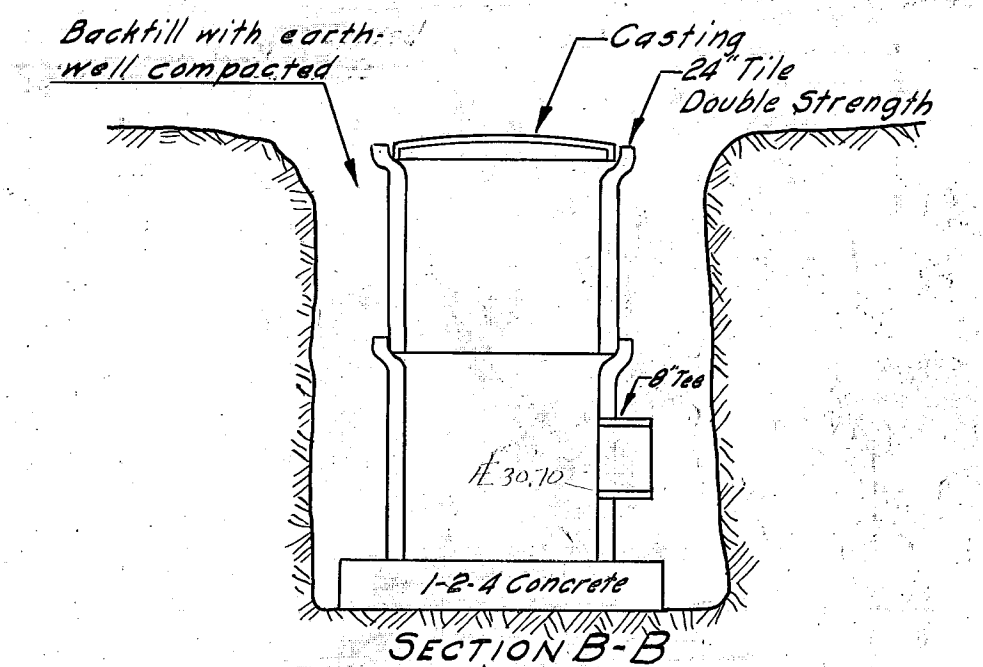

SECTION A-A
 Scale of Sections - 1/2" = 1'

CITY OF HARTFORD
DEPARTMENT OF ENGINEERING
SCALES AS NOTED JULY 1949
NOTES 797 P.34