



Plan
of
HURLBURT ST.
1896.
Scale 1 inch = 20 ft.

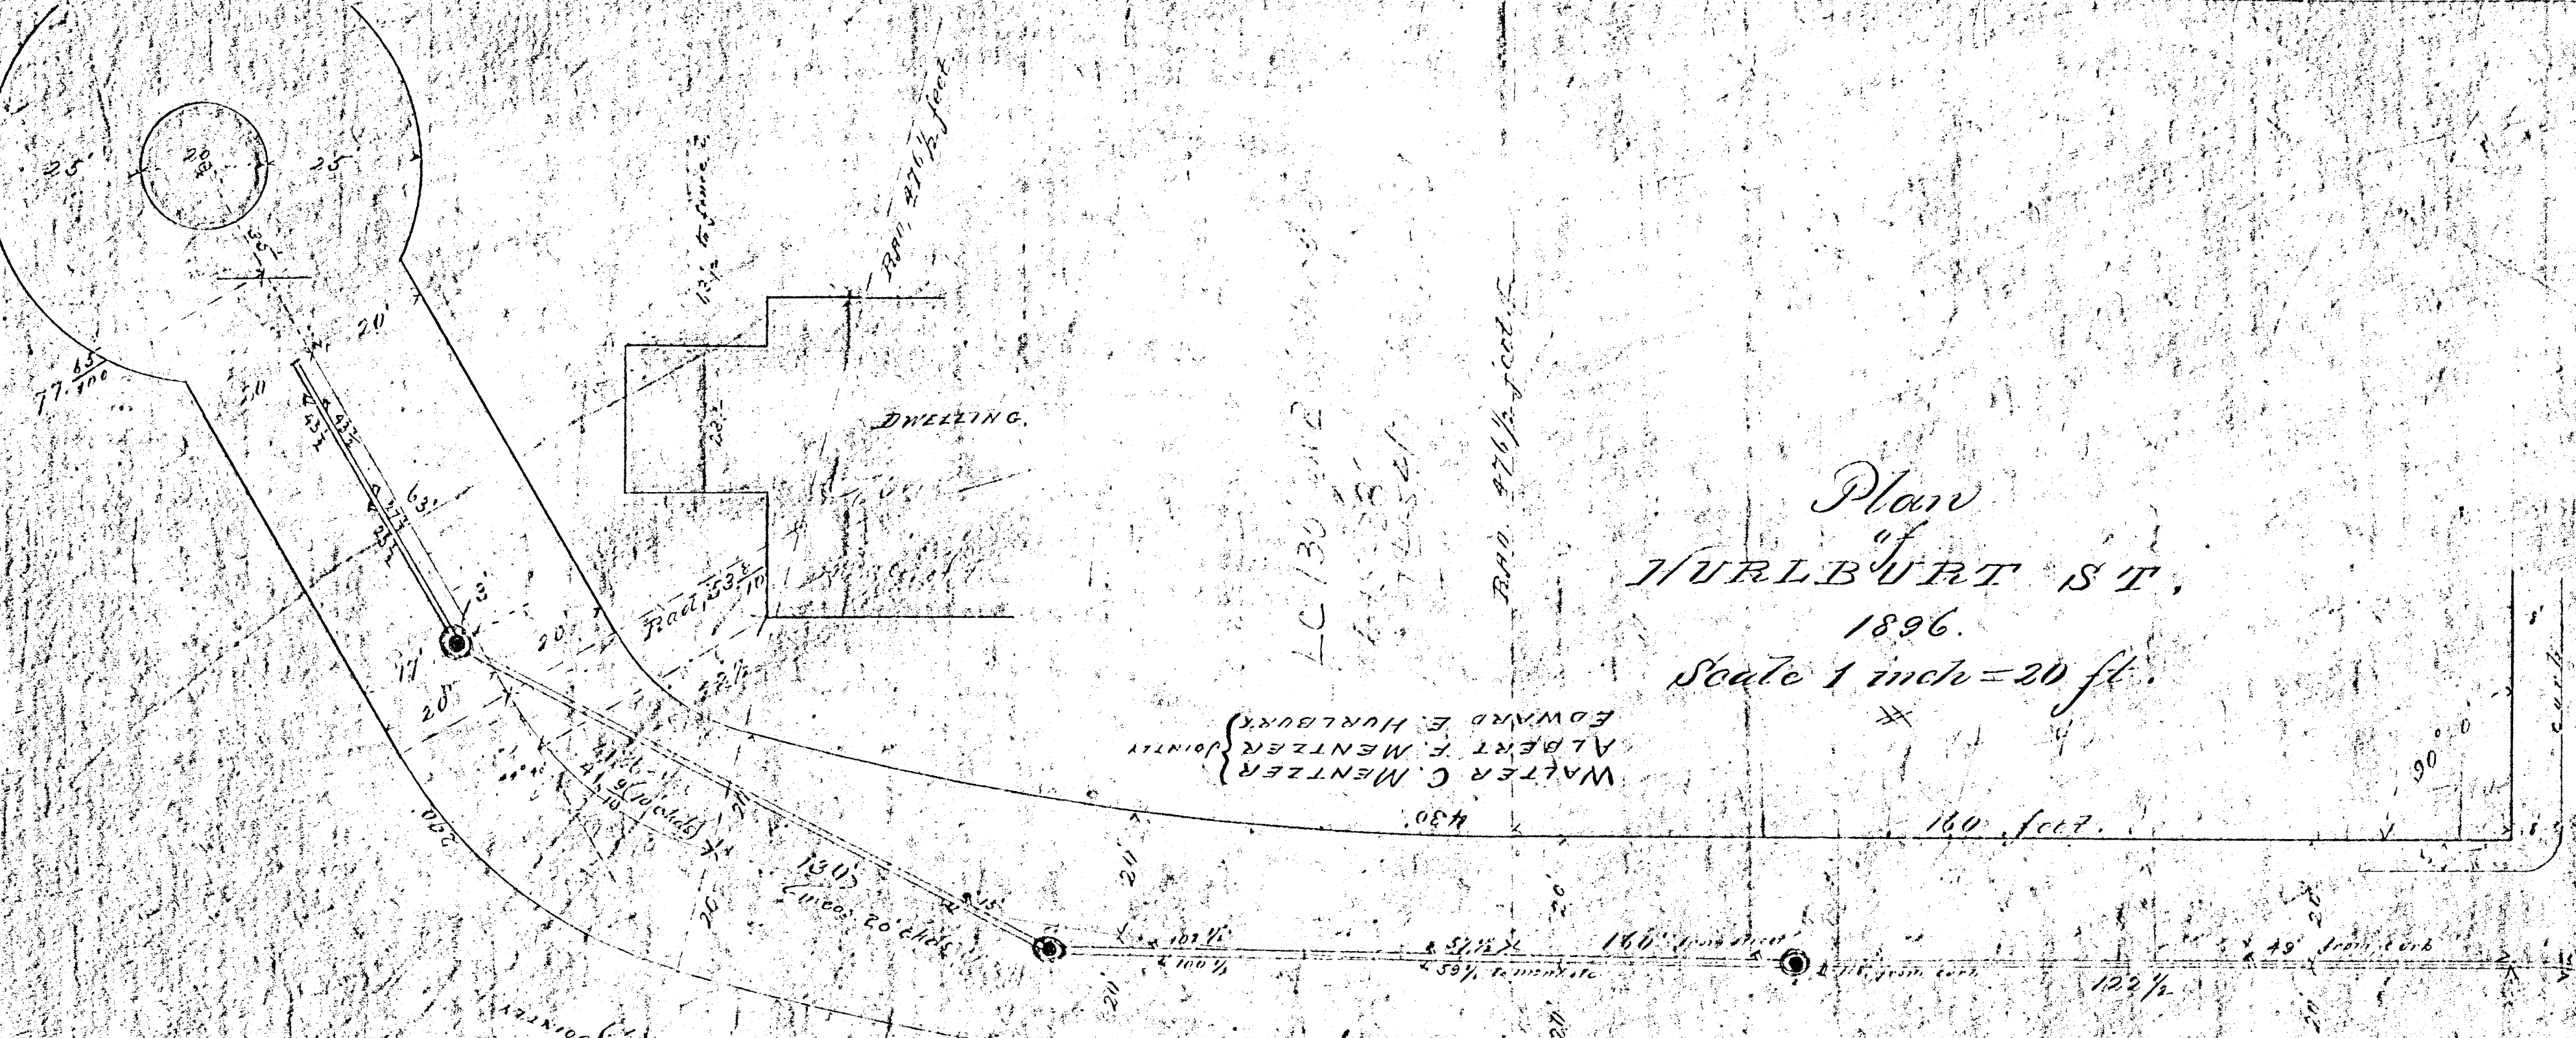

Profile
Vertical. Scale 1" = 10 feet.

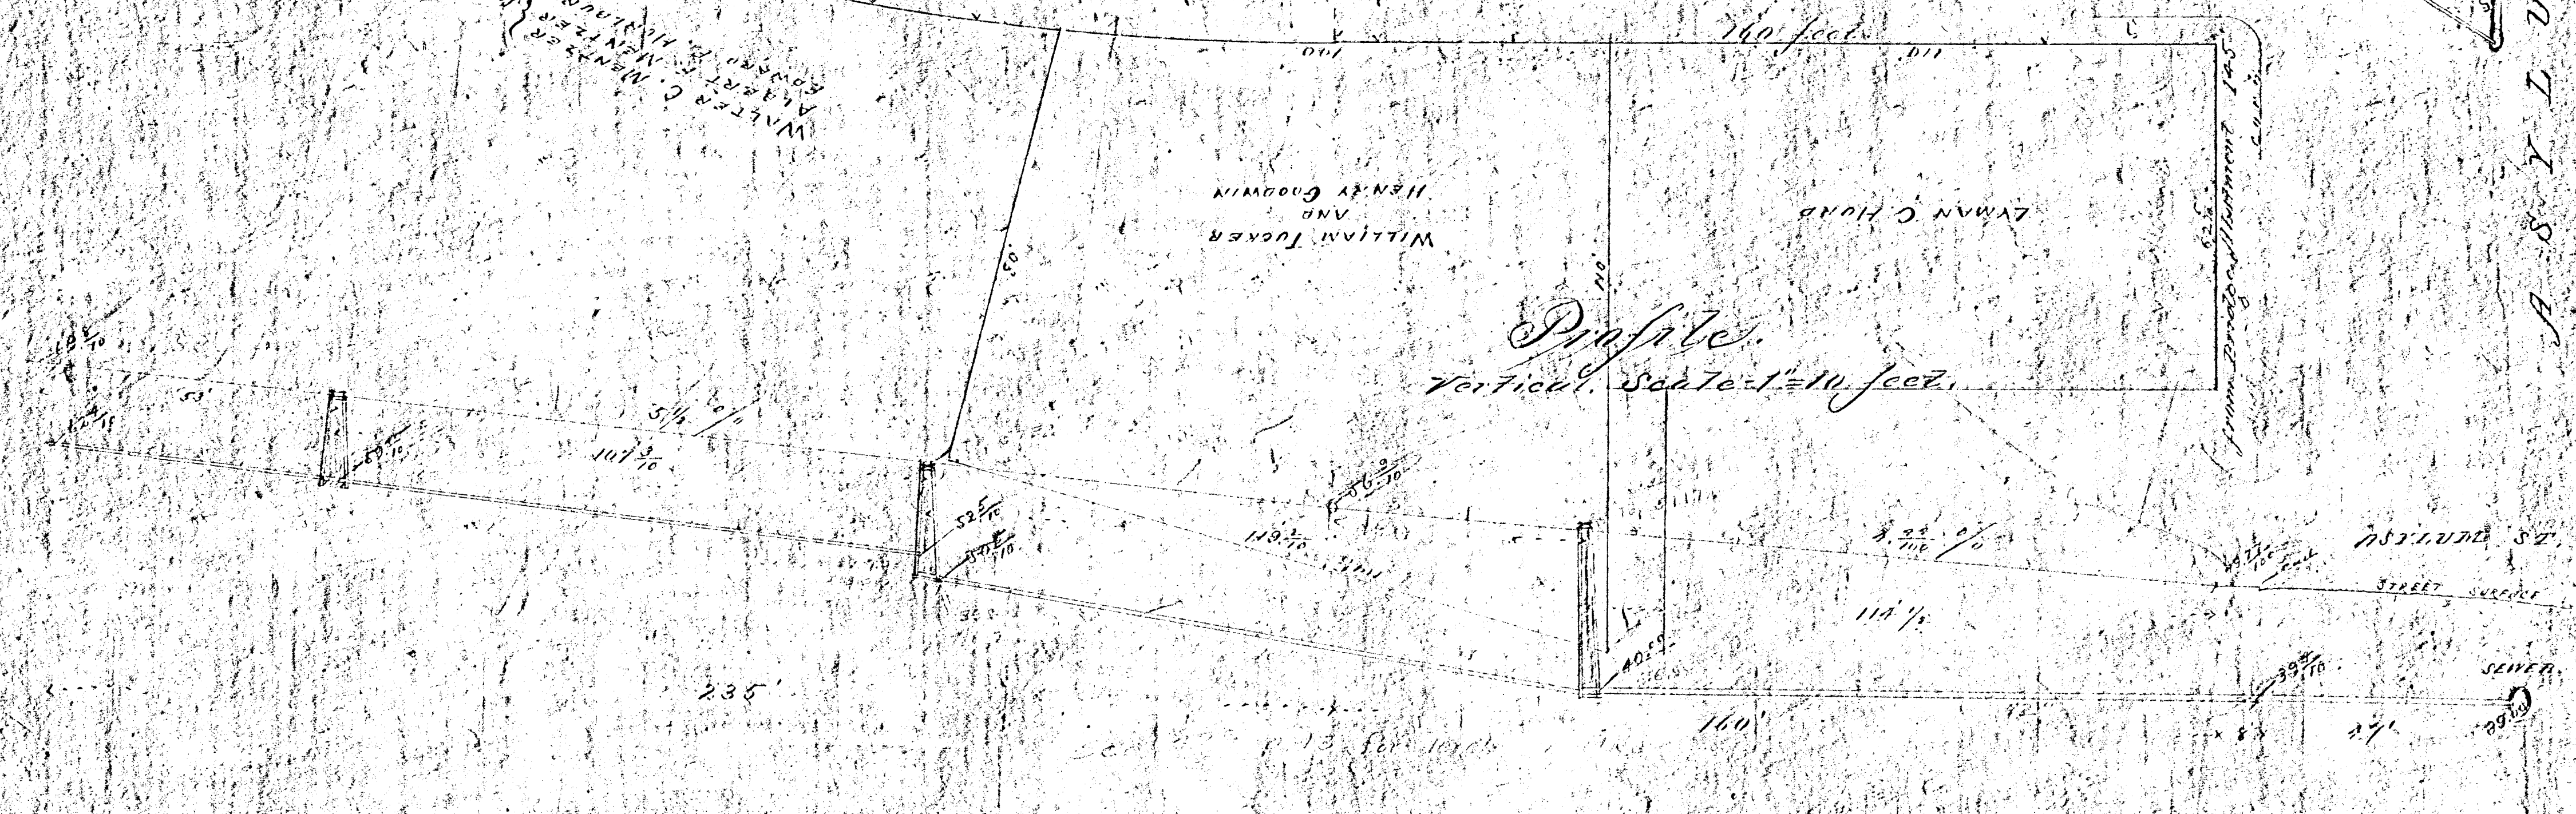

W. Burt
City Eng.

Note Book 244 - Page Tie of Center Line