


DOROTHY STREET

SCALE 1" = 40'

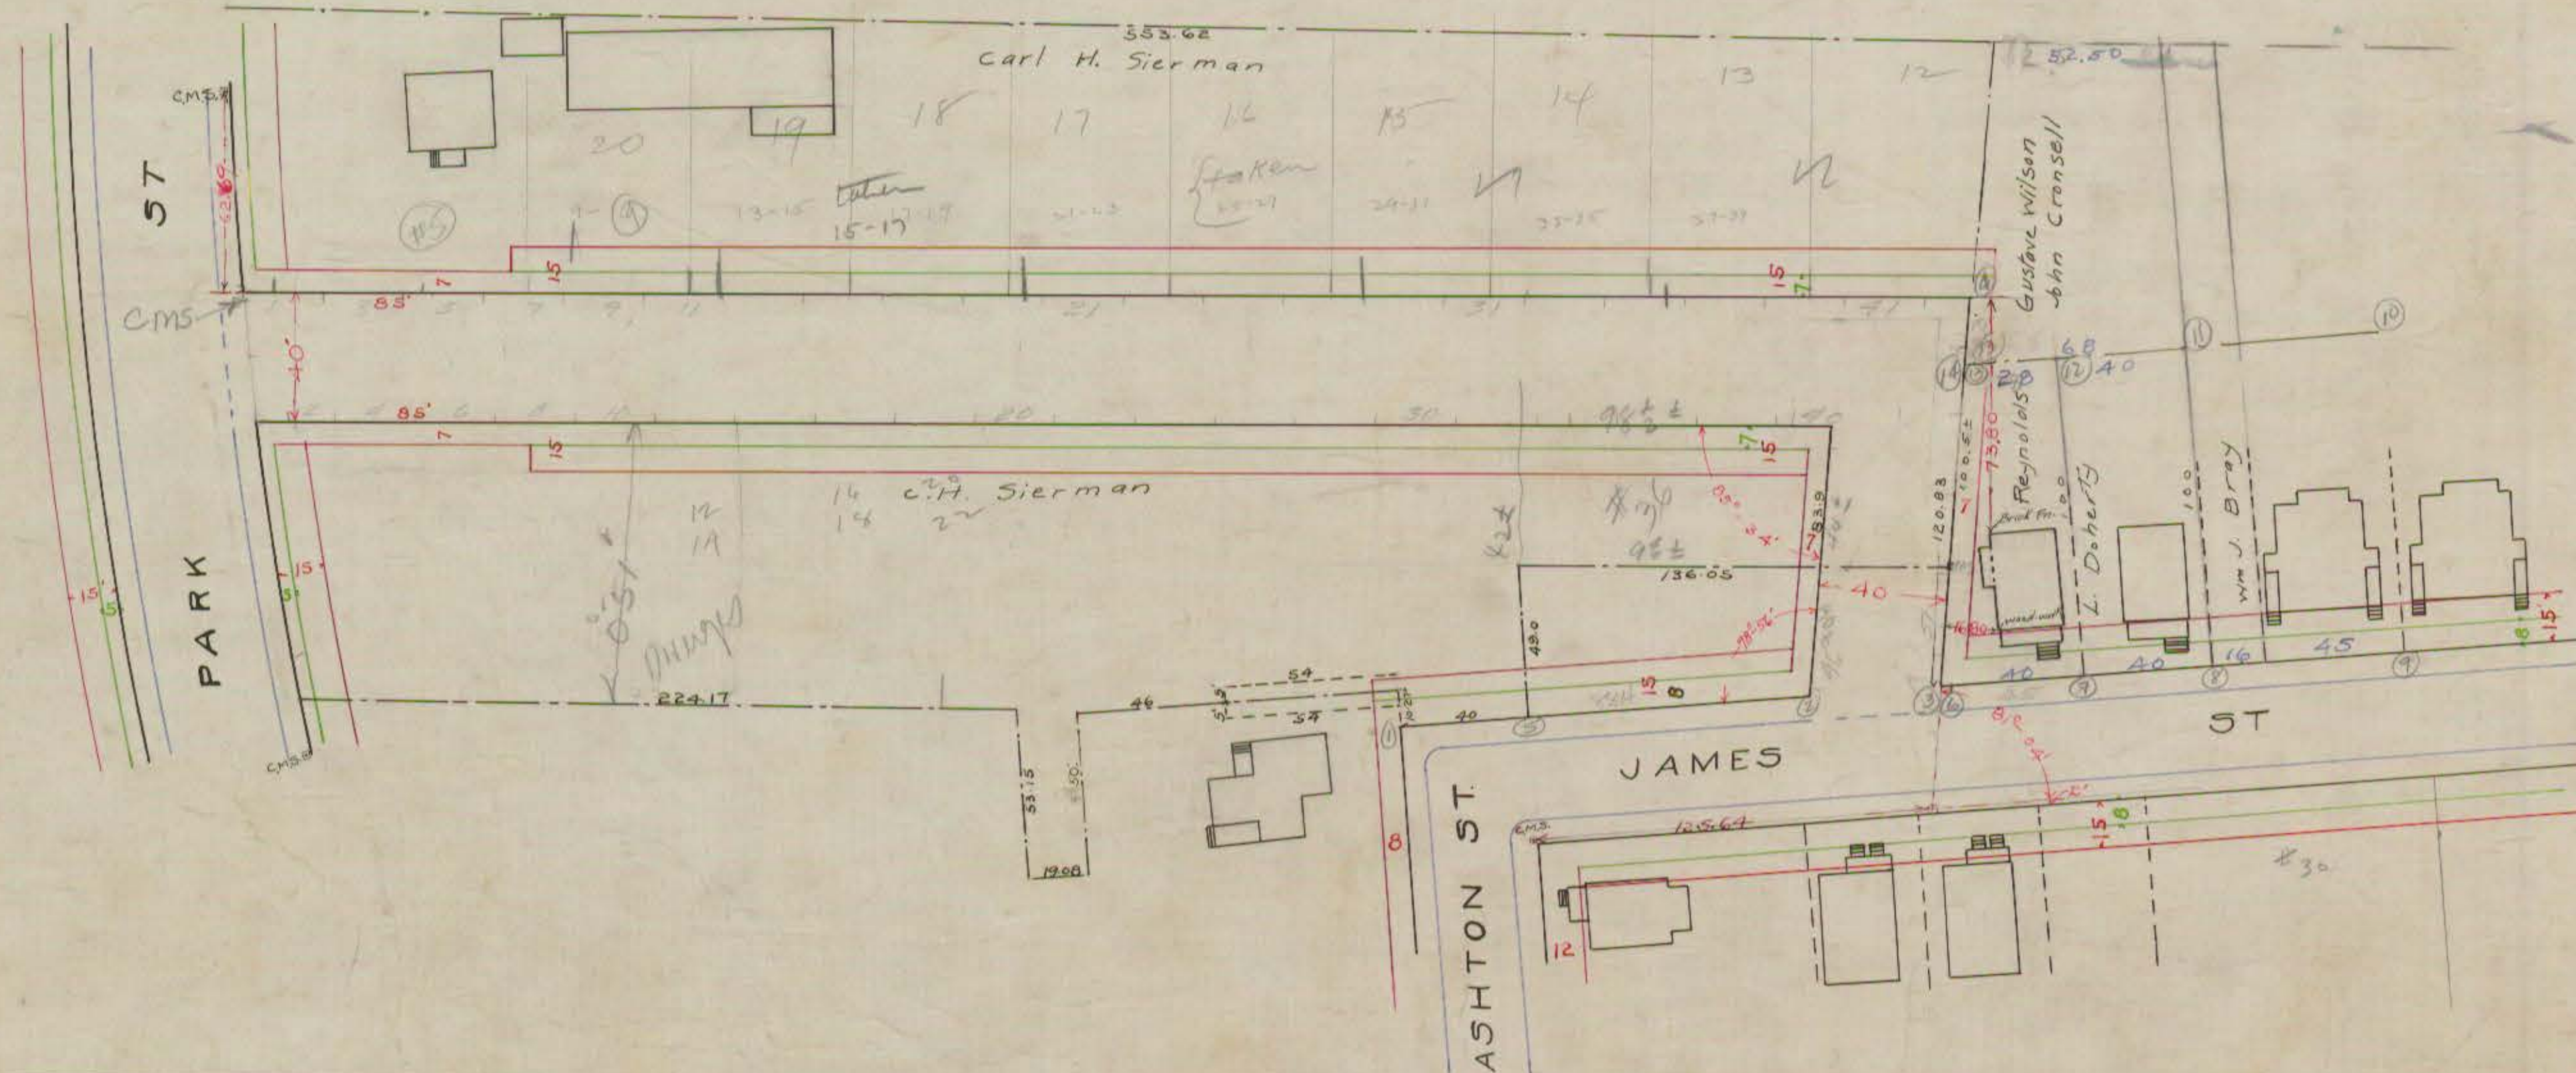

June 1913

03307

378