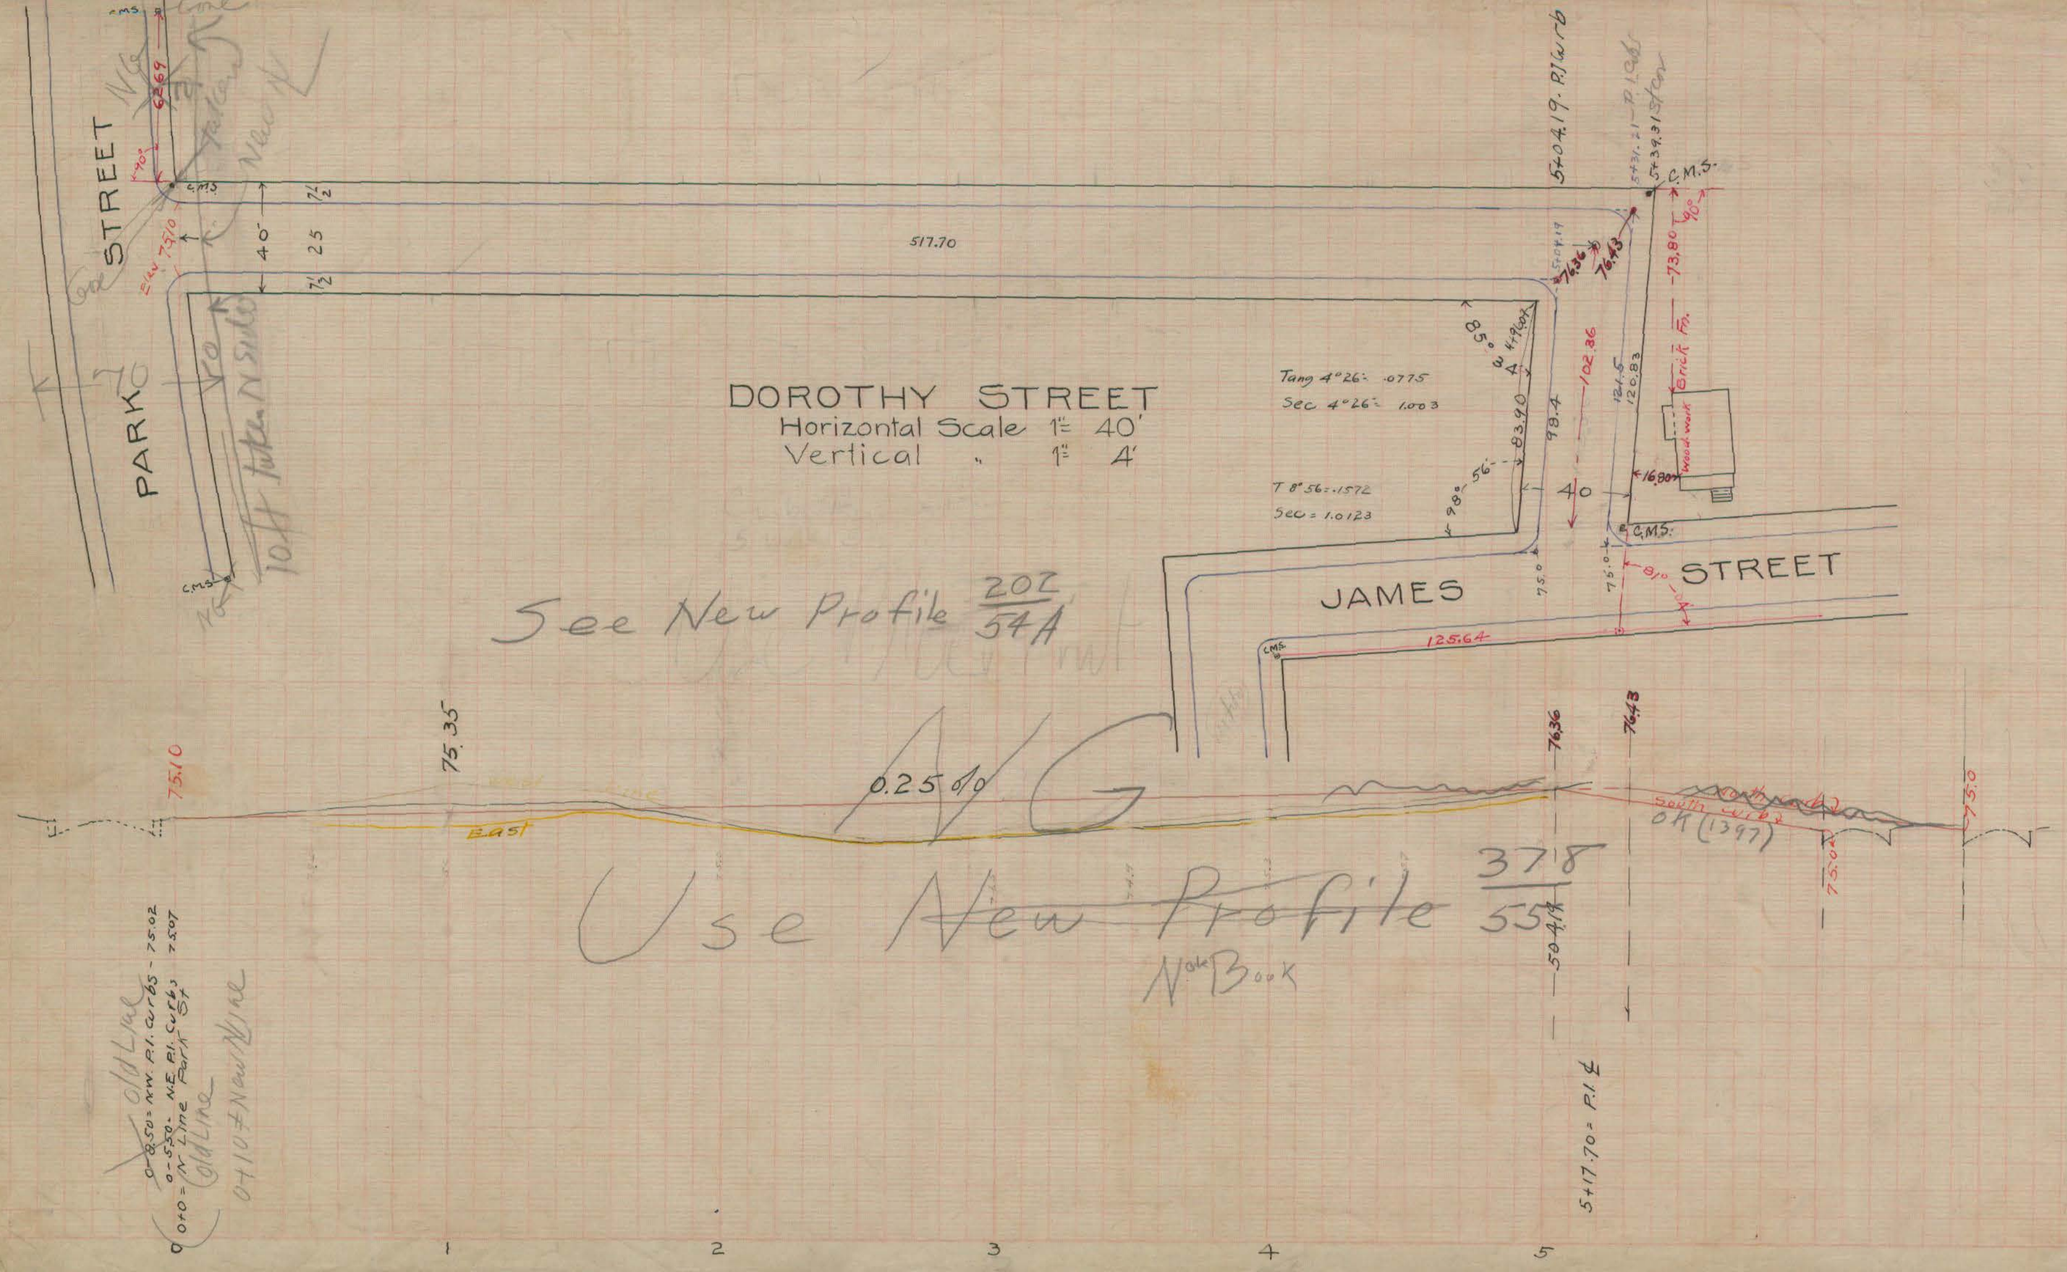
DOROTHY STREET
Horizontal Scale 1" = 40'
Vertical " 1" = 4'
PARK STREET
JAMES STREET
517.70
5+04.19 P.I. Curb
5+39.31 P.I. Curb
C.M.S.
Tang 4°26' .0775
Sec 4°26' 1.003
T 8°56' .1572
Sec = 1.0123
Brick Fr.
Wood work
0.25 o/o
Use ~~New Profile~~ 378/55
Note Book
5+17.70 = P.I. ℄
0+50 = NW. P.I. Curbs - 75.02
0+50 = NE. P.I. Curbs - 75.07
0+10 = N. Line Park St.
Old Line
0+10 = New Line
East
South side
OK (1397)
June 1913
378
03308