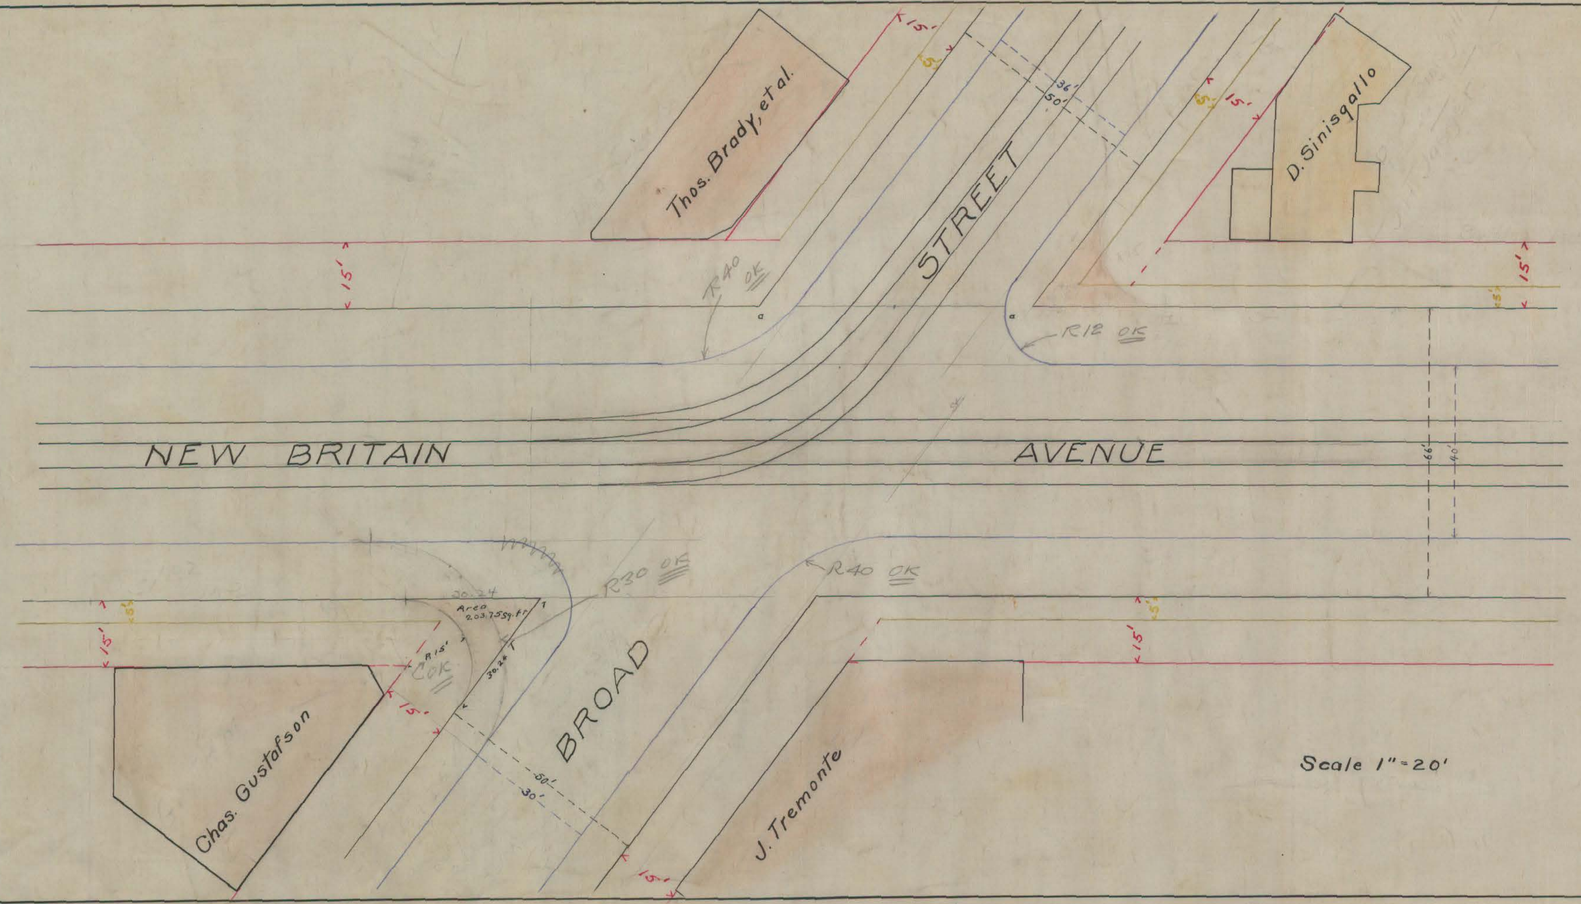
Thos. Brady, et al.
D. Sinisgallo
STREET
NEW BRITAIN
AVENUE
BROAD
Chas. Gustafson
J. Tremonte
R40 OK
R12 OK
R30 OK
R40 OK
R15 OK
Area 203.75 sq. ft.
30.24
30.24
15'
5'
36'
60'
66'
40'
30'
Scale 1" = 20'
Feb. 1913
03/92