


MONROE STREET PLAN FOR HOUSE NUMBERS

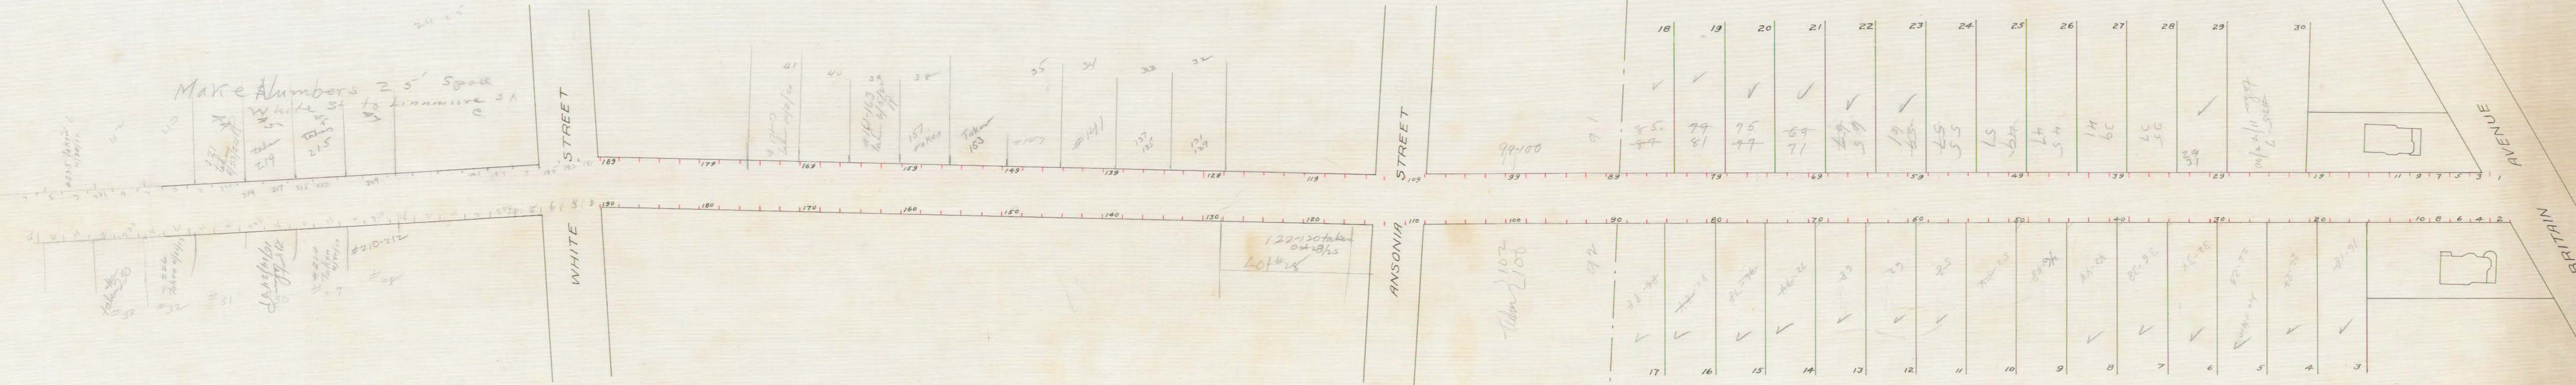

NUMBERS — 20'
SCALE 1"=50'