


5
25
15
45

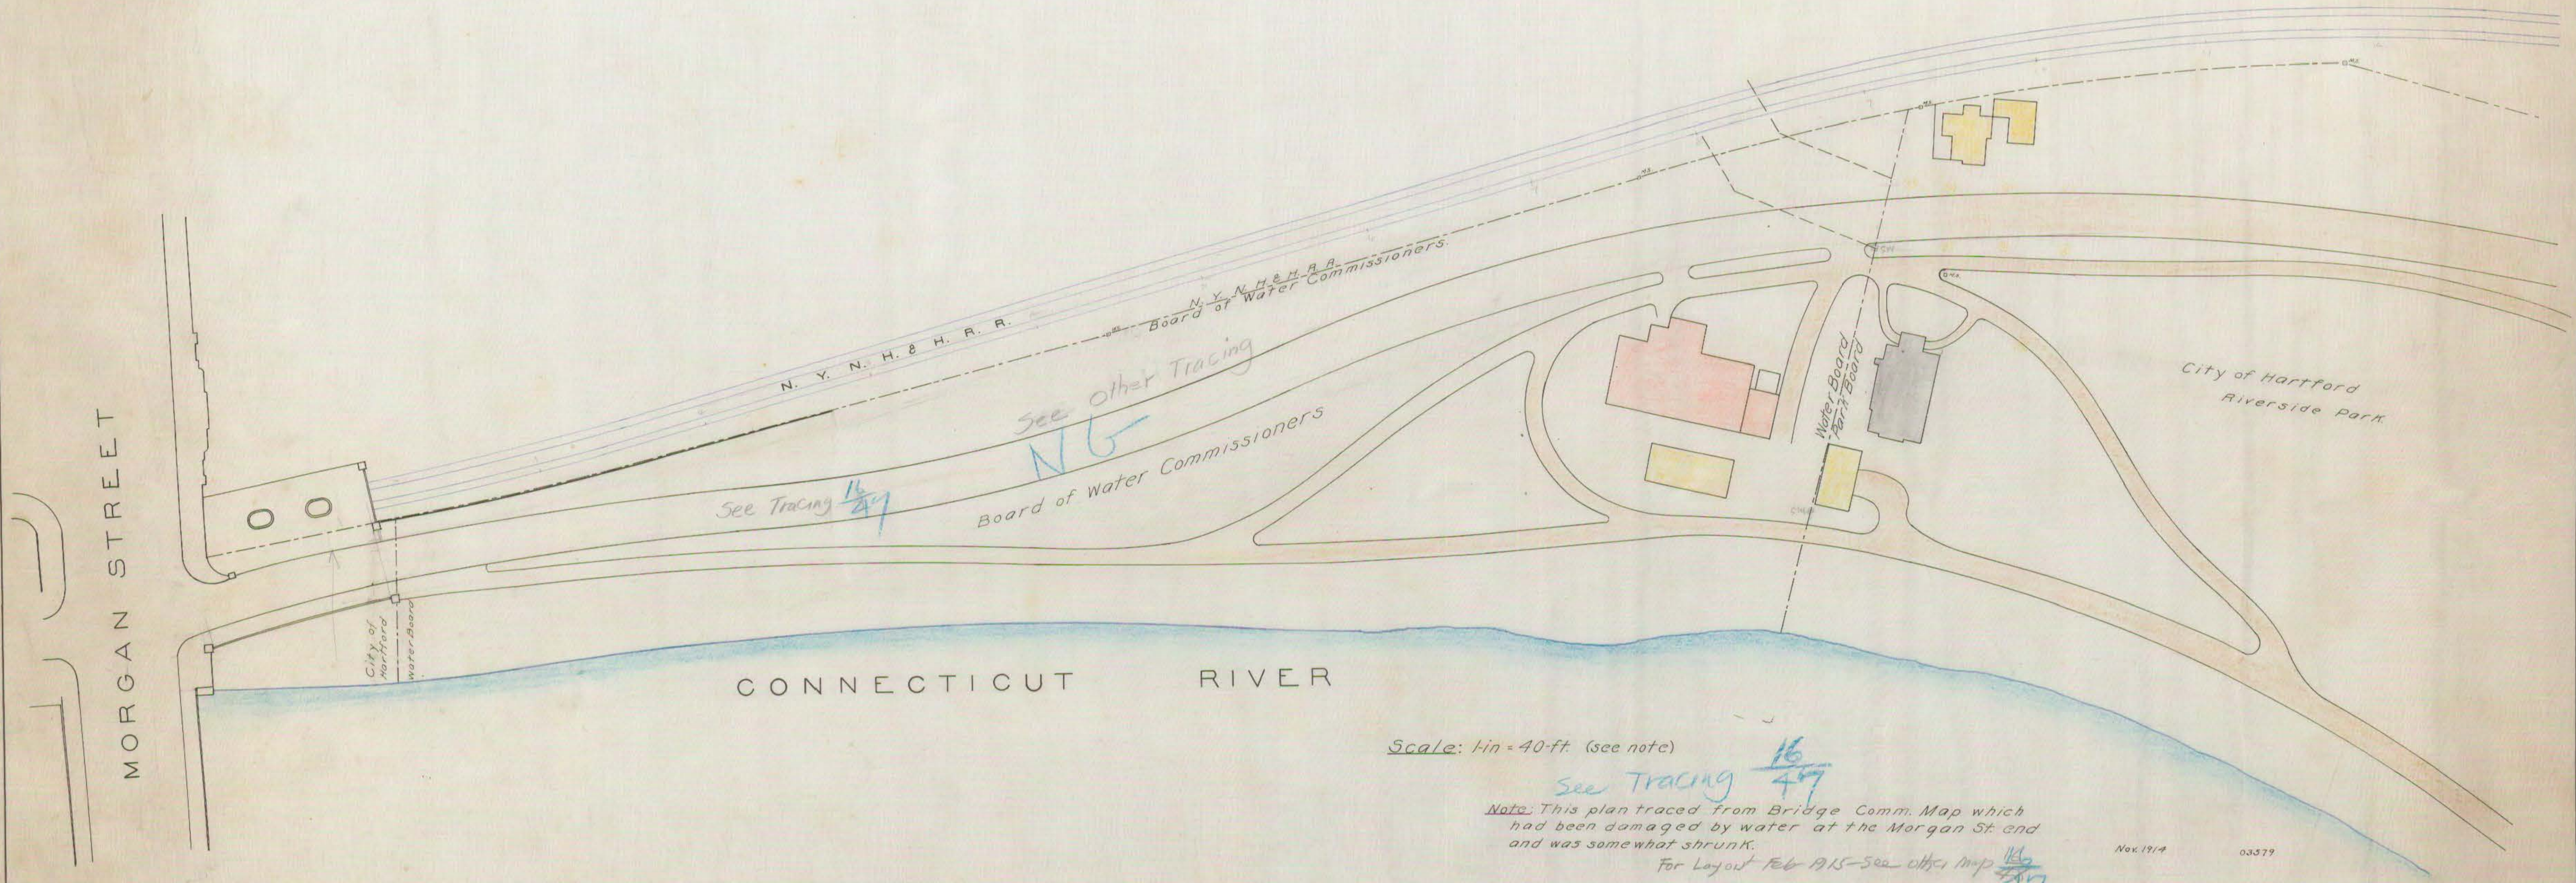

MORGAN STREET

N. Y. N. H. & H. R. R.
Board of Water Commissioners

See other Tracing
N/G
Board of Water Commissioners

See Tracing 16/47

City of Hartford
Water Board

Water Board
Park Board

City of Hartford
Riverside Park

CONNECTICUT RIVER

Scale: 1 in = 40 ft. (see note)

See Tracing 16/47

Note: This plan traced from Bridge Comm. Map which had been damaged by water at the Morgan St end and was somewhat shrunk.

For Layout Feb 1915-See other map 16/47

Nov. 1914

03379