


SHEET 3
DESIGNED BY 25
CHECKED BY 533


1100

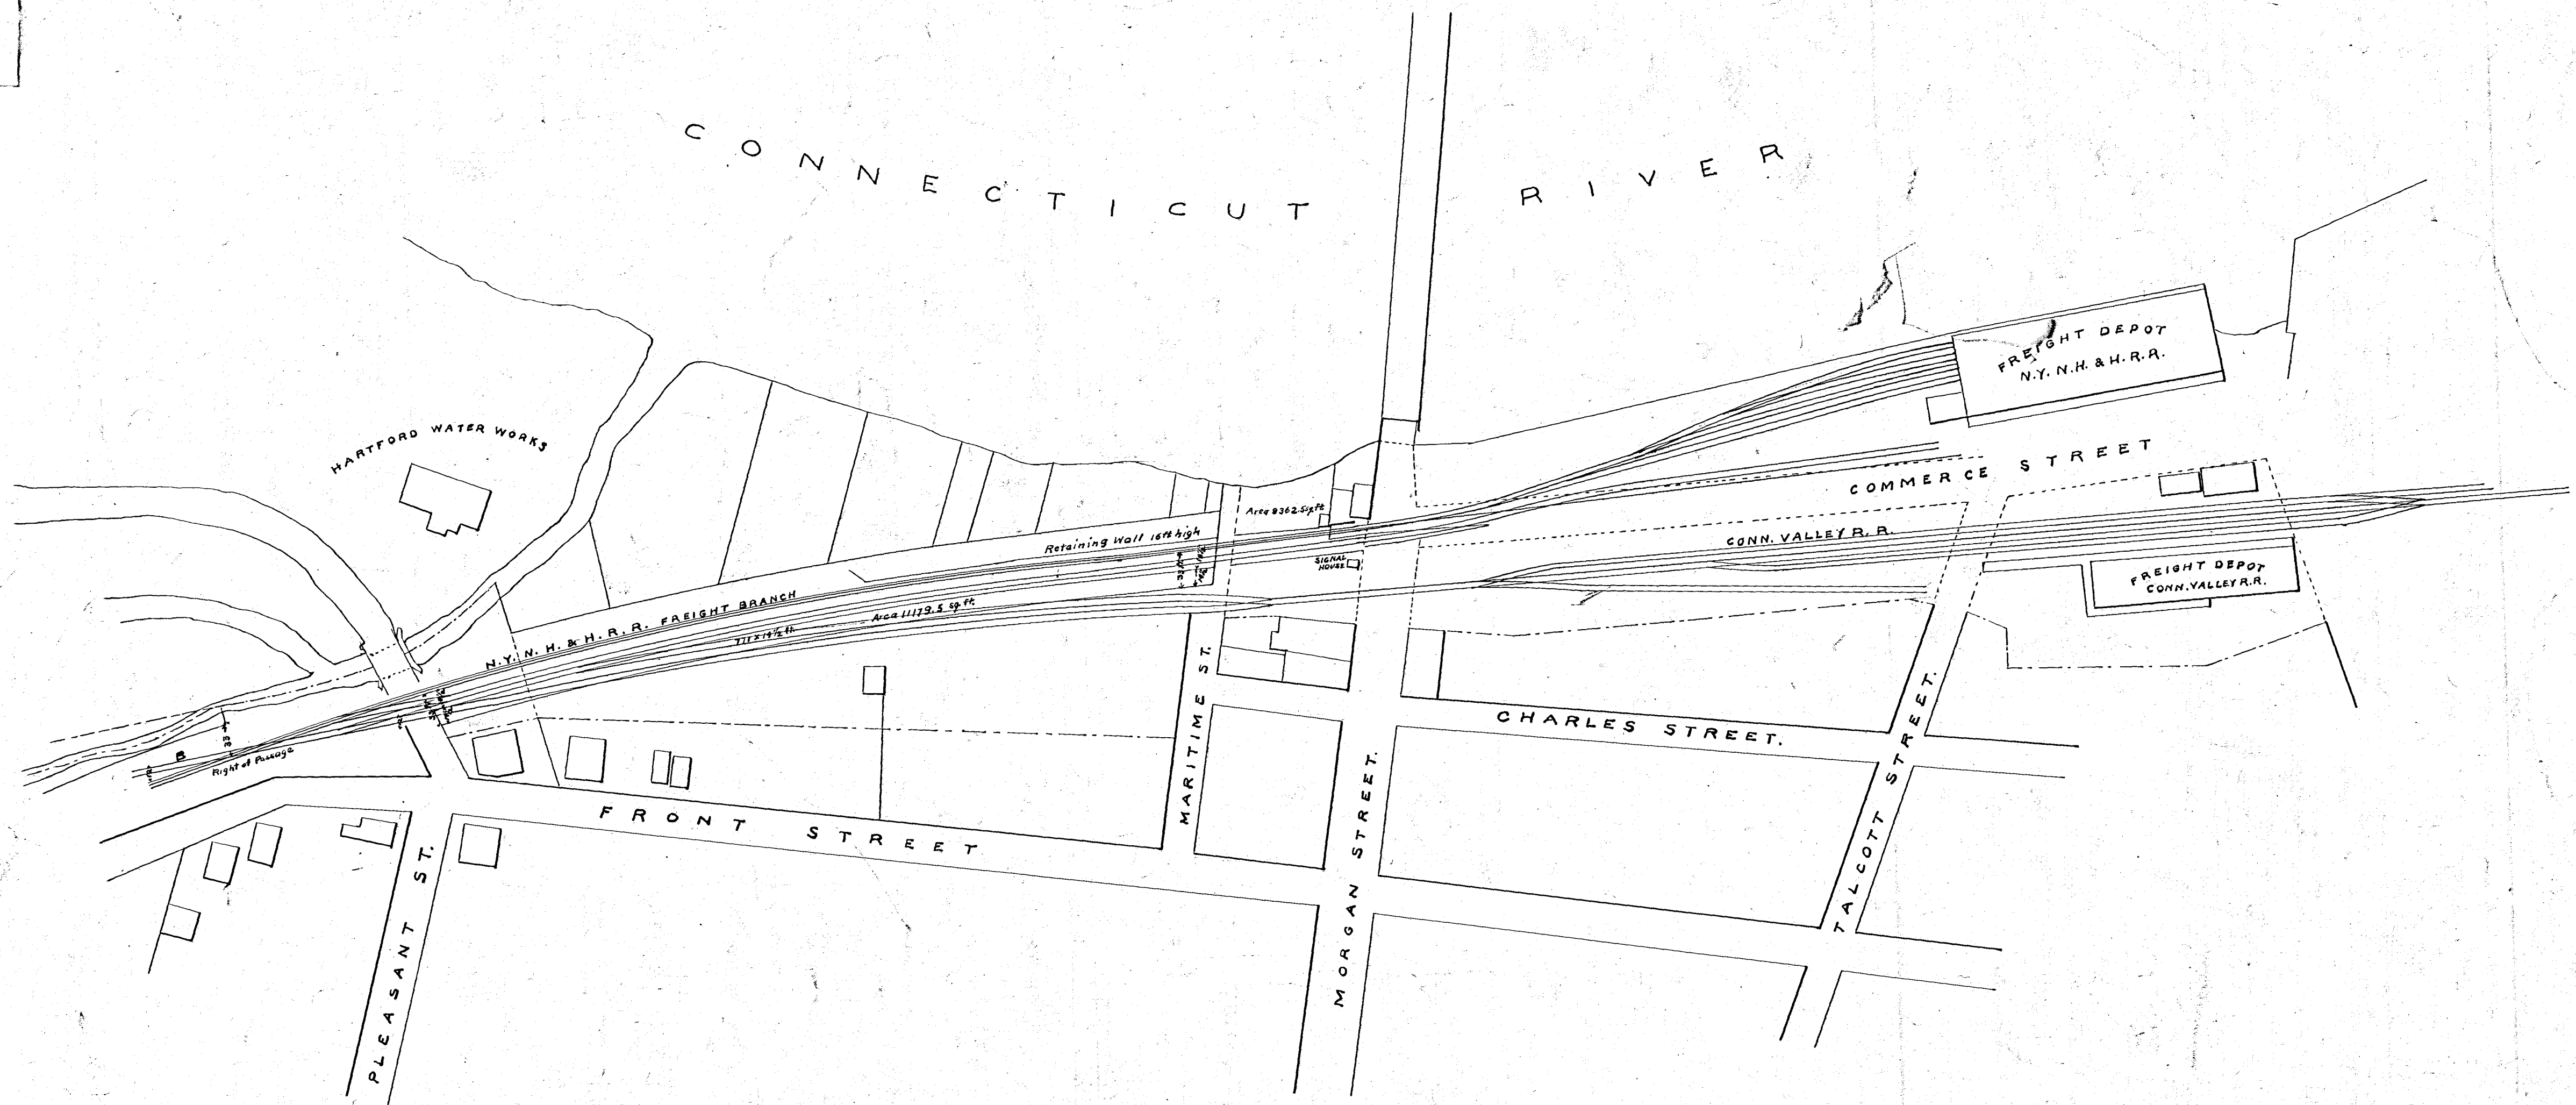

NEW
MAP OF THE

FREIGHT BRANCH RAILROAD
OF THE
N.Y.N.H. & H.R.R. CO.
AT
HARTFORD.

AS IT EXISTED MAY 6TH 1880.
SCALE 100 FT. TO 1 INCH.
0338

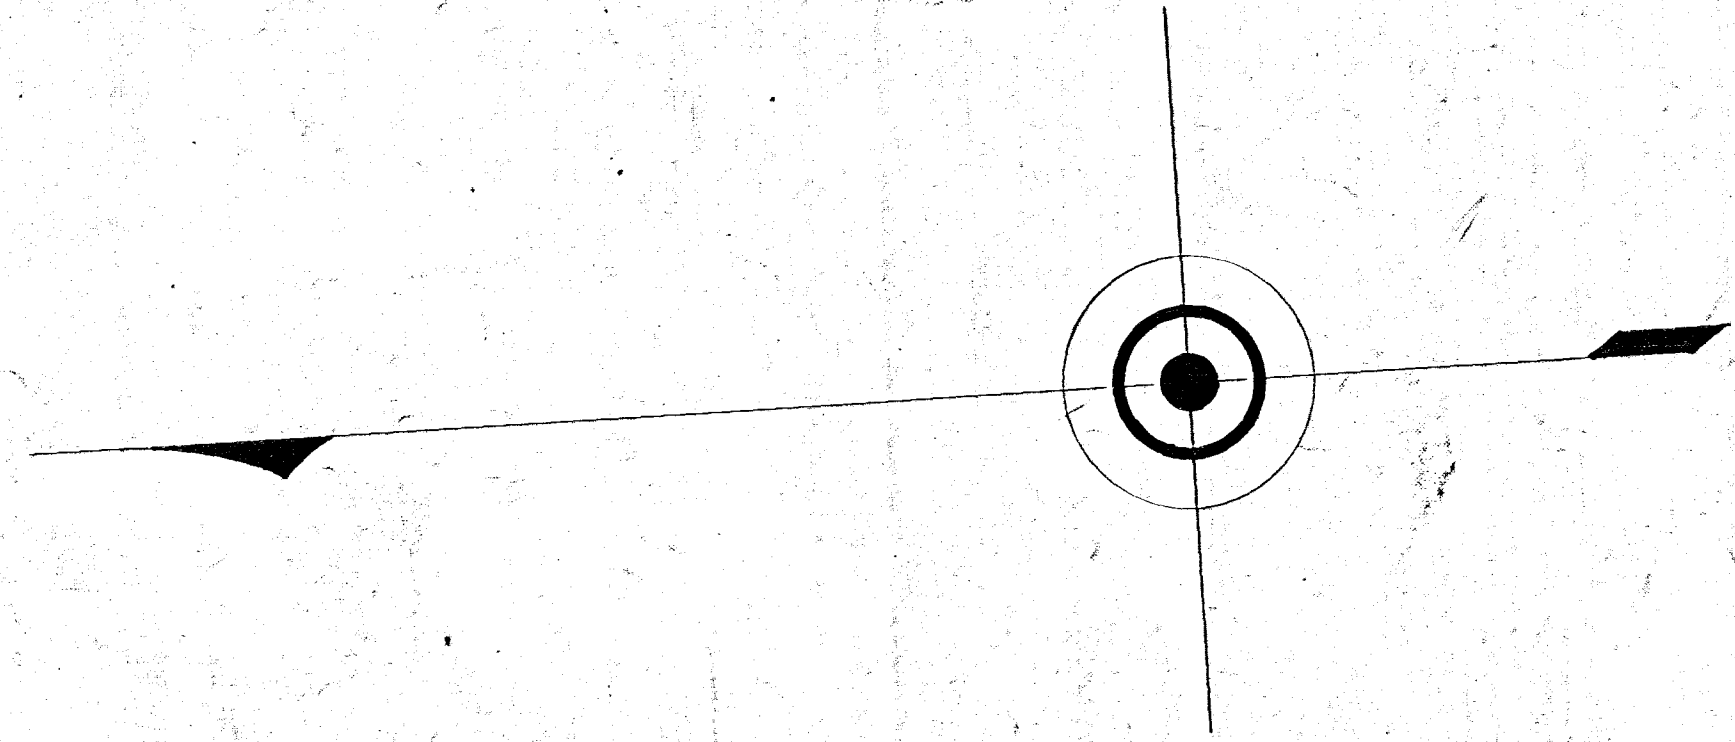

1100

1100

533
50
8