



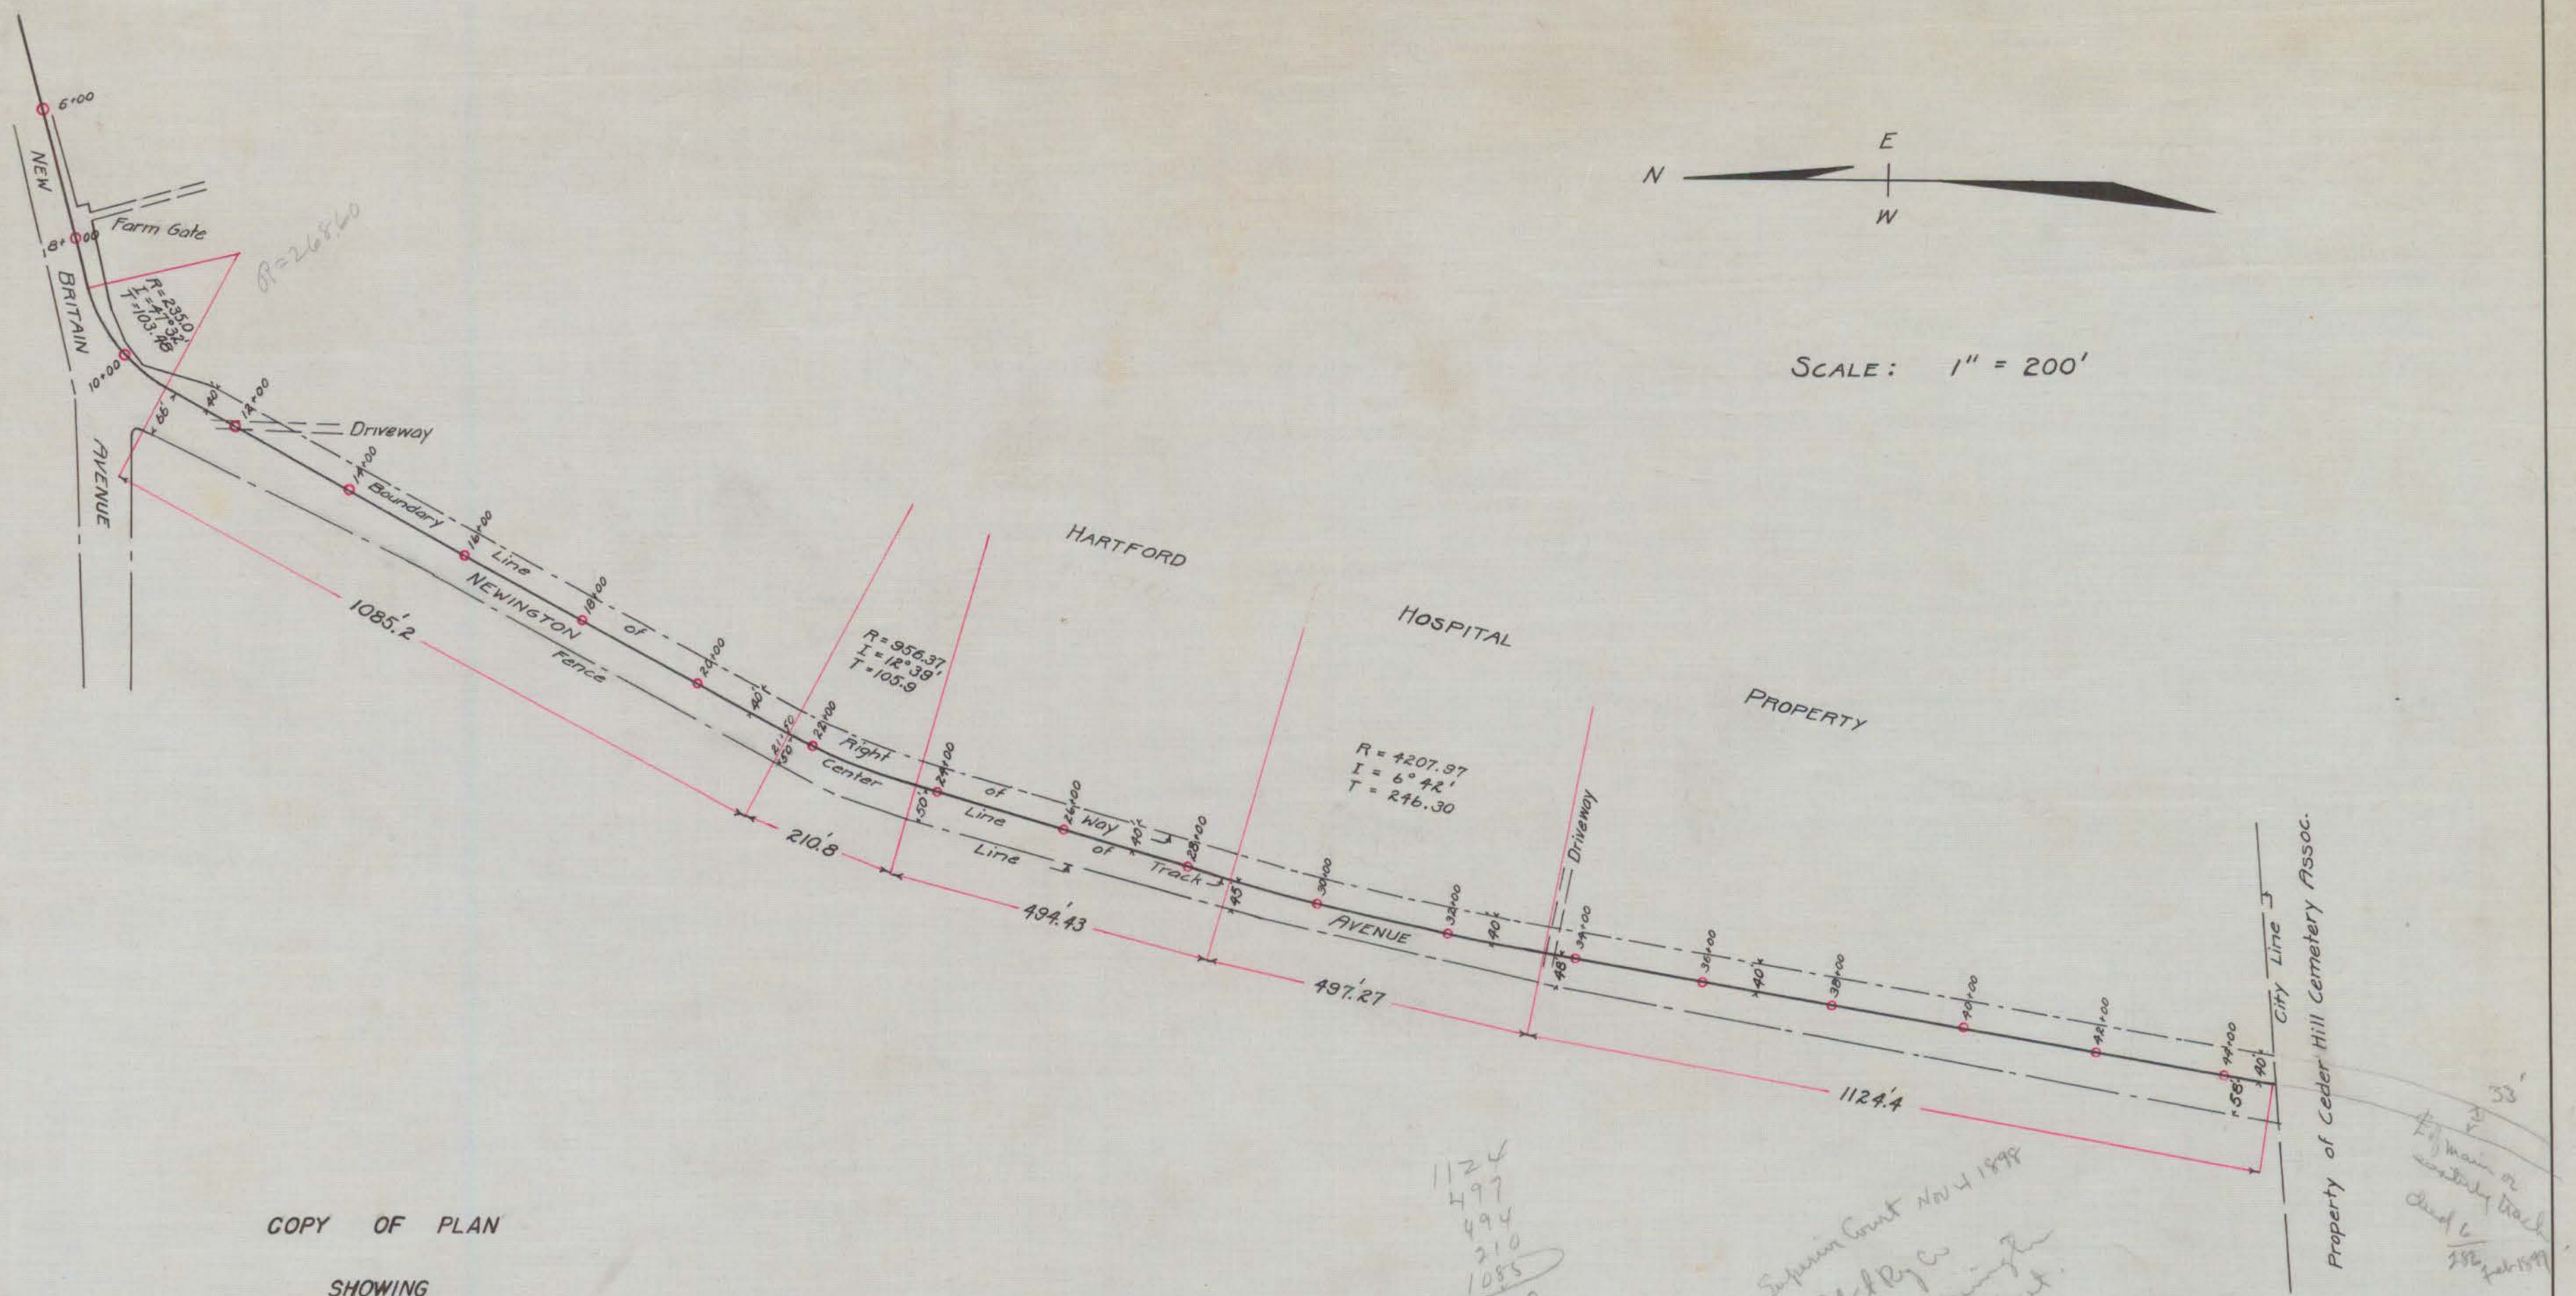

COPY OF PLAN
SHOWING
RIGHT OF WAY OF CONNECTICUT CO.
NEWINGTON AVE., HARTFORD

RECORDED LAND RECORDS JAN. 6, 1898 VOL. 259, PAGE 30.
Sept 1 - 1897
Revised Jan 1916

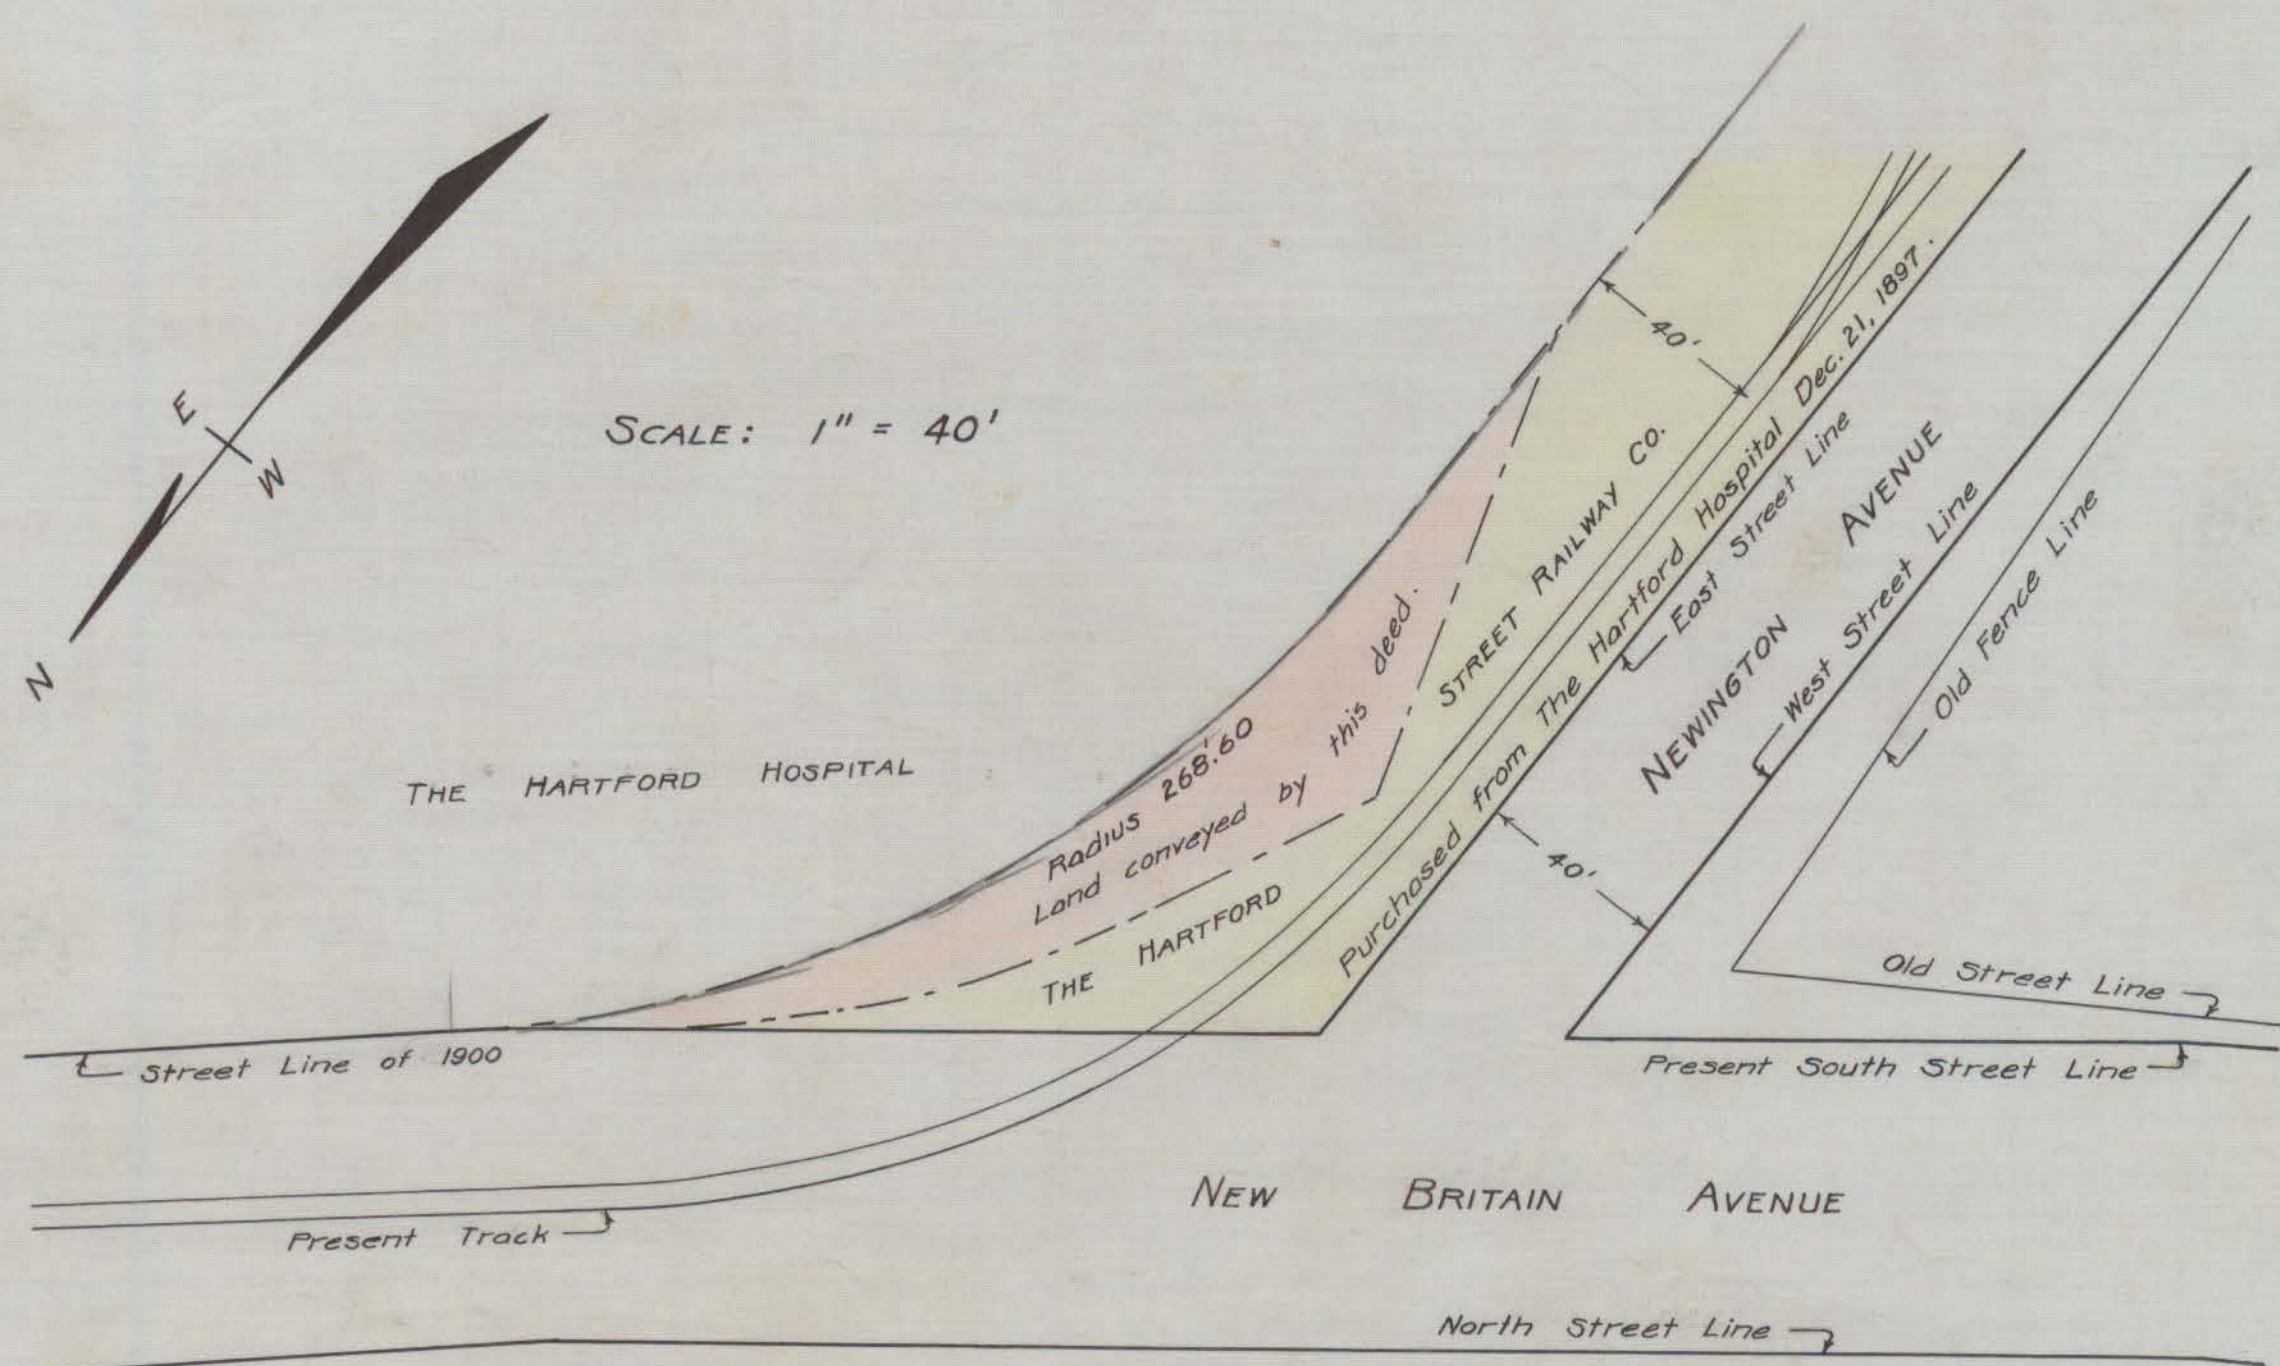

COPY OF PLAN
SHOWING
RIGHT OF WAY OF CONNECTICUT CO.
NEWINGTON AVE., HARTFORD

RECORDED LAND RECORDS SEPT. 11, 1907 VOL. 323, PAGE 589.