



17

17

17

ST.



PUTNAM

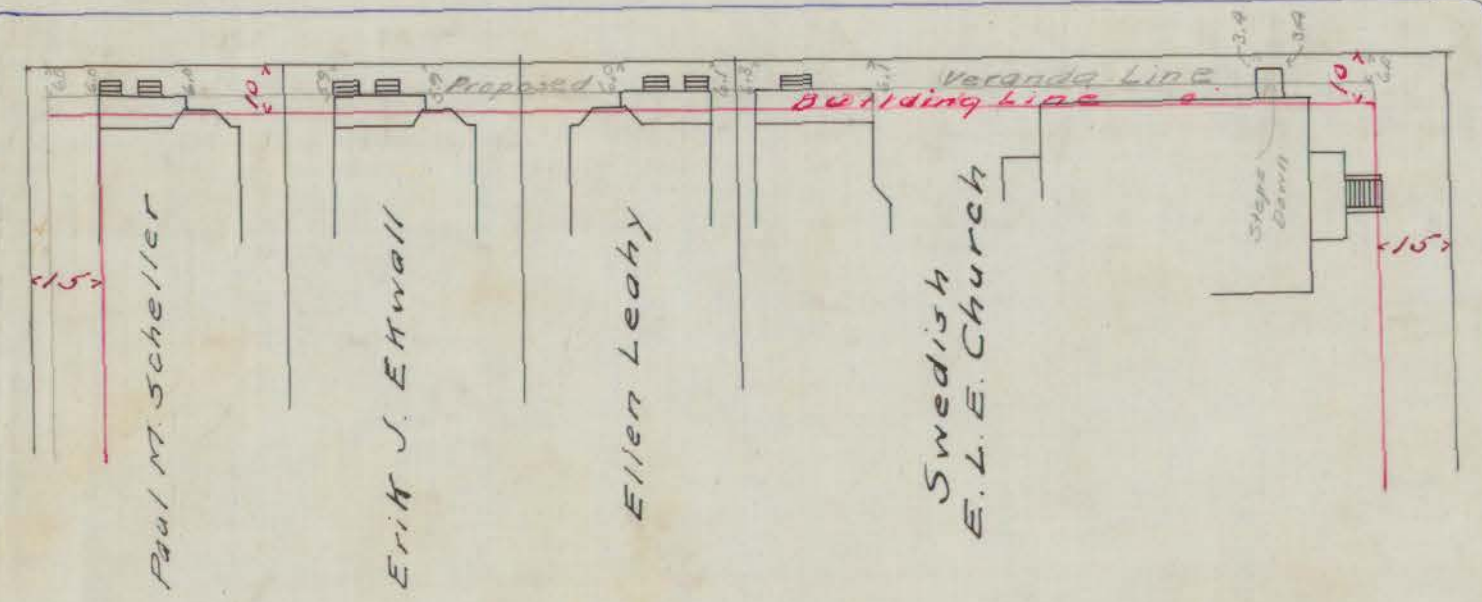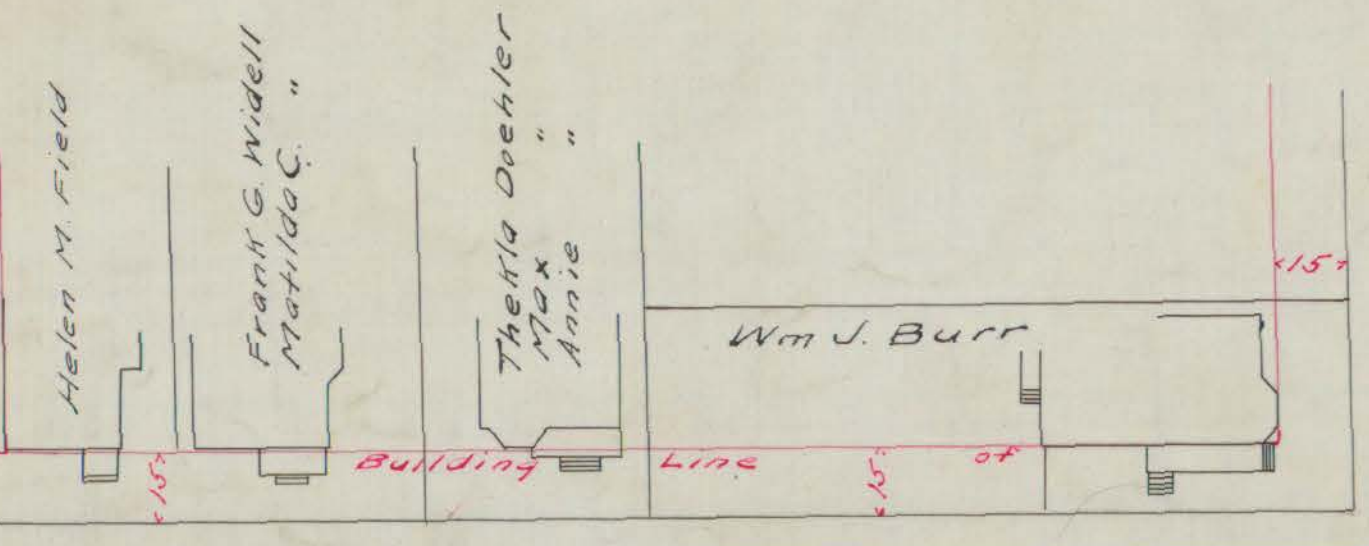

RUSS

ST.

BABCOCK

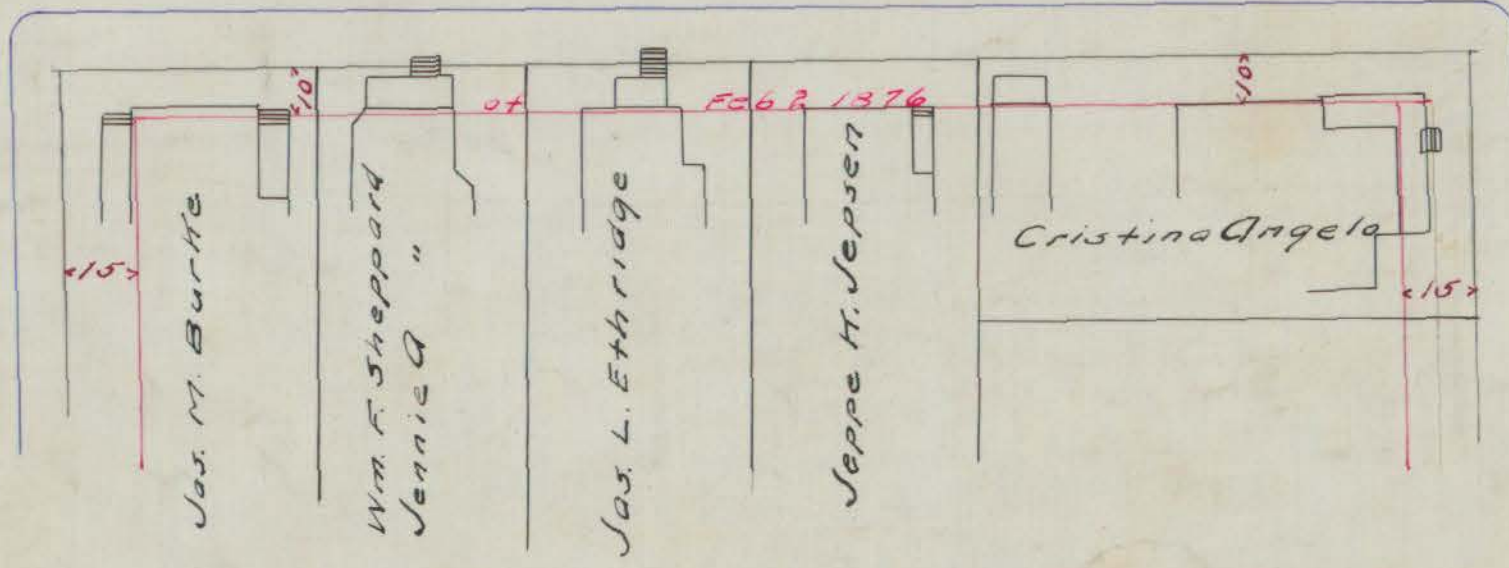
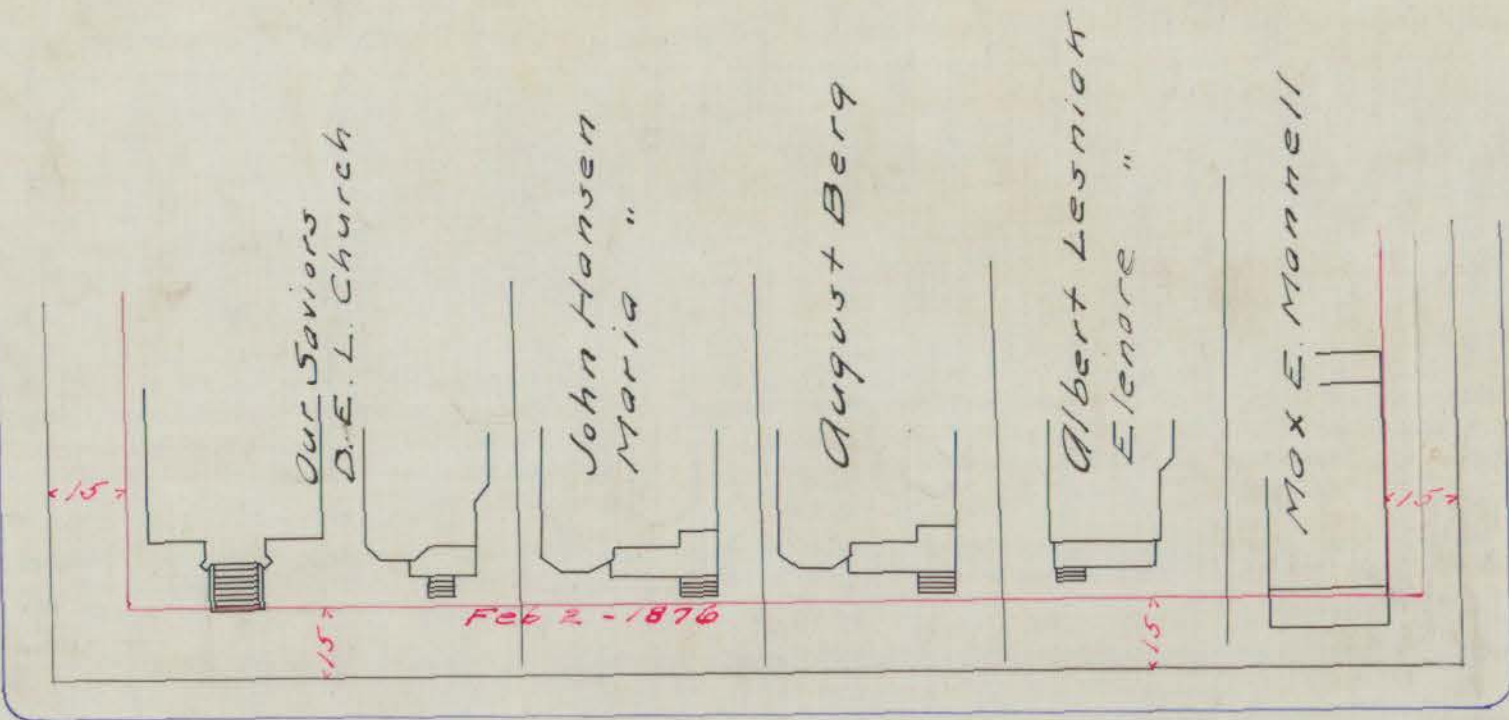


STREET

SCALE 1" = 40'

ST.

LAWRENCE

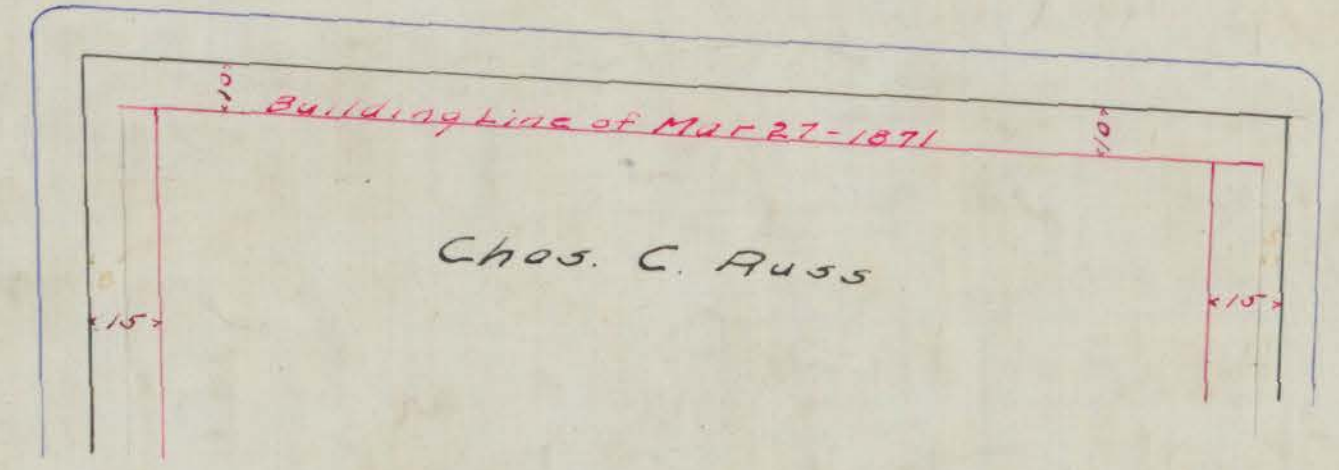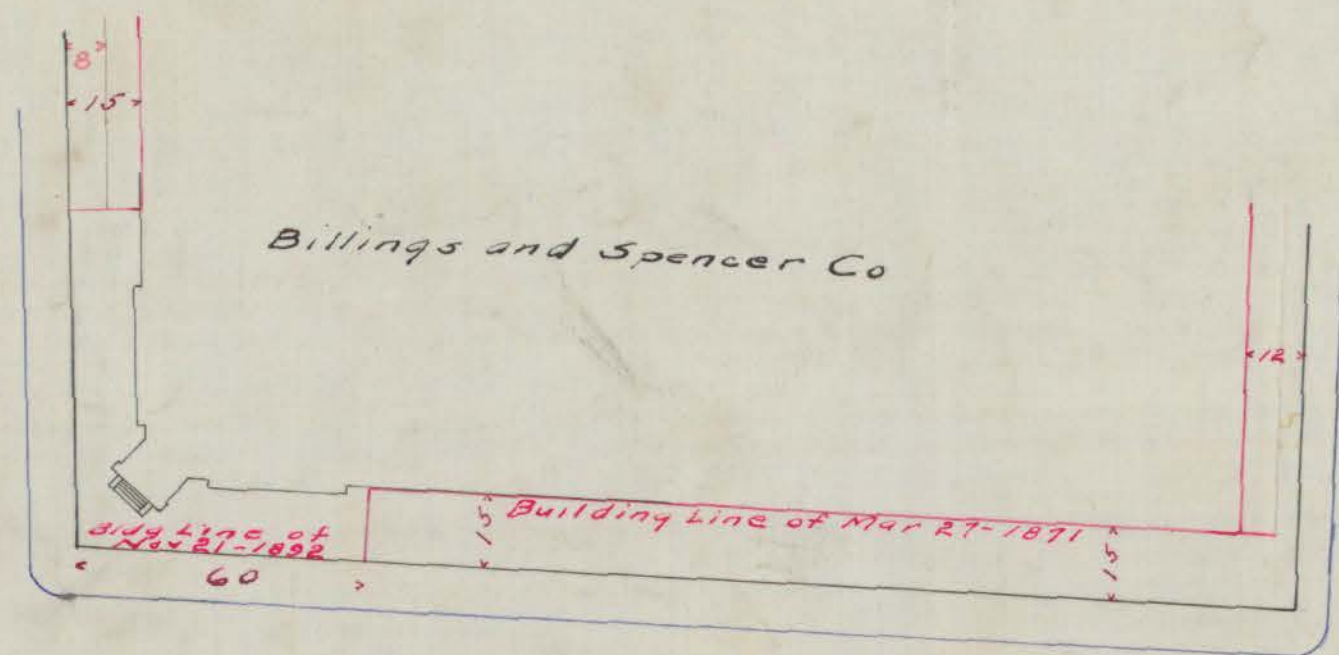

ST.

BROAD

OFFICE OF CITY ENGINEER
HARTFORD, CONN.
Dec. 8, '09
02310