


FRANCIS AVENUE

Scale 1" = 40'

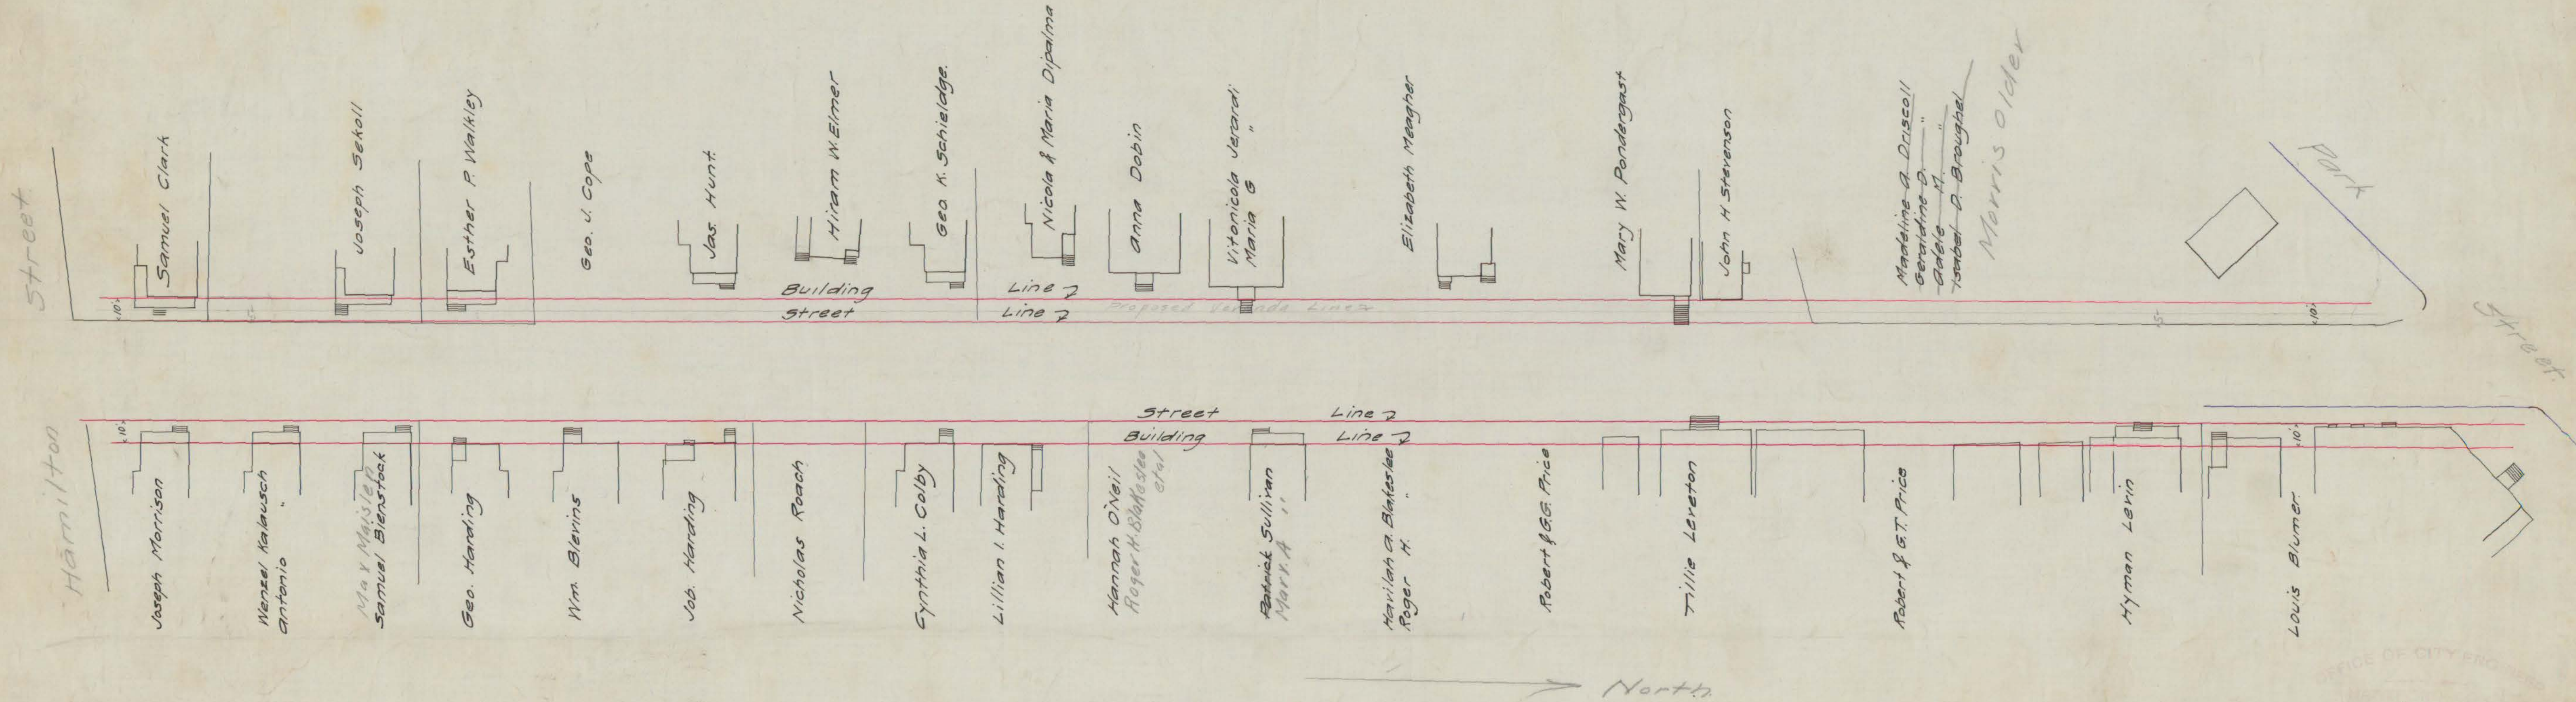

OFFICE OF CITY ENGINEER

Dec 8, 1920

02311