


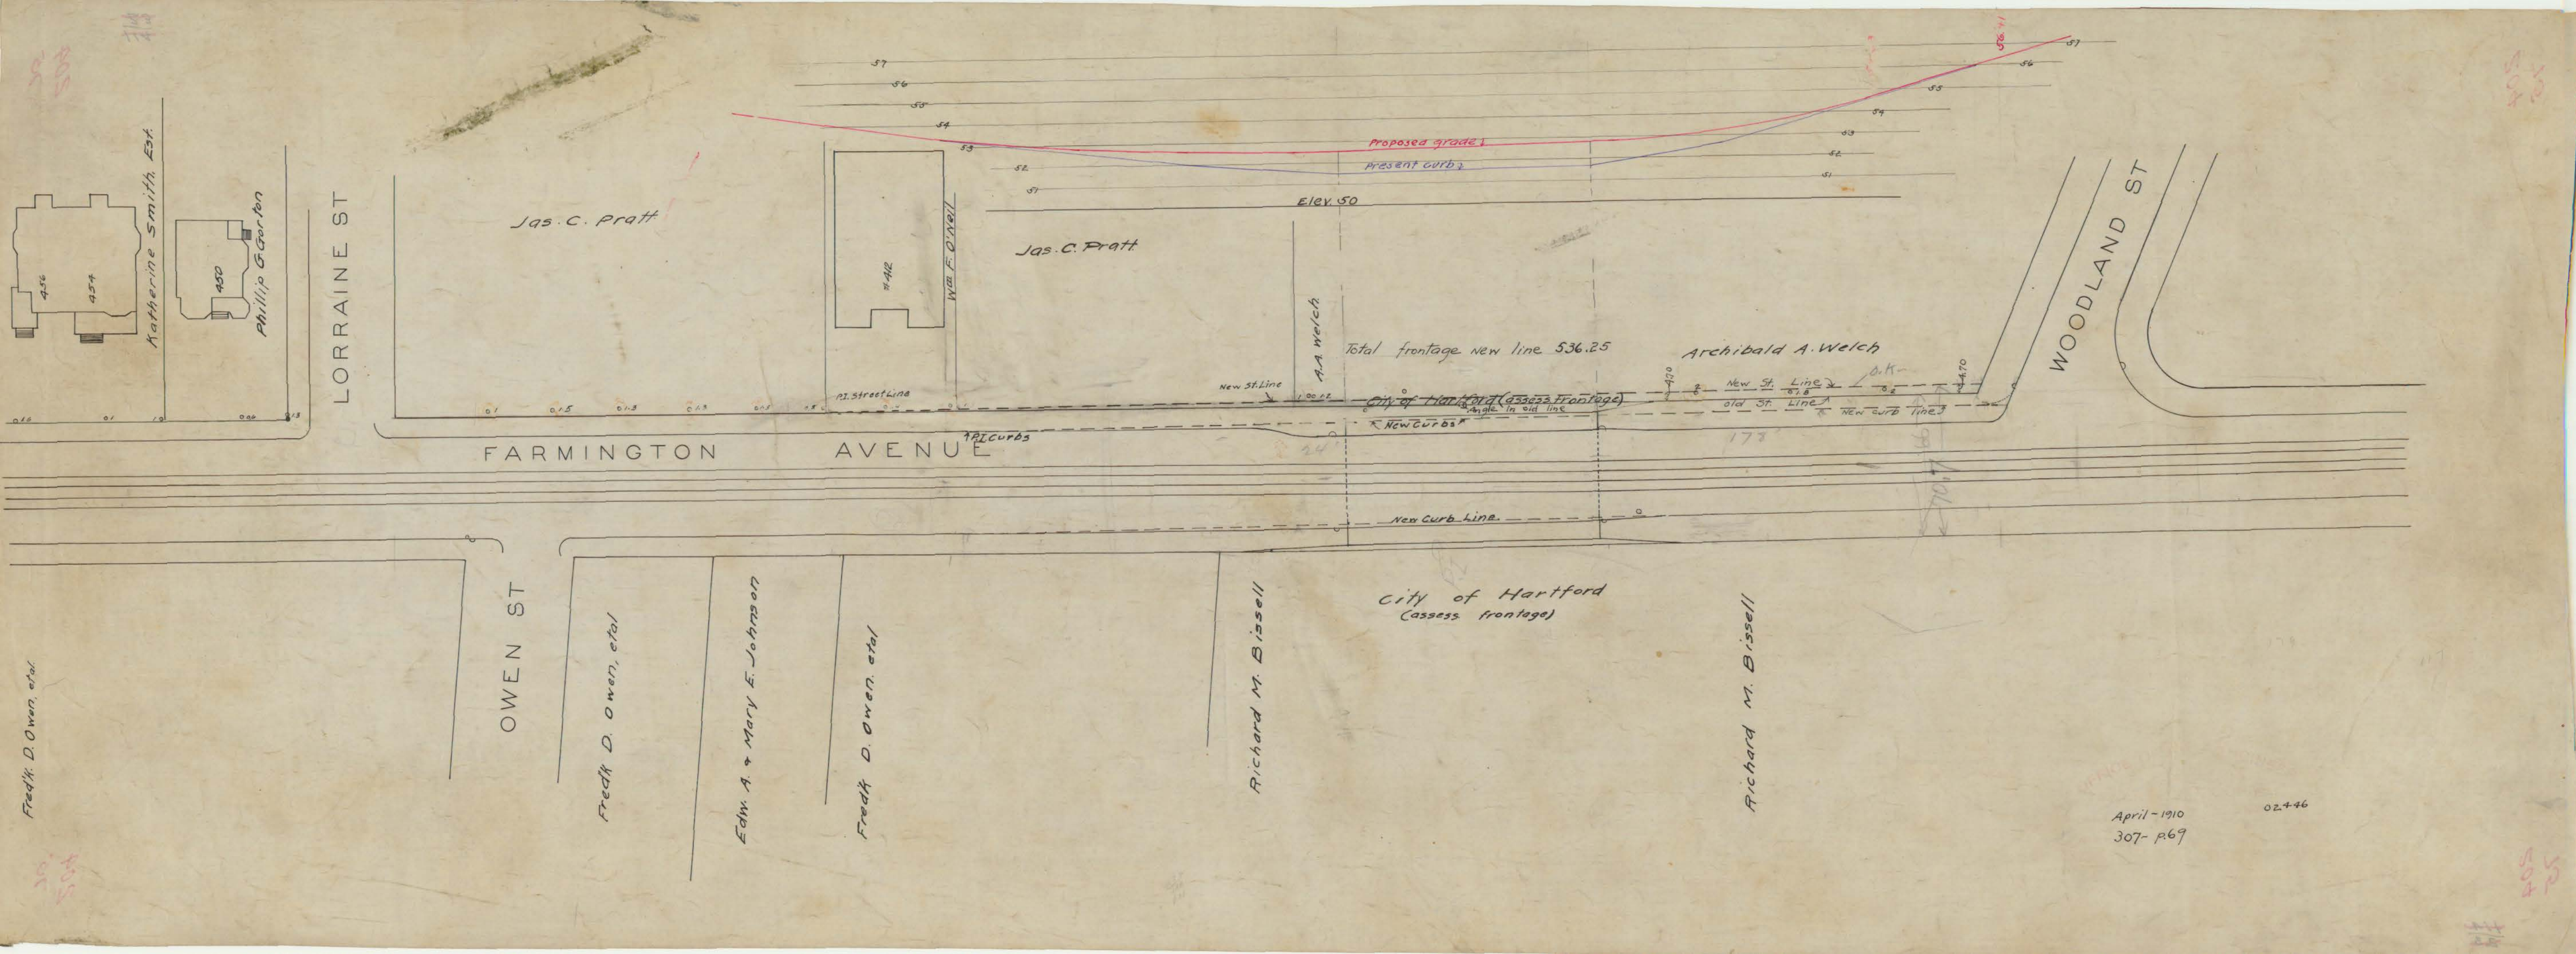

April - 1910
307- p.69

02446