


Profile of Prospect Street from Atheneum St. to Arch Street

B.M. S.E. Cor. base of Iron Post on
N.W. Cor. of Grove & Prospect Sts El. 57.86
Stations measured at elevation of and on top of
East Curb from N. Line of Atheneum St.

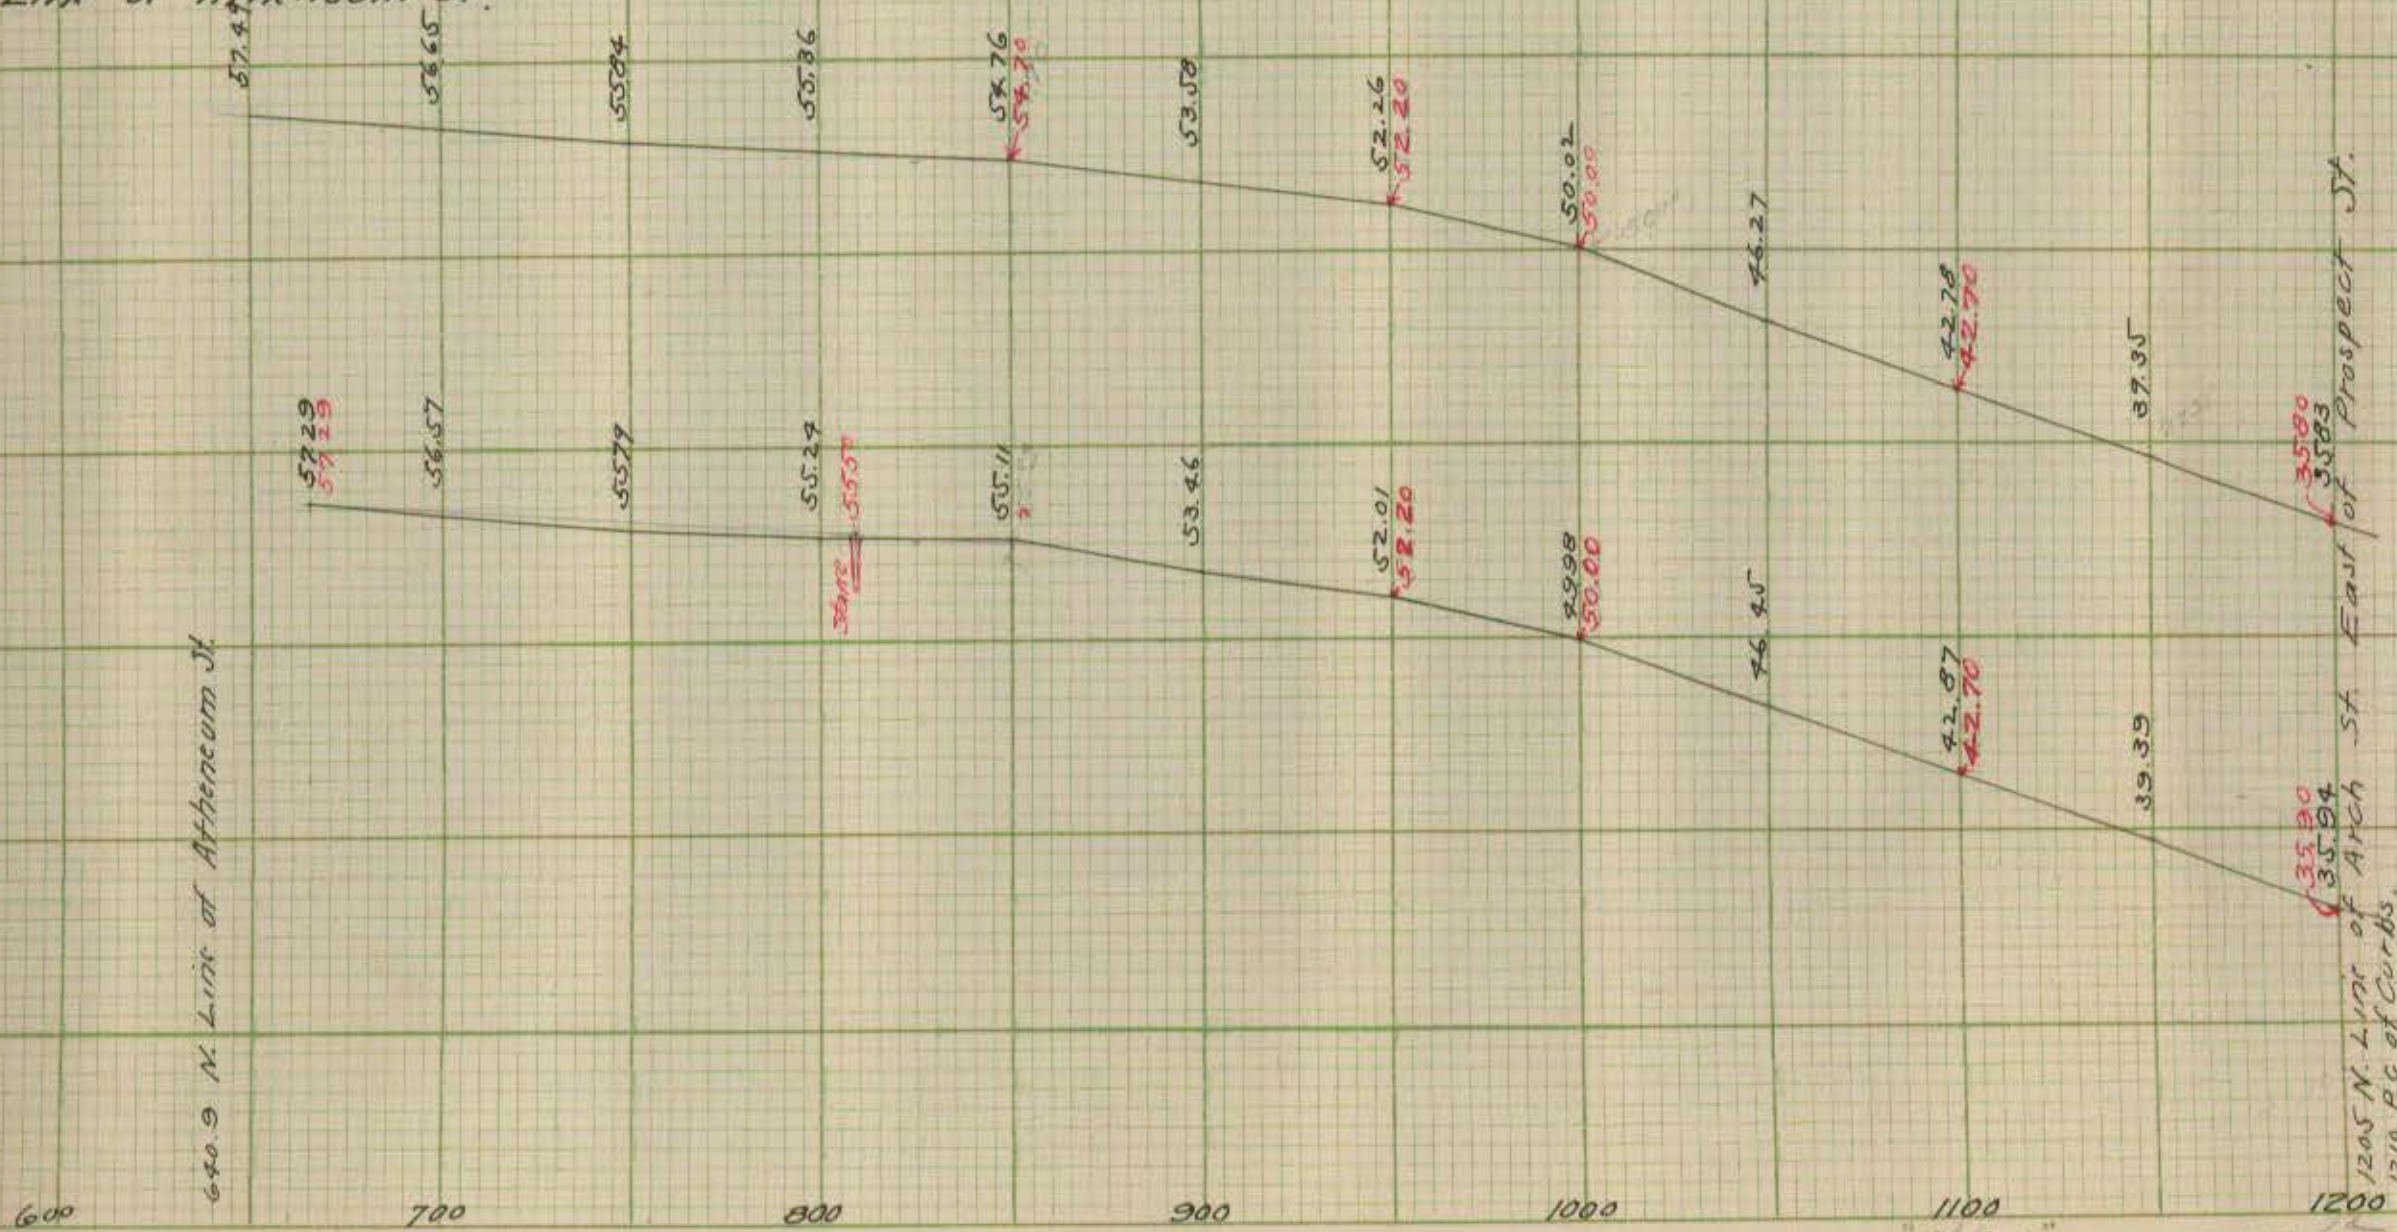

640.9 N. Line of Atheneum St.

1205 N. Line of Arch St. East of Prospect St.
1210 P.C. of Curbs.