


POTTER STREET.

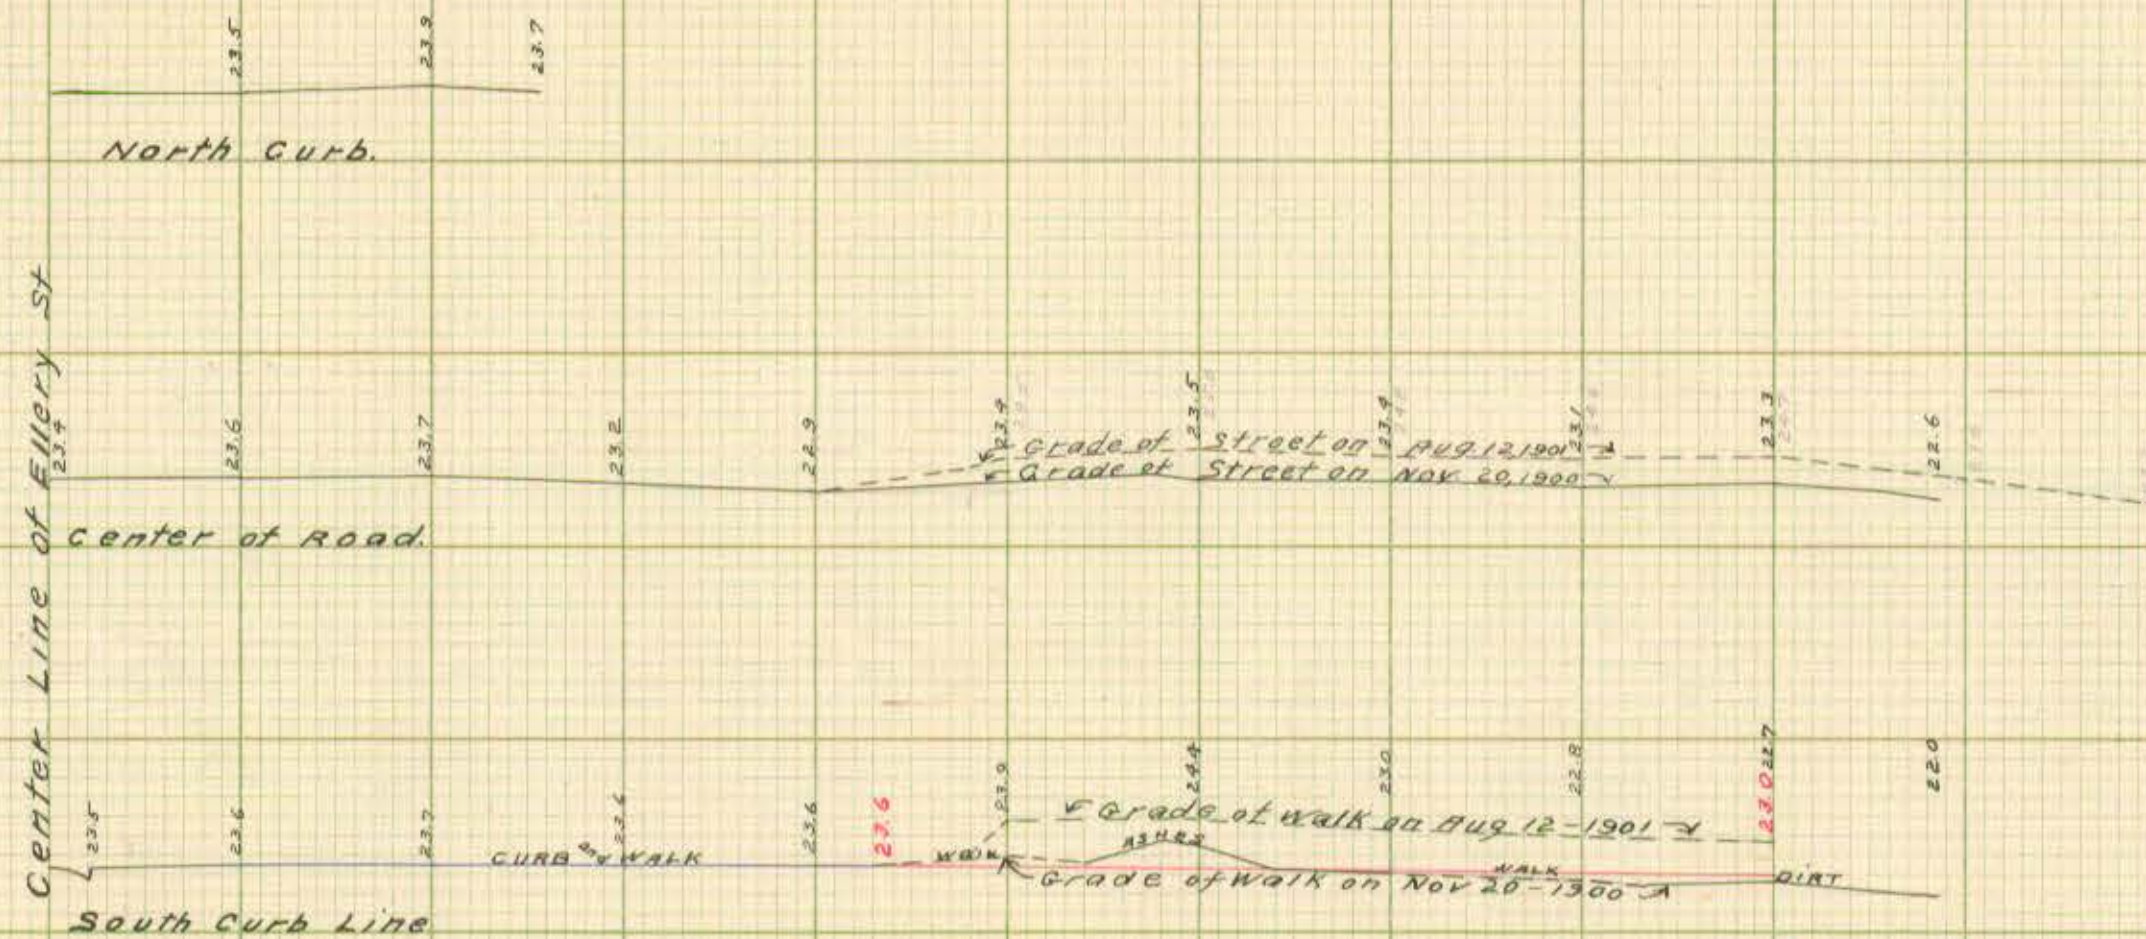

CITY ENGINEER'S OFFICE,
HARTFORD, CONN.

STREET & MISCELLANEOUS DEP'T.

Date Nov. 22, 1900 Day Book No. 0583

Notes: _____

