


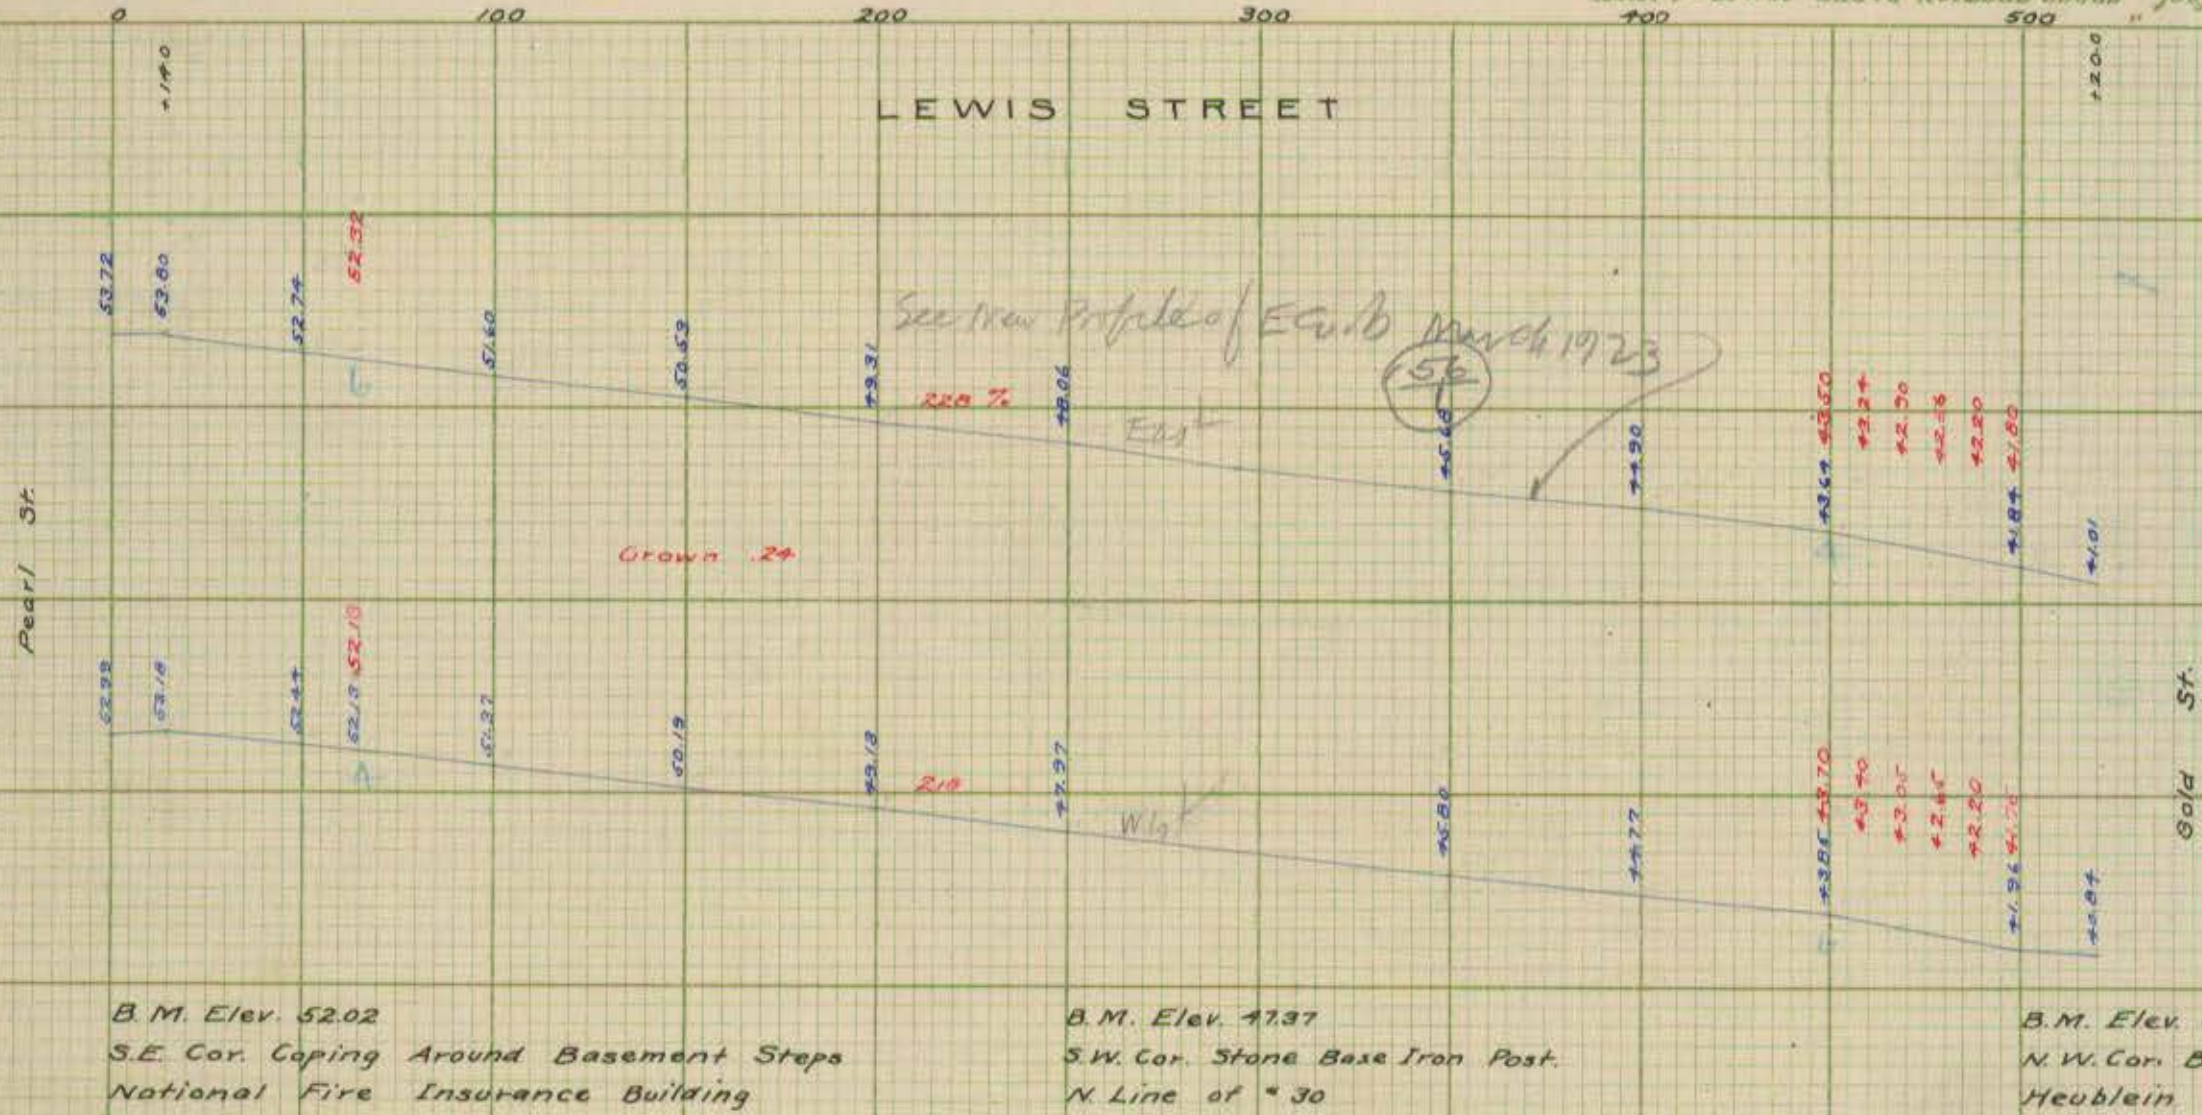

B.M. Elev. 52.02
S.E. Cor. Coping Around Basement Steps
National Fire Insurance Building

B.M. Elev. 47.37
S.W. Cor. Stone Base Iron Post.
N. Line of " 30

B.M. Elev. 39.92
N.W. Cor. Bottom Step
Heublein Hotel