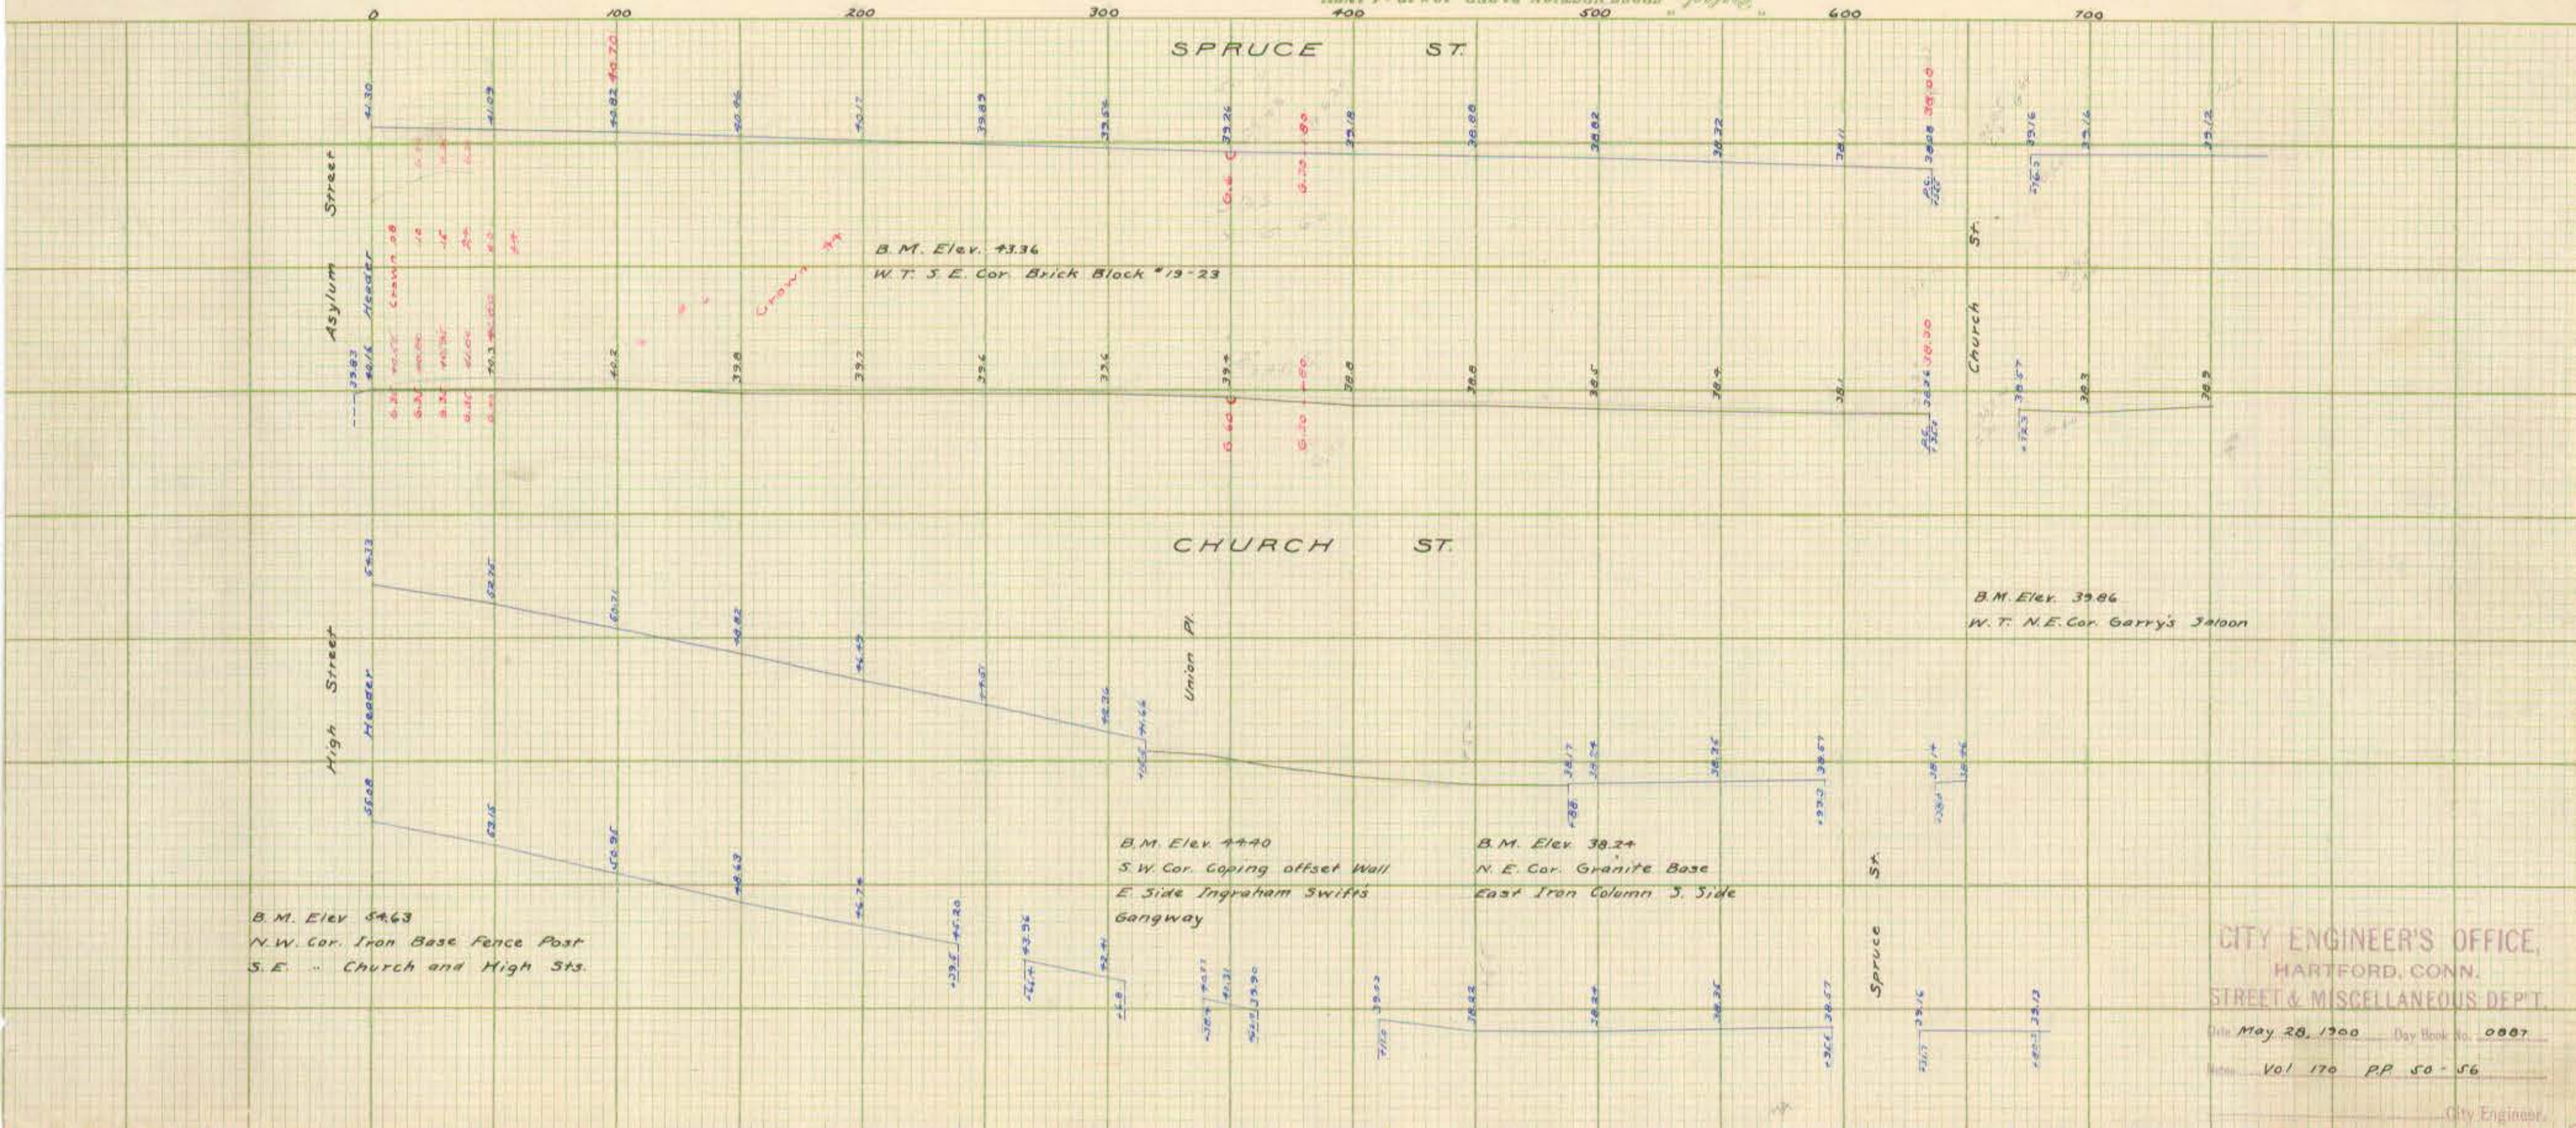
Ruled CROSS SECTION PAPER, 10 × 10 - 1 INCH.
0
100
200
300
400
500
600
700
SPRUCE ST.
Asylum Street
Header
B.M. Elev. 43.36
W.T. S.E. Cor. Brick Block #19-23
Church St.
CHURCH ST.
High Street
Header
Union Pl.
B.M. Elev. 39.86
W.T. N.E. Cor. Garry's Saloon
B.M. Elev. 44.40
S.W. Cor. Coping offset Wall
E. Side Ingraham Swifts
Gangway
B.M. Elev. 38.24
N.E. Cor. Granite Base
East Iron Column S. Side
Spruce St.
B.M. Elev. 54.63
N.W. Cor. Iron Base Fence Post
S.E. " Church and High Sts.
CITY ENGINEER'S OFFICE,
HARTFORD, CONN.
STREET & MISCELLANEOUS DEP'T.
Date May 28, 1900 Day Book No. 0887
Notes Vol 170 PP 50 - 56
City Engineer.