

PROFILE OF GRANDVIEW TERRACE

Hor. scale 1" = 40'

Vert. " 1" = 4'


Sec. = 1000 ft
Tang. = 0.2866

Tang. = 0.1414
Sec. = 1.00795

AVE. = (133)

LINNMOORE

WHITE STREET = (50)

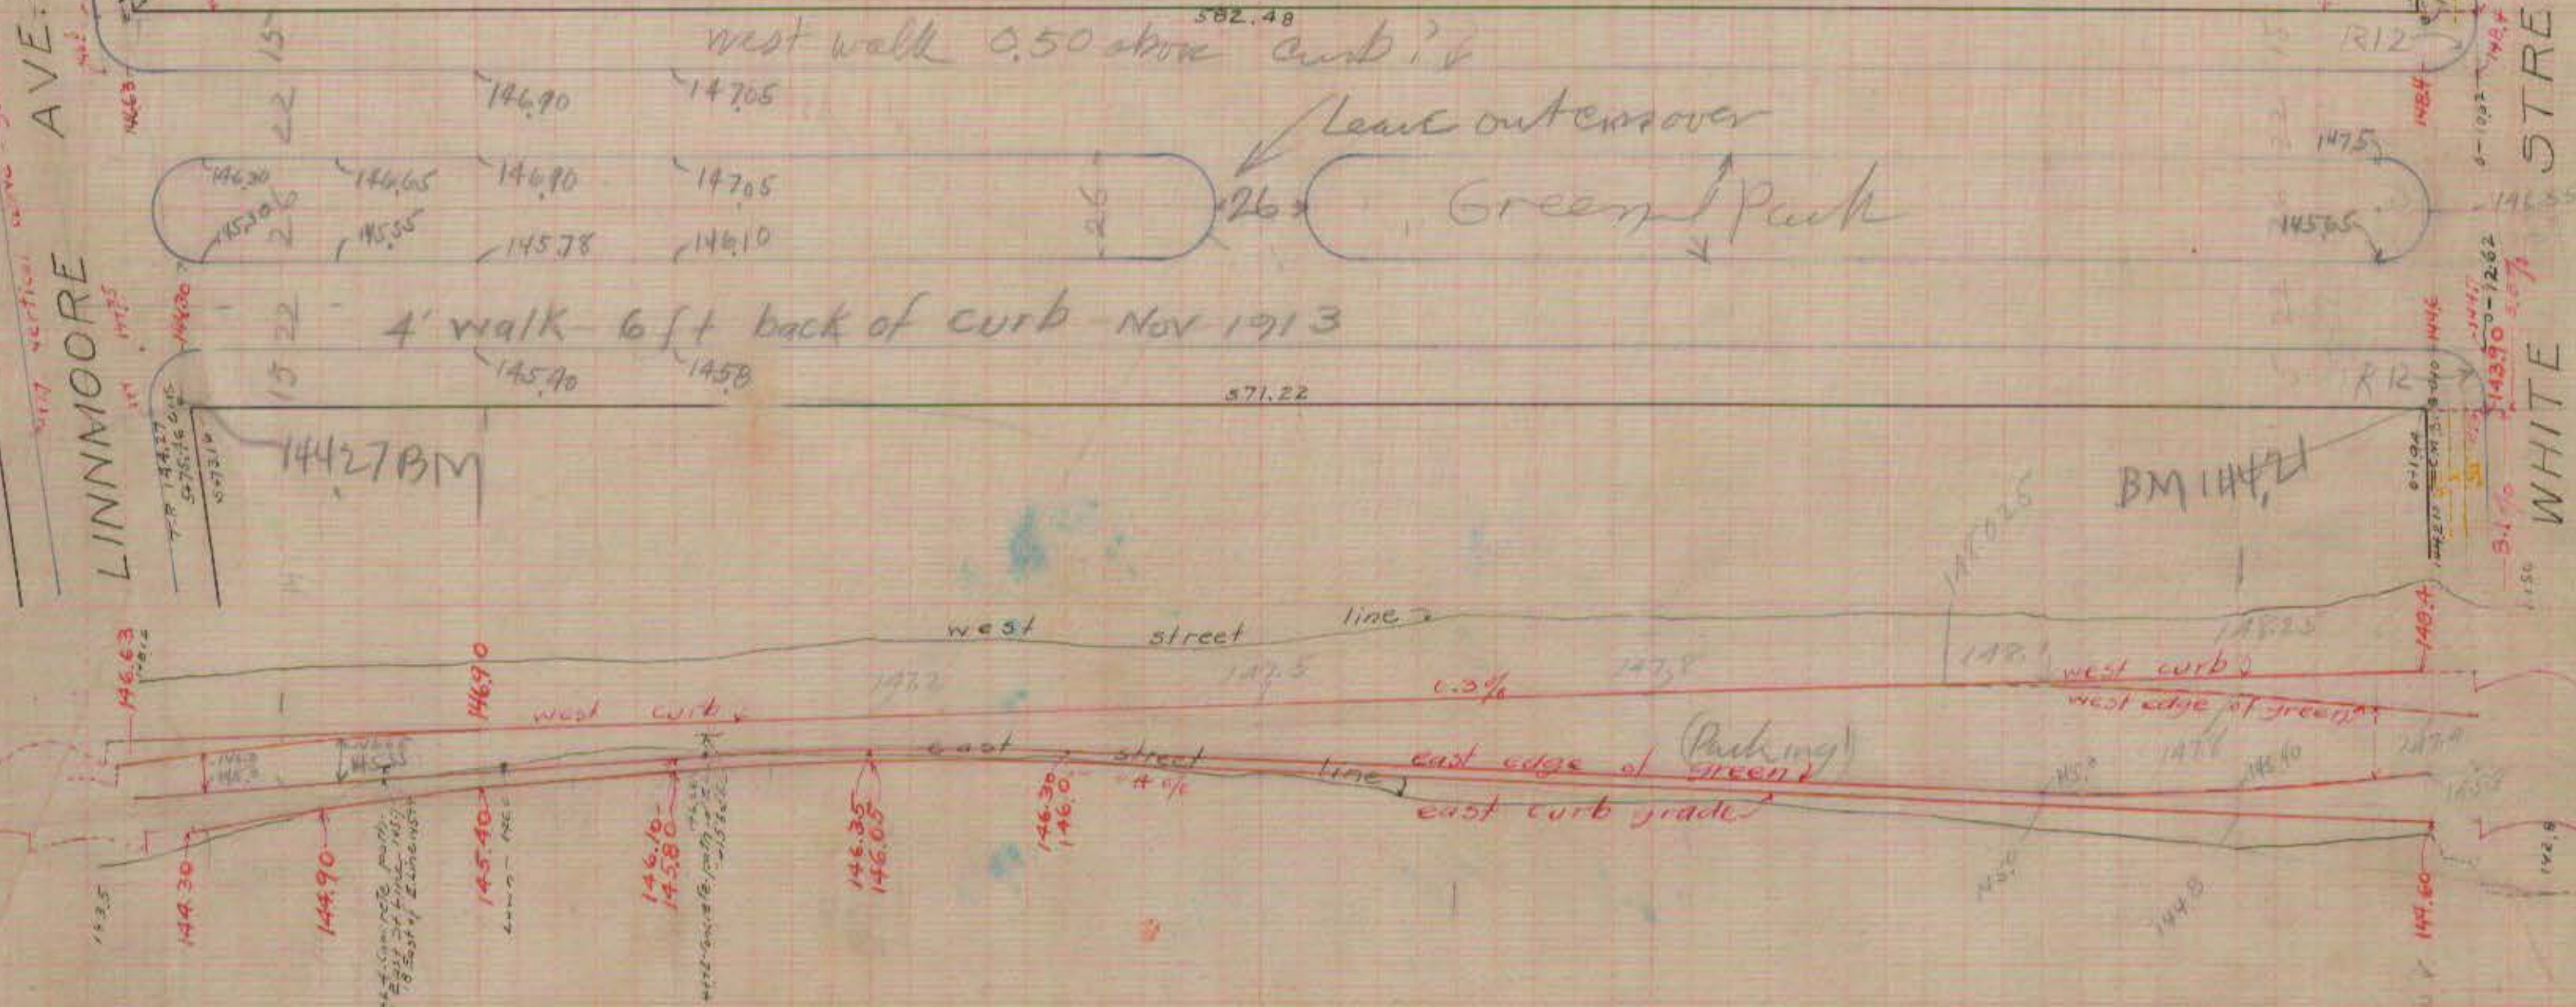

(Do not take out of office)
see blue prints

207
4 A

207
4 A

140