# GARDEN STREET
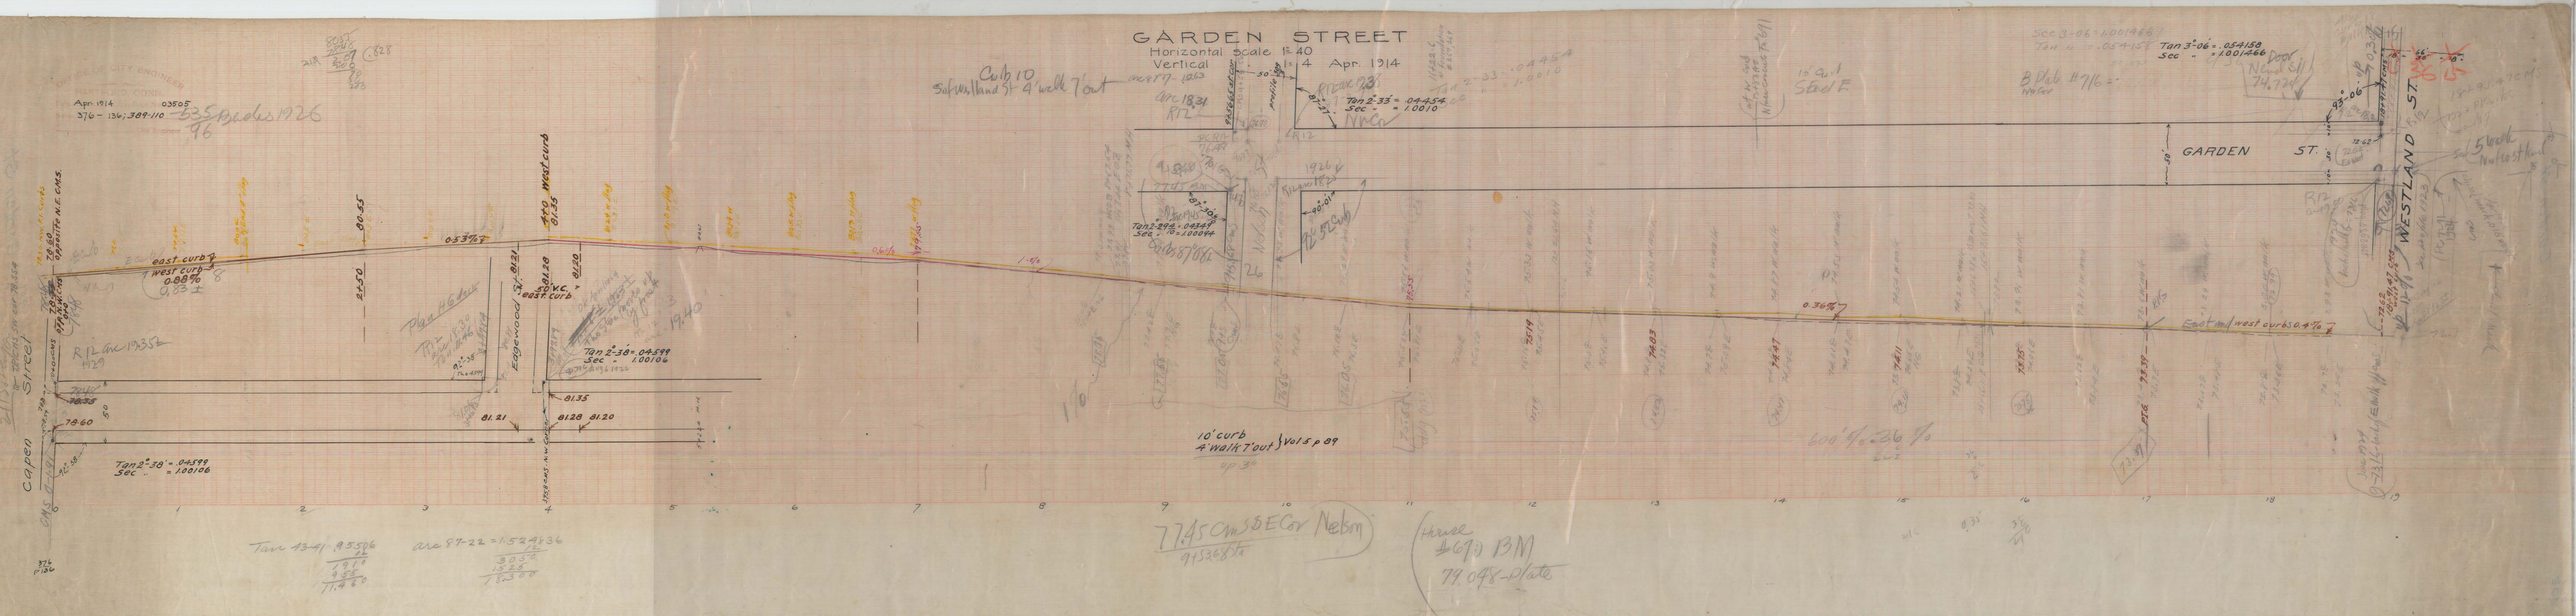
Horizontal scale 1" = 40
Vertical " = 4
Apr. 1914