

THE BOULEVARD



See Map
Capital A.E. Ext.

Scale 1" = 40'
V4-P369
Profile 207

6' walk 7' out
Curb 12 1/2

AVENUE

SISSON

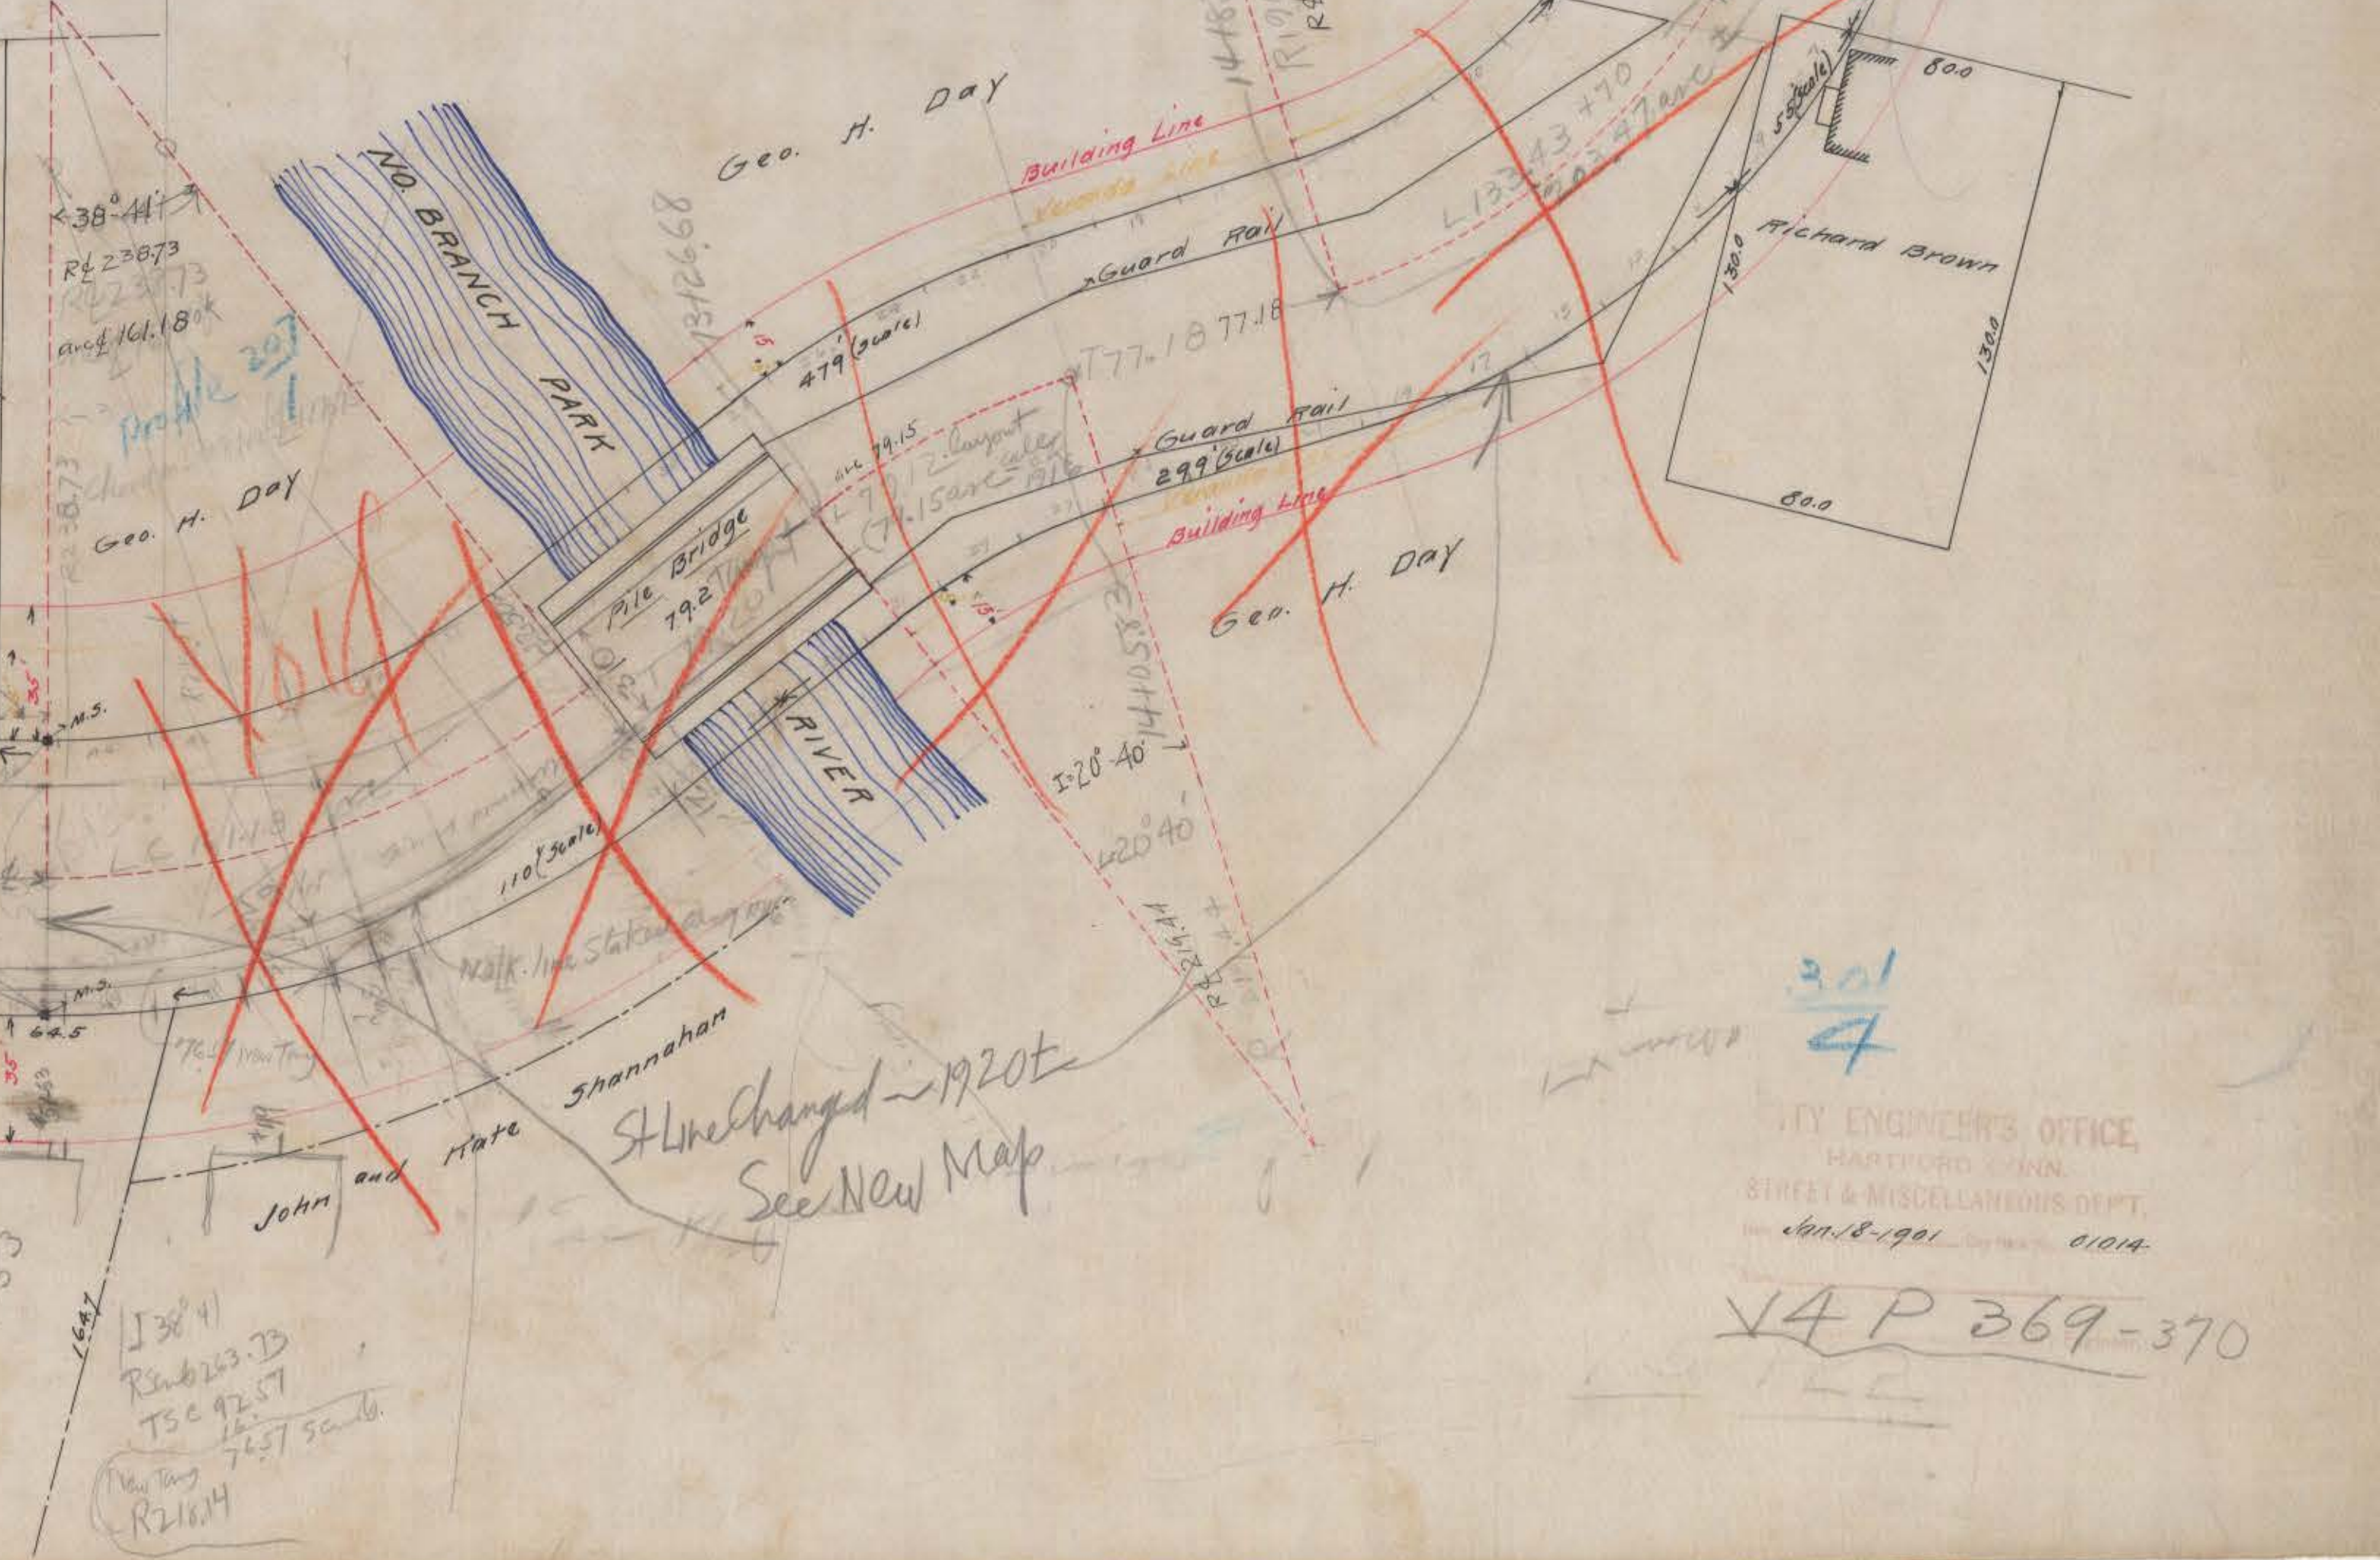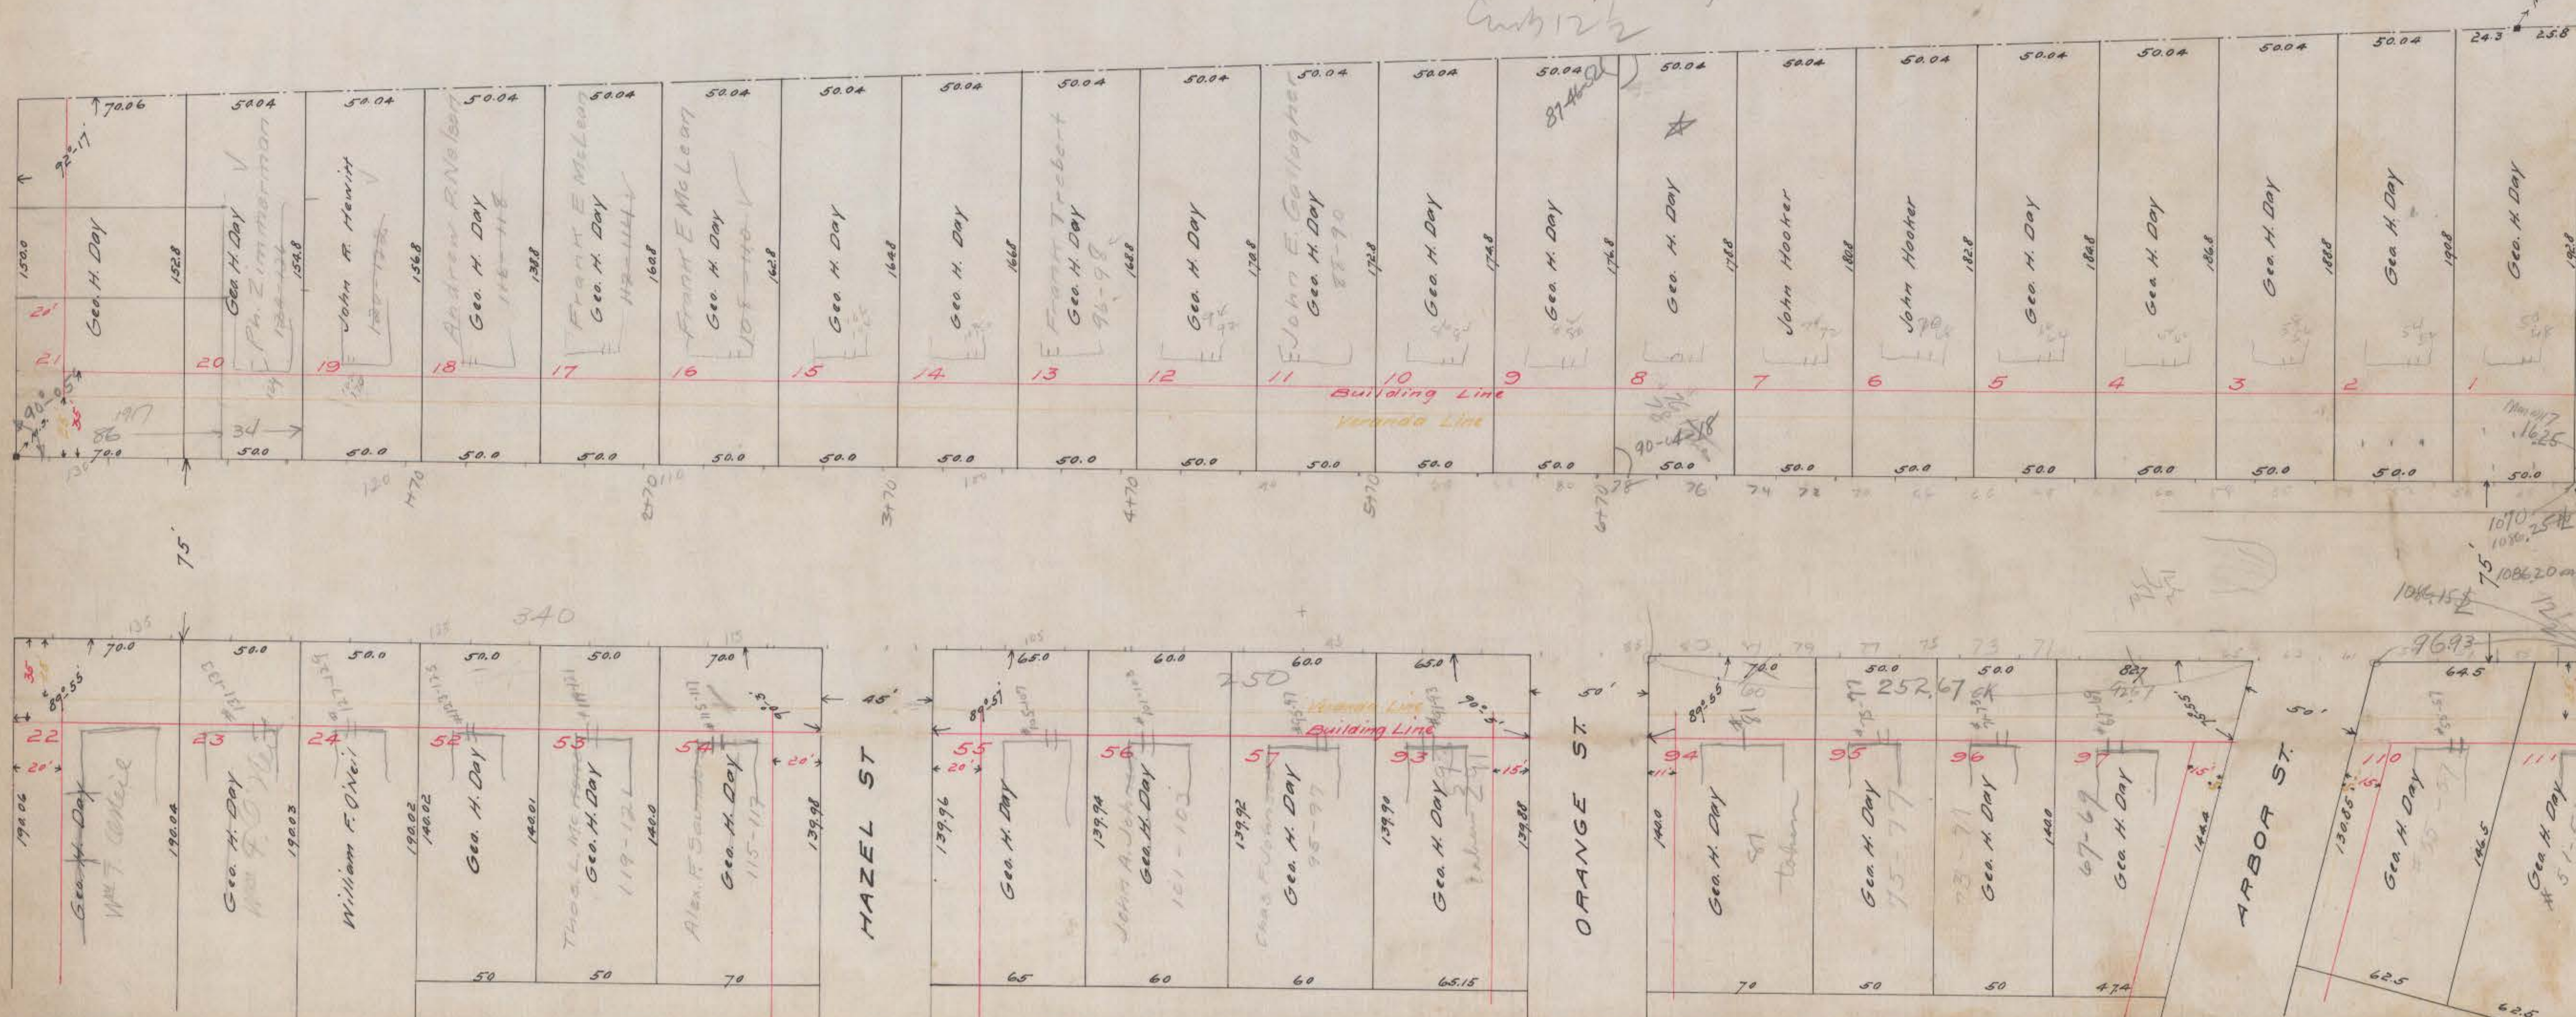

CITY ENGINEER'S OFFICE
HARTFORD, CONN.
STREET & MISCELLANEOUS DEPT.
Jan 18-1901
V4 P 369-370