


S/200

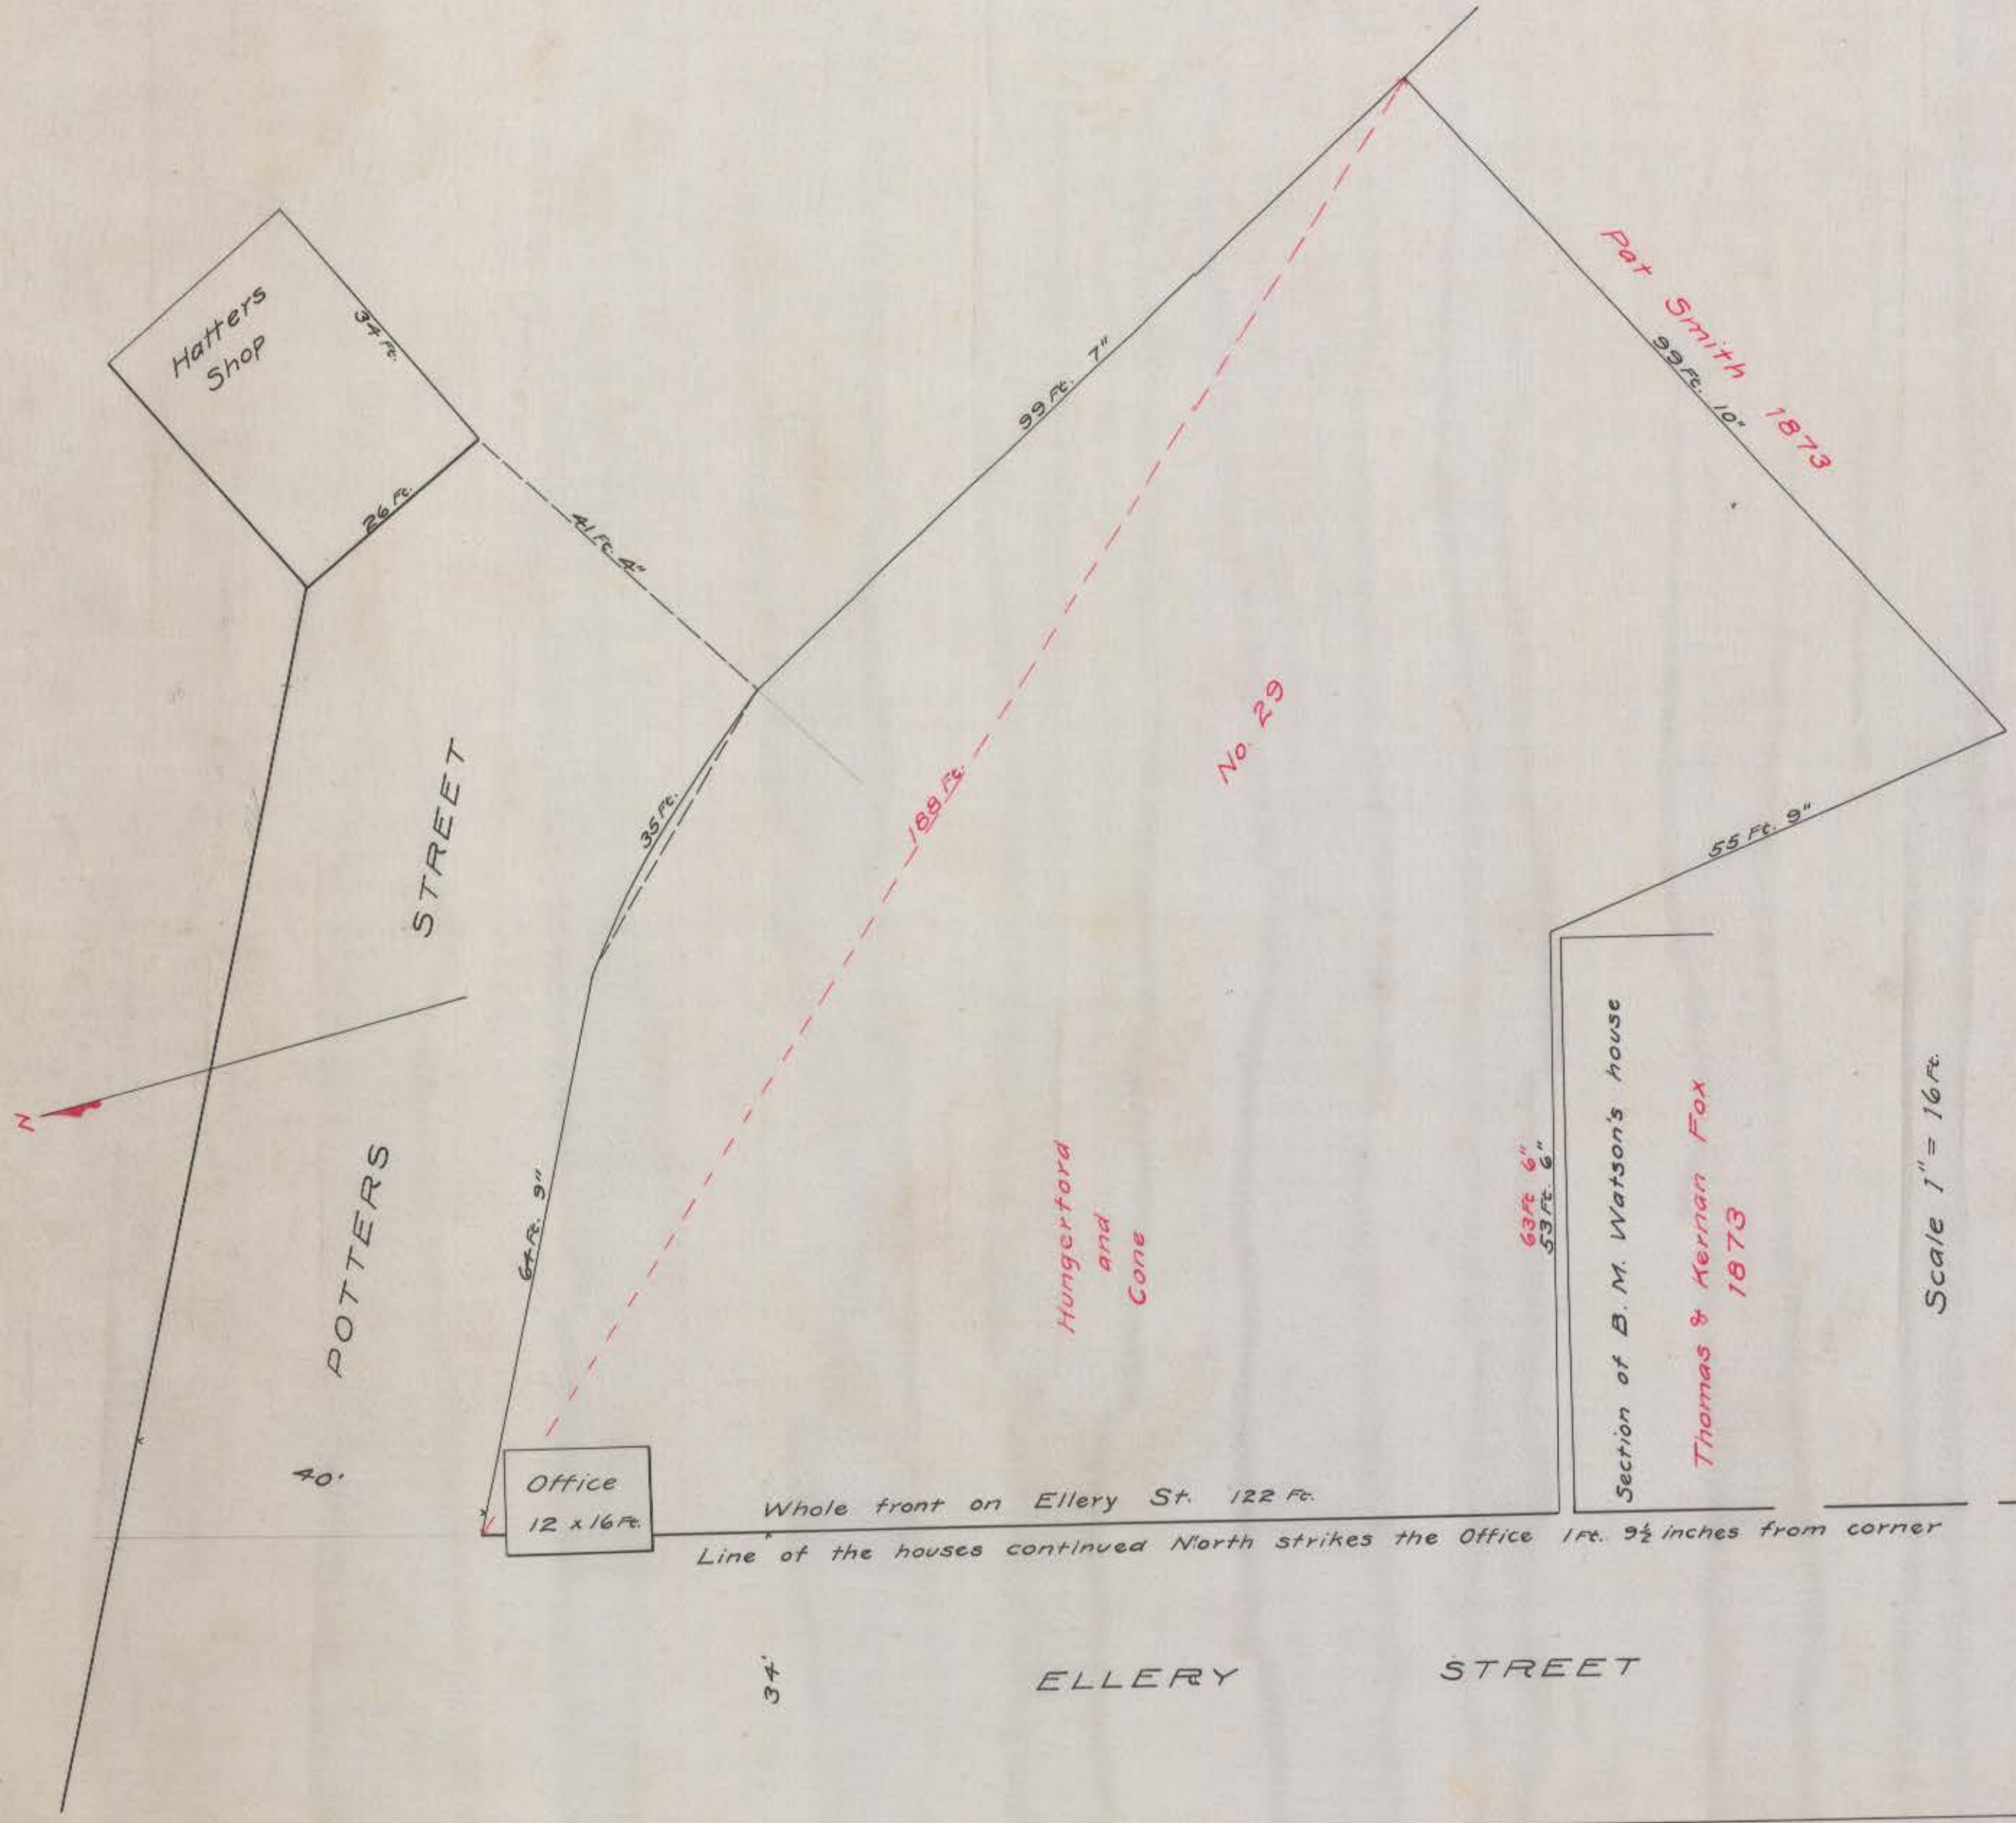

Whole front on Ellery St. 122 ft.
Line of the houses continued North strikes the Office 1 ft. 9 1/2 inches from corner

Copy of Map of Gas Co.

CITY ENGINEER'S OFFICE,
HARTFORD, CONN.
STREET & MISCELLANEOUS DEPT.
Feb. 13, 1901

TT6
eos
S