


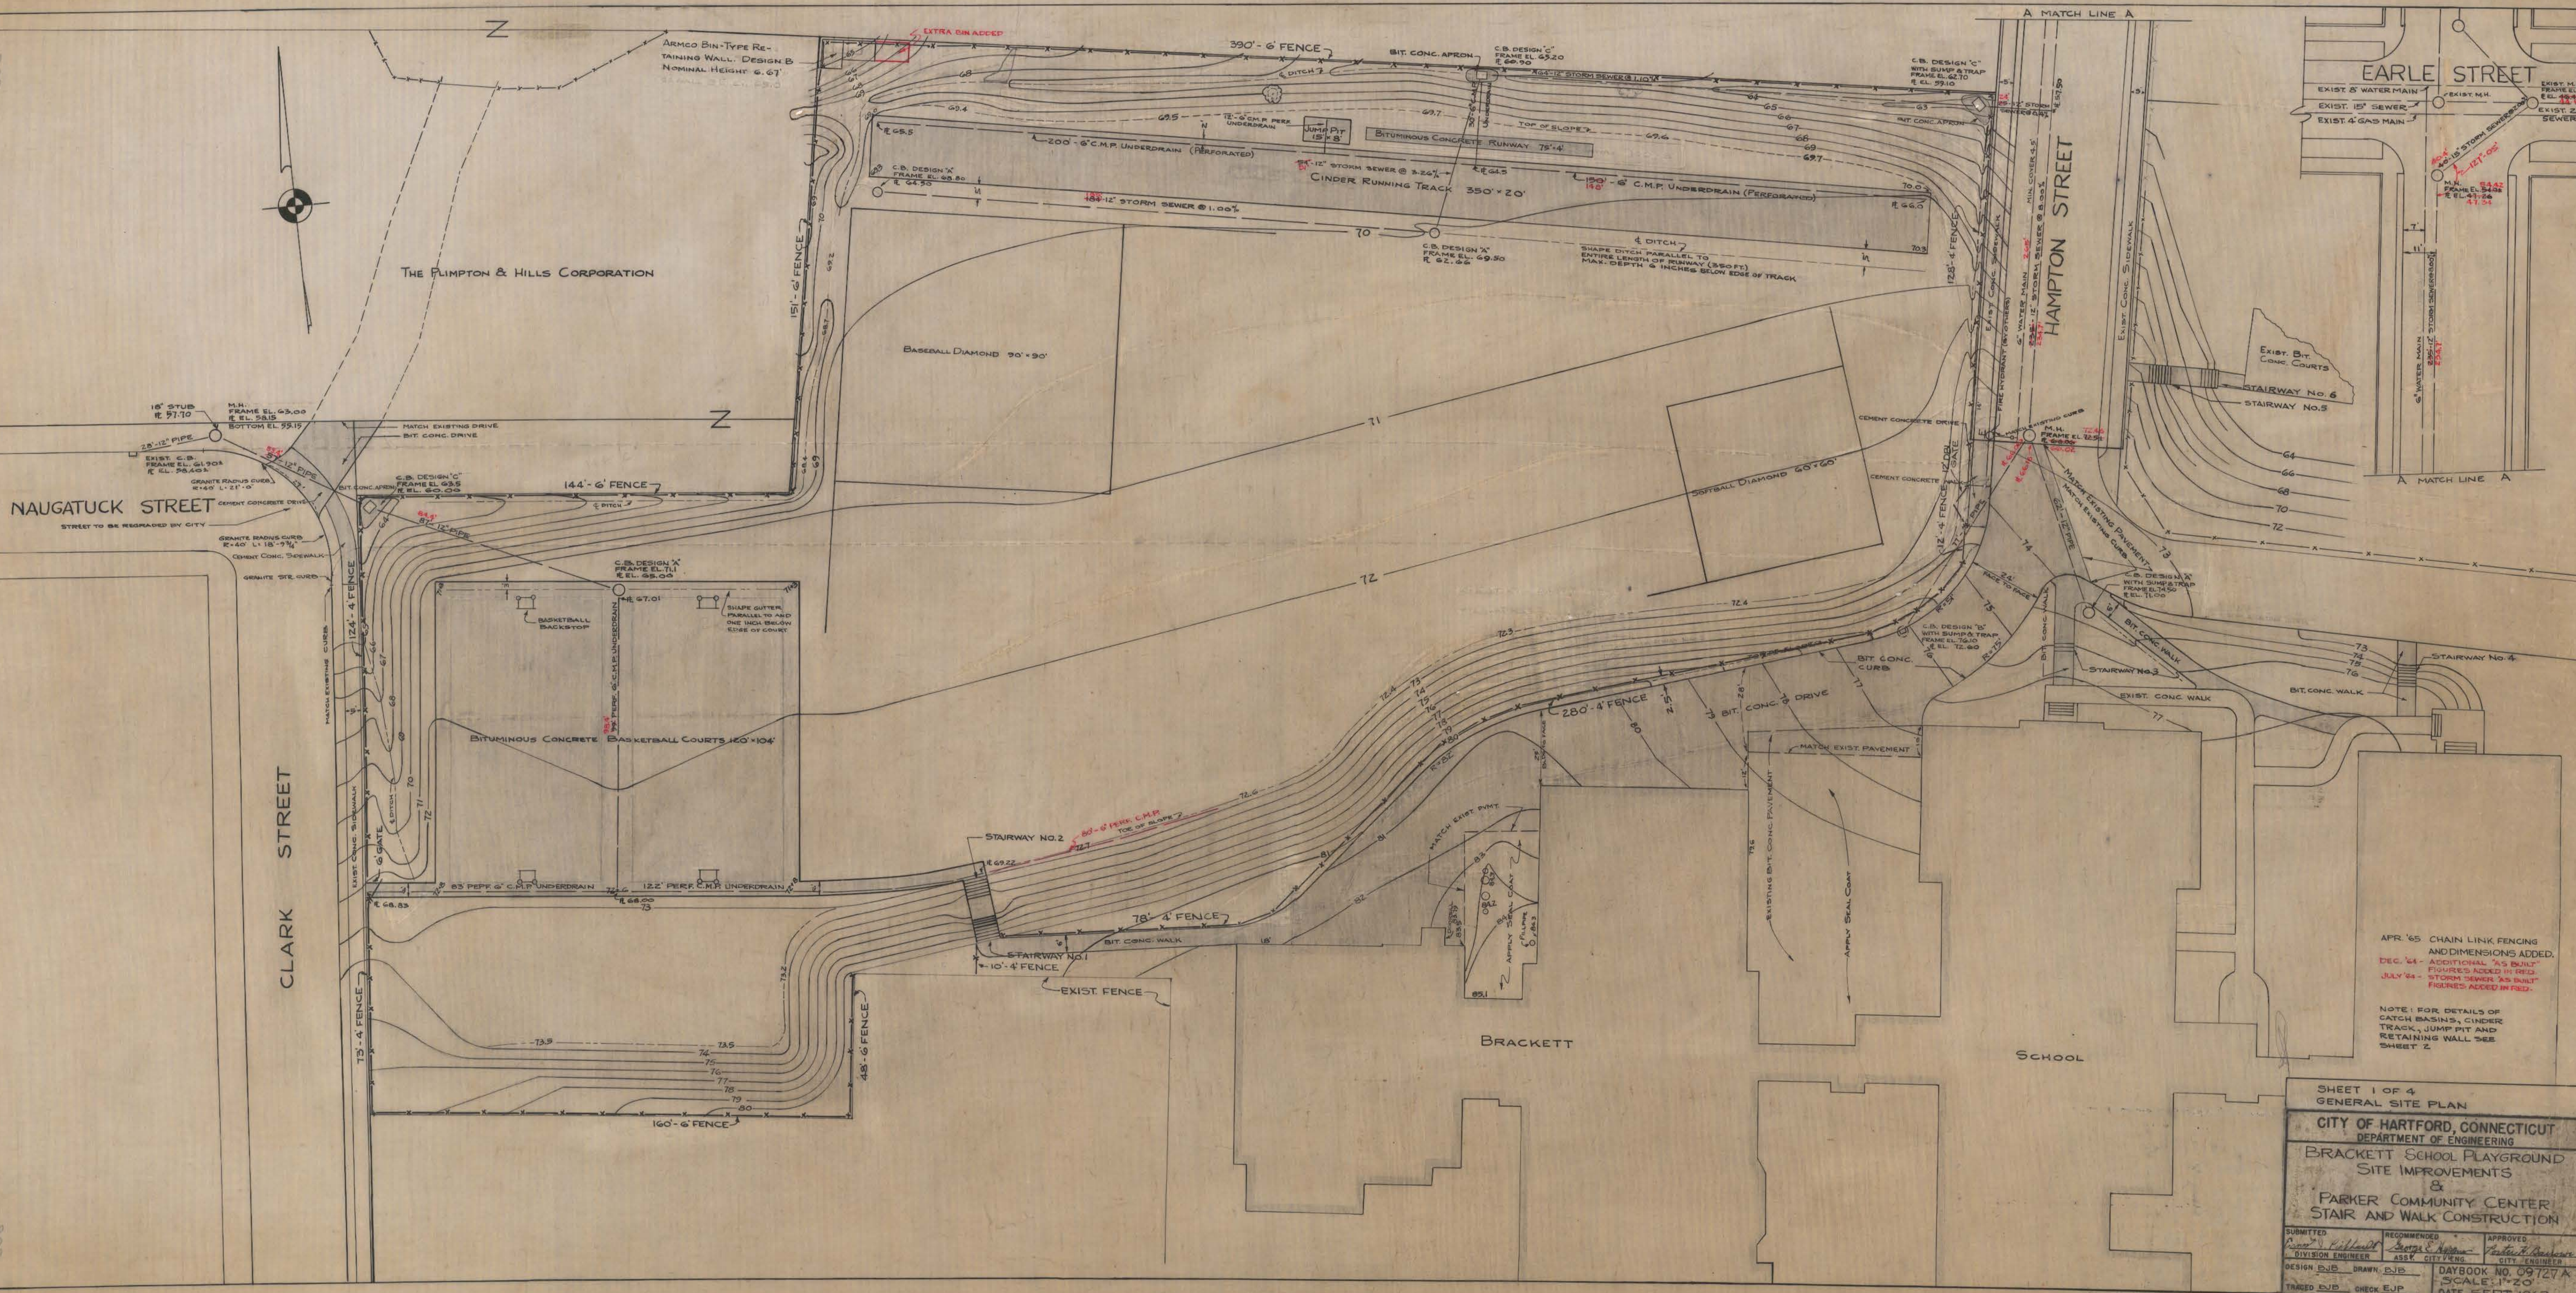

APR '65 CHAIN LINK FENCING
AND DIMENSIONS ADDED.
DEC '64 - ADDITIONAL "AS BUILT"
FIGURES ADDED IN RED.
JULY '64 - STORM SEWER "AS BUILT"
FIGURES ADDED IN RED.

NOTE: FOR DETAILS OF
CATCH BASINS, CINDER
TRACK, JUMP PIT AND
RETAINING WALL SEE
SHEET 2

SHEET 1 OF 4
GENERAL SITE PLAN

CITY OF HARTFORD, CONNECTICUT
DEPARTMENT OF ENGINEERING

BRACKETT SCHOOL PLAYGROUND
SITE IMPROVEMENTS
&
PARKER COMMUNITY CENTER
STAIR AND WALK CONSTRUCTION

SUBMITTED By: <i>Robert V. Kelland</i> DIVISION ENGINEER	RECOMMENDED By: <i>George E. Rogers</i> ASSY. CITY ENGINEER	APPROVED By: <i>Frederick B. Boush</i> CITY ENGINEER
DESIGN: BJB	DRAWN: BJB	DAYBOOK NO. 09727A
TRACED: BJB	CHECK: EJP	SCALE: 1" = 20' DATE: SEPT 1943