


PROFILE OF ALBANY AVENUE

SCALE { VERT. 1"=10'
HORI. 1"=50'

B.M. #107 Elev=

CITY ENGINEER'S OFFICE,
HARTFORD, CONN.
SEWER & UNDERGROUND DEPT.
Jan 22, 1901 Day Book No. 01027
Page 5B-60 Book #177
C.H. Bunce City Engineer

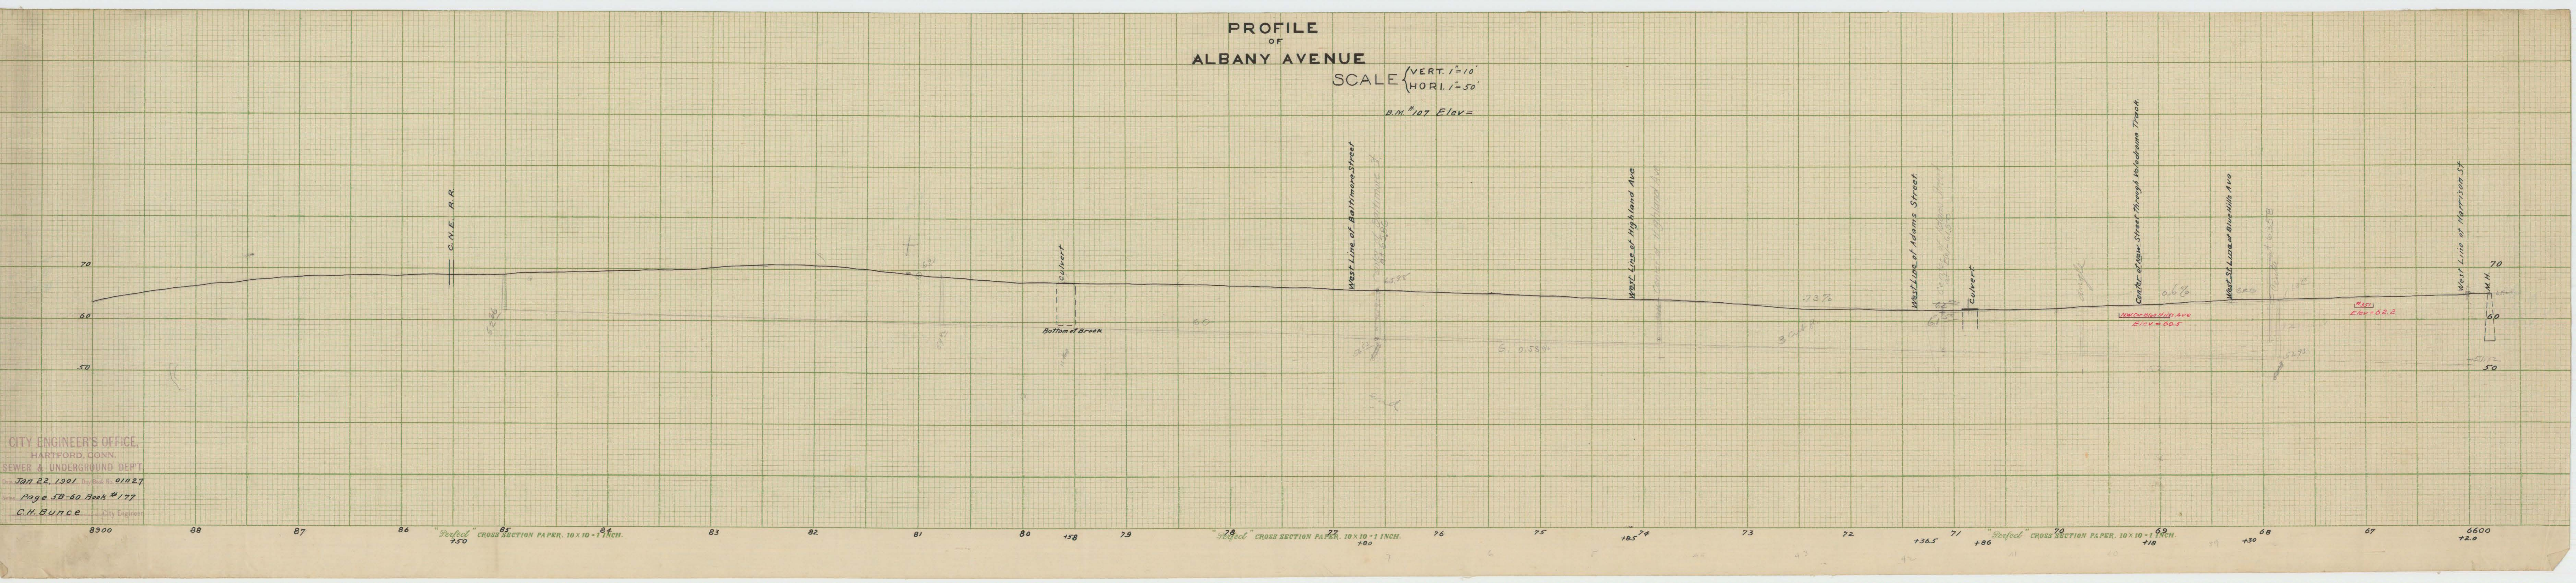

"Perfect" CROSS SECTION PAPER, 10x10-1 INCH.
750

"Perfect" CROSS SECTION PAPER, 10x10-1 INCH.
760

"Perfect" CROSS SECTION PAPER, 10x10-1 INCH.
718