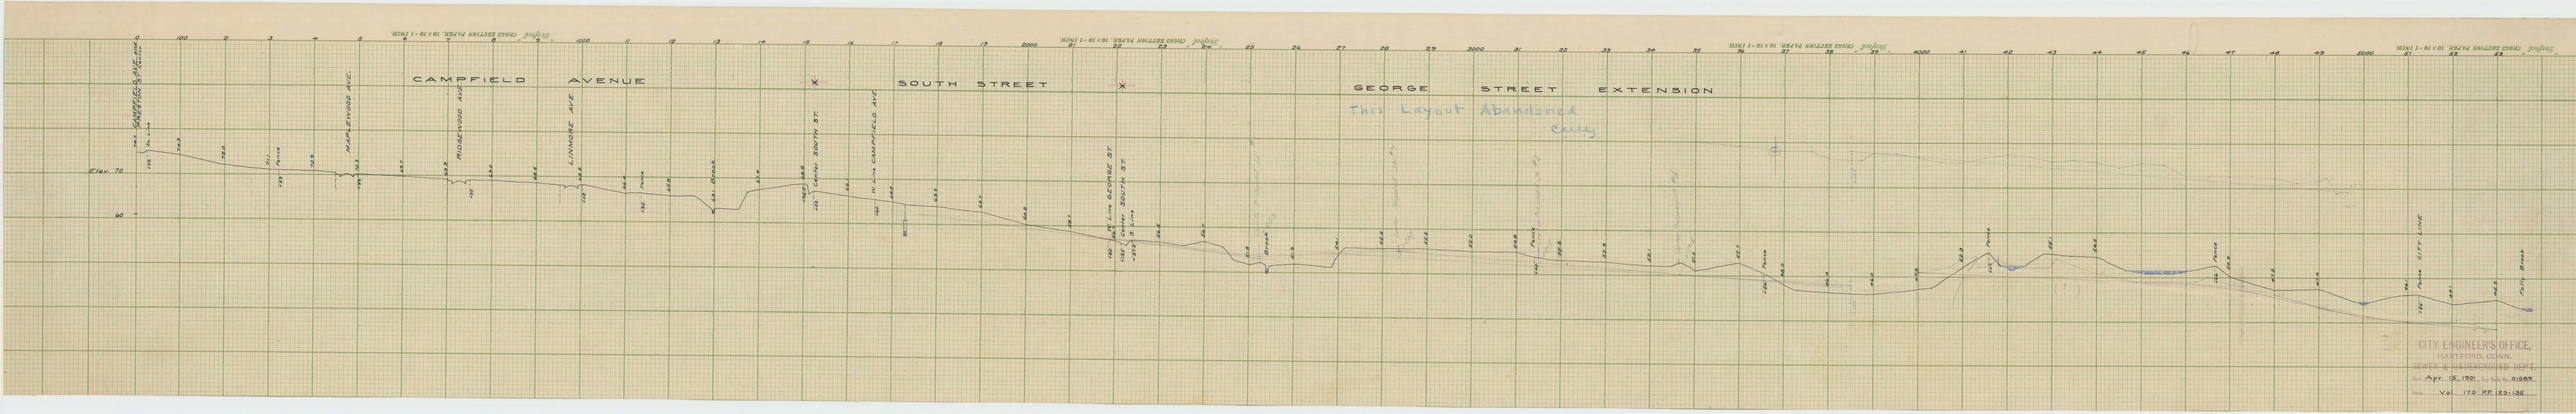
Profile CROSS SECTION PAPER, 10 X 10 - 1 INCH
CAMPFIELD AVENUE
SOUTH STREET
GEORGE STREET EXTENSION
This Layout Abandoned
Elev. 70
60
HARLEWOOD AVE.
RIDGEWOOD AVE.
LINMORE AVE.
CENT. SOUTH ST.
N. LIM. CAMPFIELD AVE.
N. LIM. GEORGE ST.
CENT. SOUTH ST.
CITY LINE
CITY ENGINEER'S OFFICE,
HARTFORD, CONN.
SEWER & SUBDRAINAGE DEPT.
Vol. 170 Pg. 29:35