


B. M. Stone W. T. S. E. cor. #96-98-100 (old Nos), Albany Ave. Opp. Edwards St
Elev. 64.46

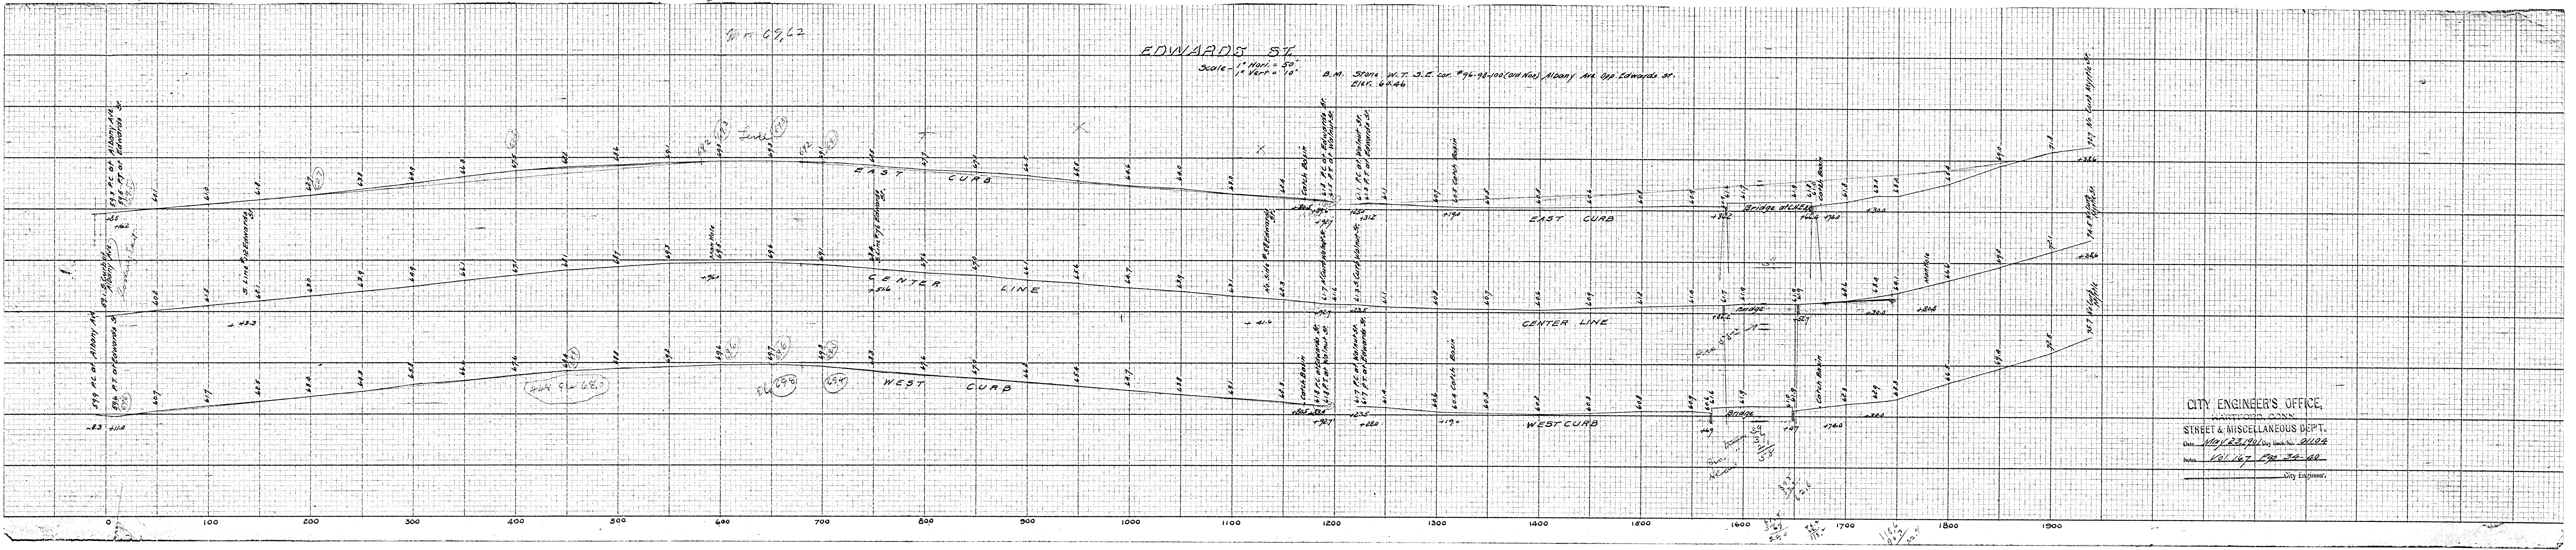

CITY ENGINEER'S OFFICE,


STREET & MISCELLANEOUS DEPT.

Date May 23, 1901 Day Book No. 0104

Vol 167 Pgs 34-40

Notes

City Engineer.