


PROSPECT AVE.  
 New Park Ave northerly 1700  
 Stations measured on line 2' W. of E.  
 Horizontal Scale 1" = 40'  
 Vertical 1" = 4' July. 1912.

Walk from New Park Ave to point 14 No of P1 = 5 ft out.  
 Chose = 7 ft out

(Note: Walk grade to be decided on the ground  
 after 1913)

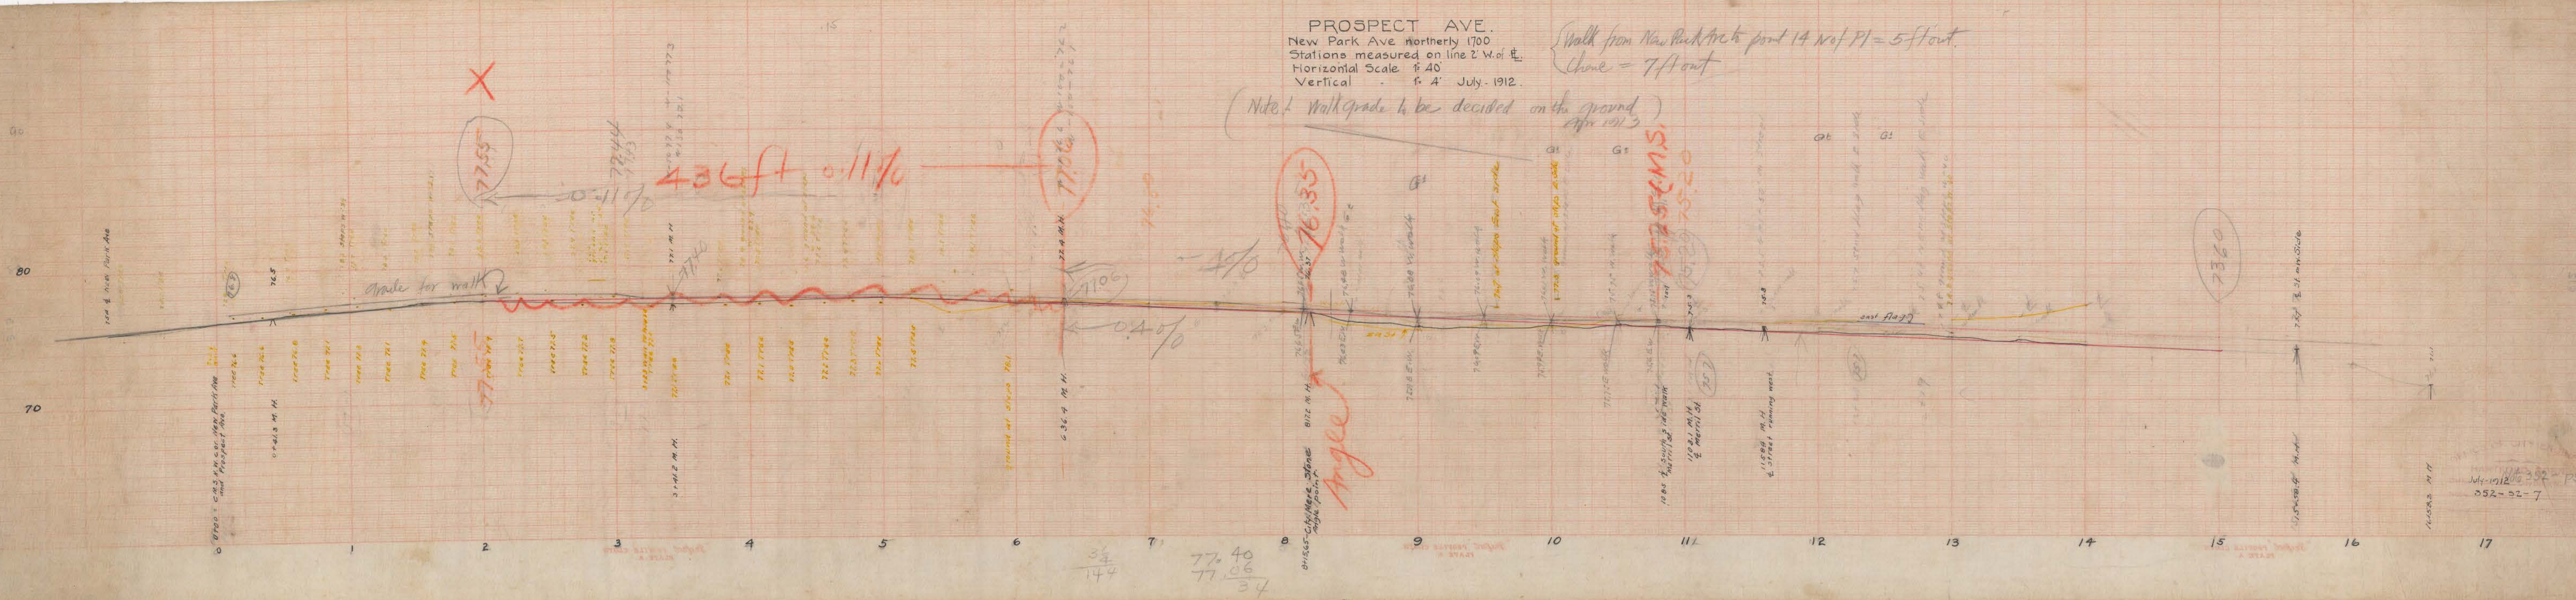

July 12, 1912 352-PS2-57  
 252-32-7