


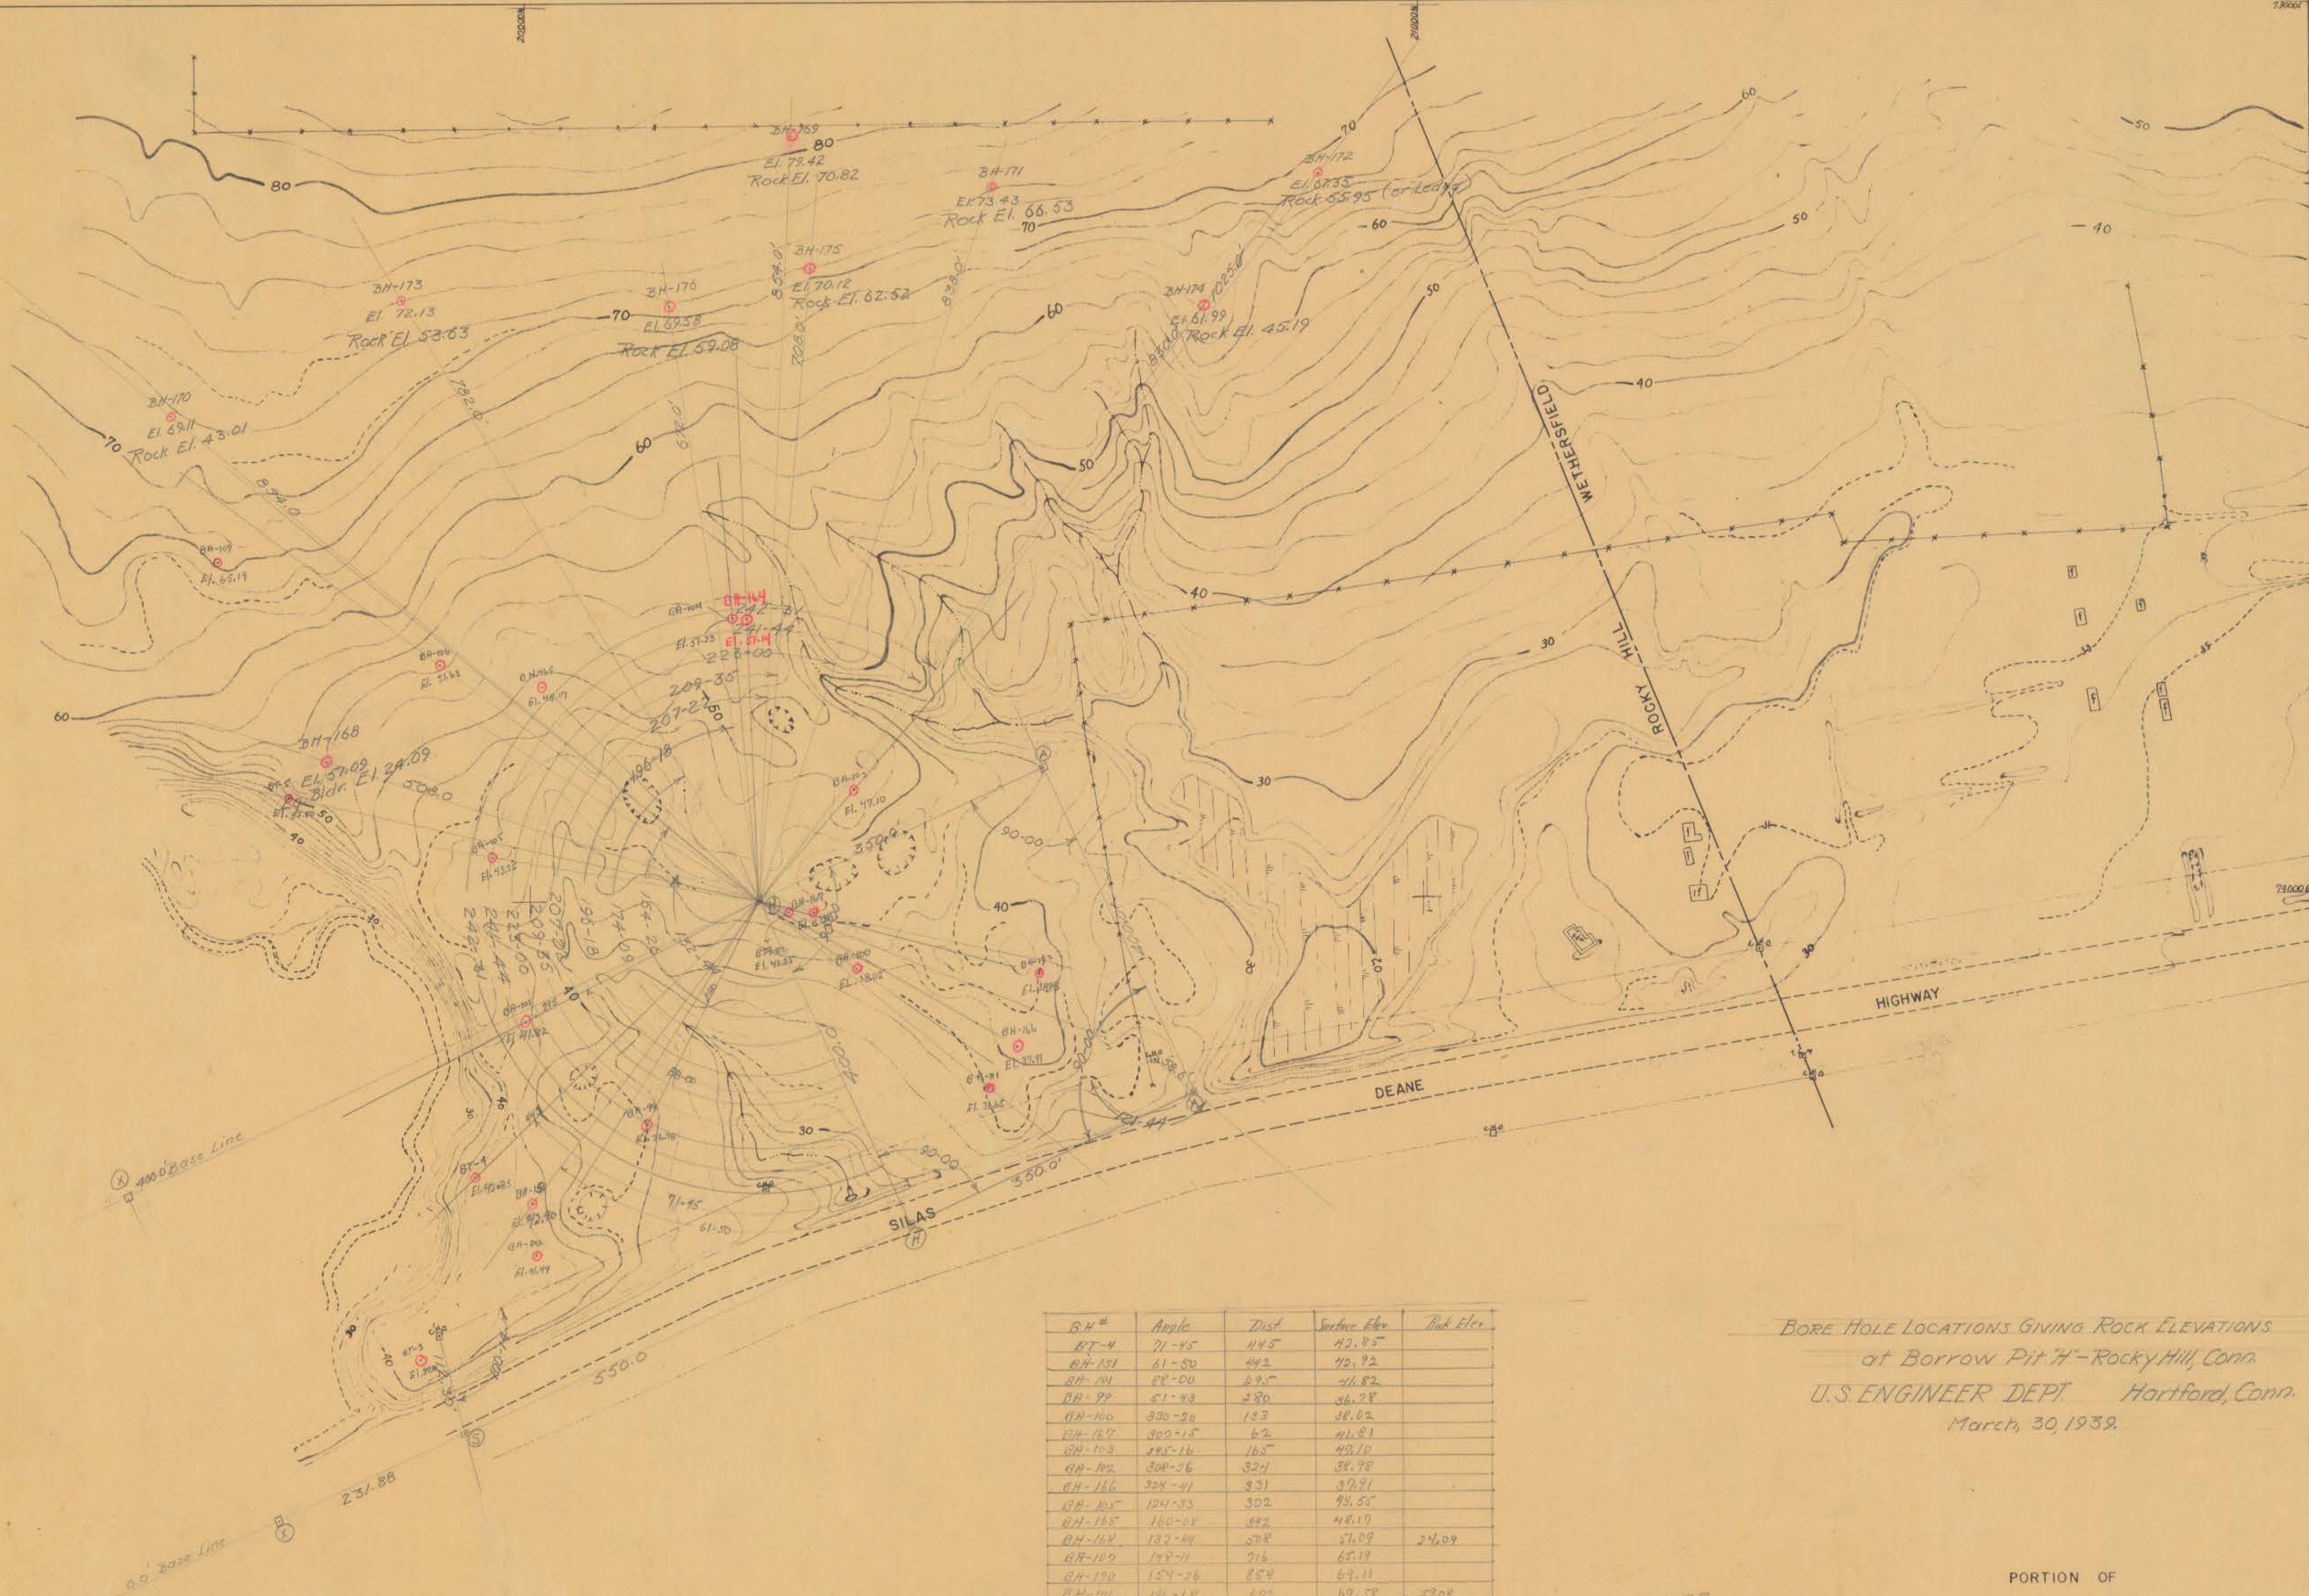

Note Bore Hole Elevations Refer to M.S.L.

B.H. #	Angle	Dist	Surface Elev	Rock Elev

BORE HOLE LOCATIONS GIVING ROCK ELEVATIONS
at Borrow Pit H-Rocky Hill, Conn.
U.S. ENGINEER DEPT. Hartford, Conn.
March, 30, 1939.

5593
11.96
67.89

PORTION OF
JAMES W. ANDERSON, PROPERTY
IN
ROCKY HILL
CITY OF HARTFORD
DEPARTMENT OF ENGINEERING
SCALE 1"=100' MARCH 1939