

Vol 4 P393-1901-

Huntley Ave. and Huntley Pl. - See Map


Scale: - 1" Vert. = 10'
1" Hori. = 50'

B.M. W. end brown stone window sill of W. window
on S. face of brick house #24 Walnut St opp. Huntley Ave.
Elev. 48.56

V5 P293

changed 1911

0.6106 grade

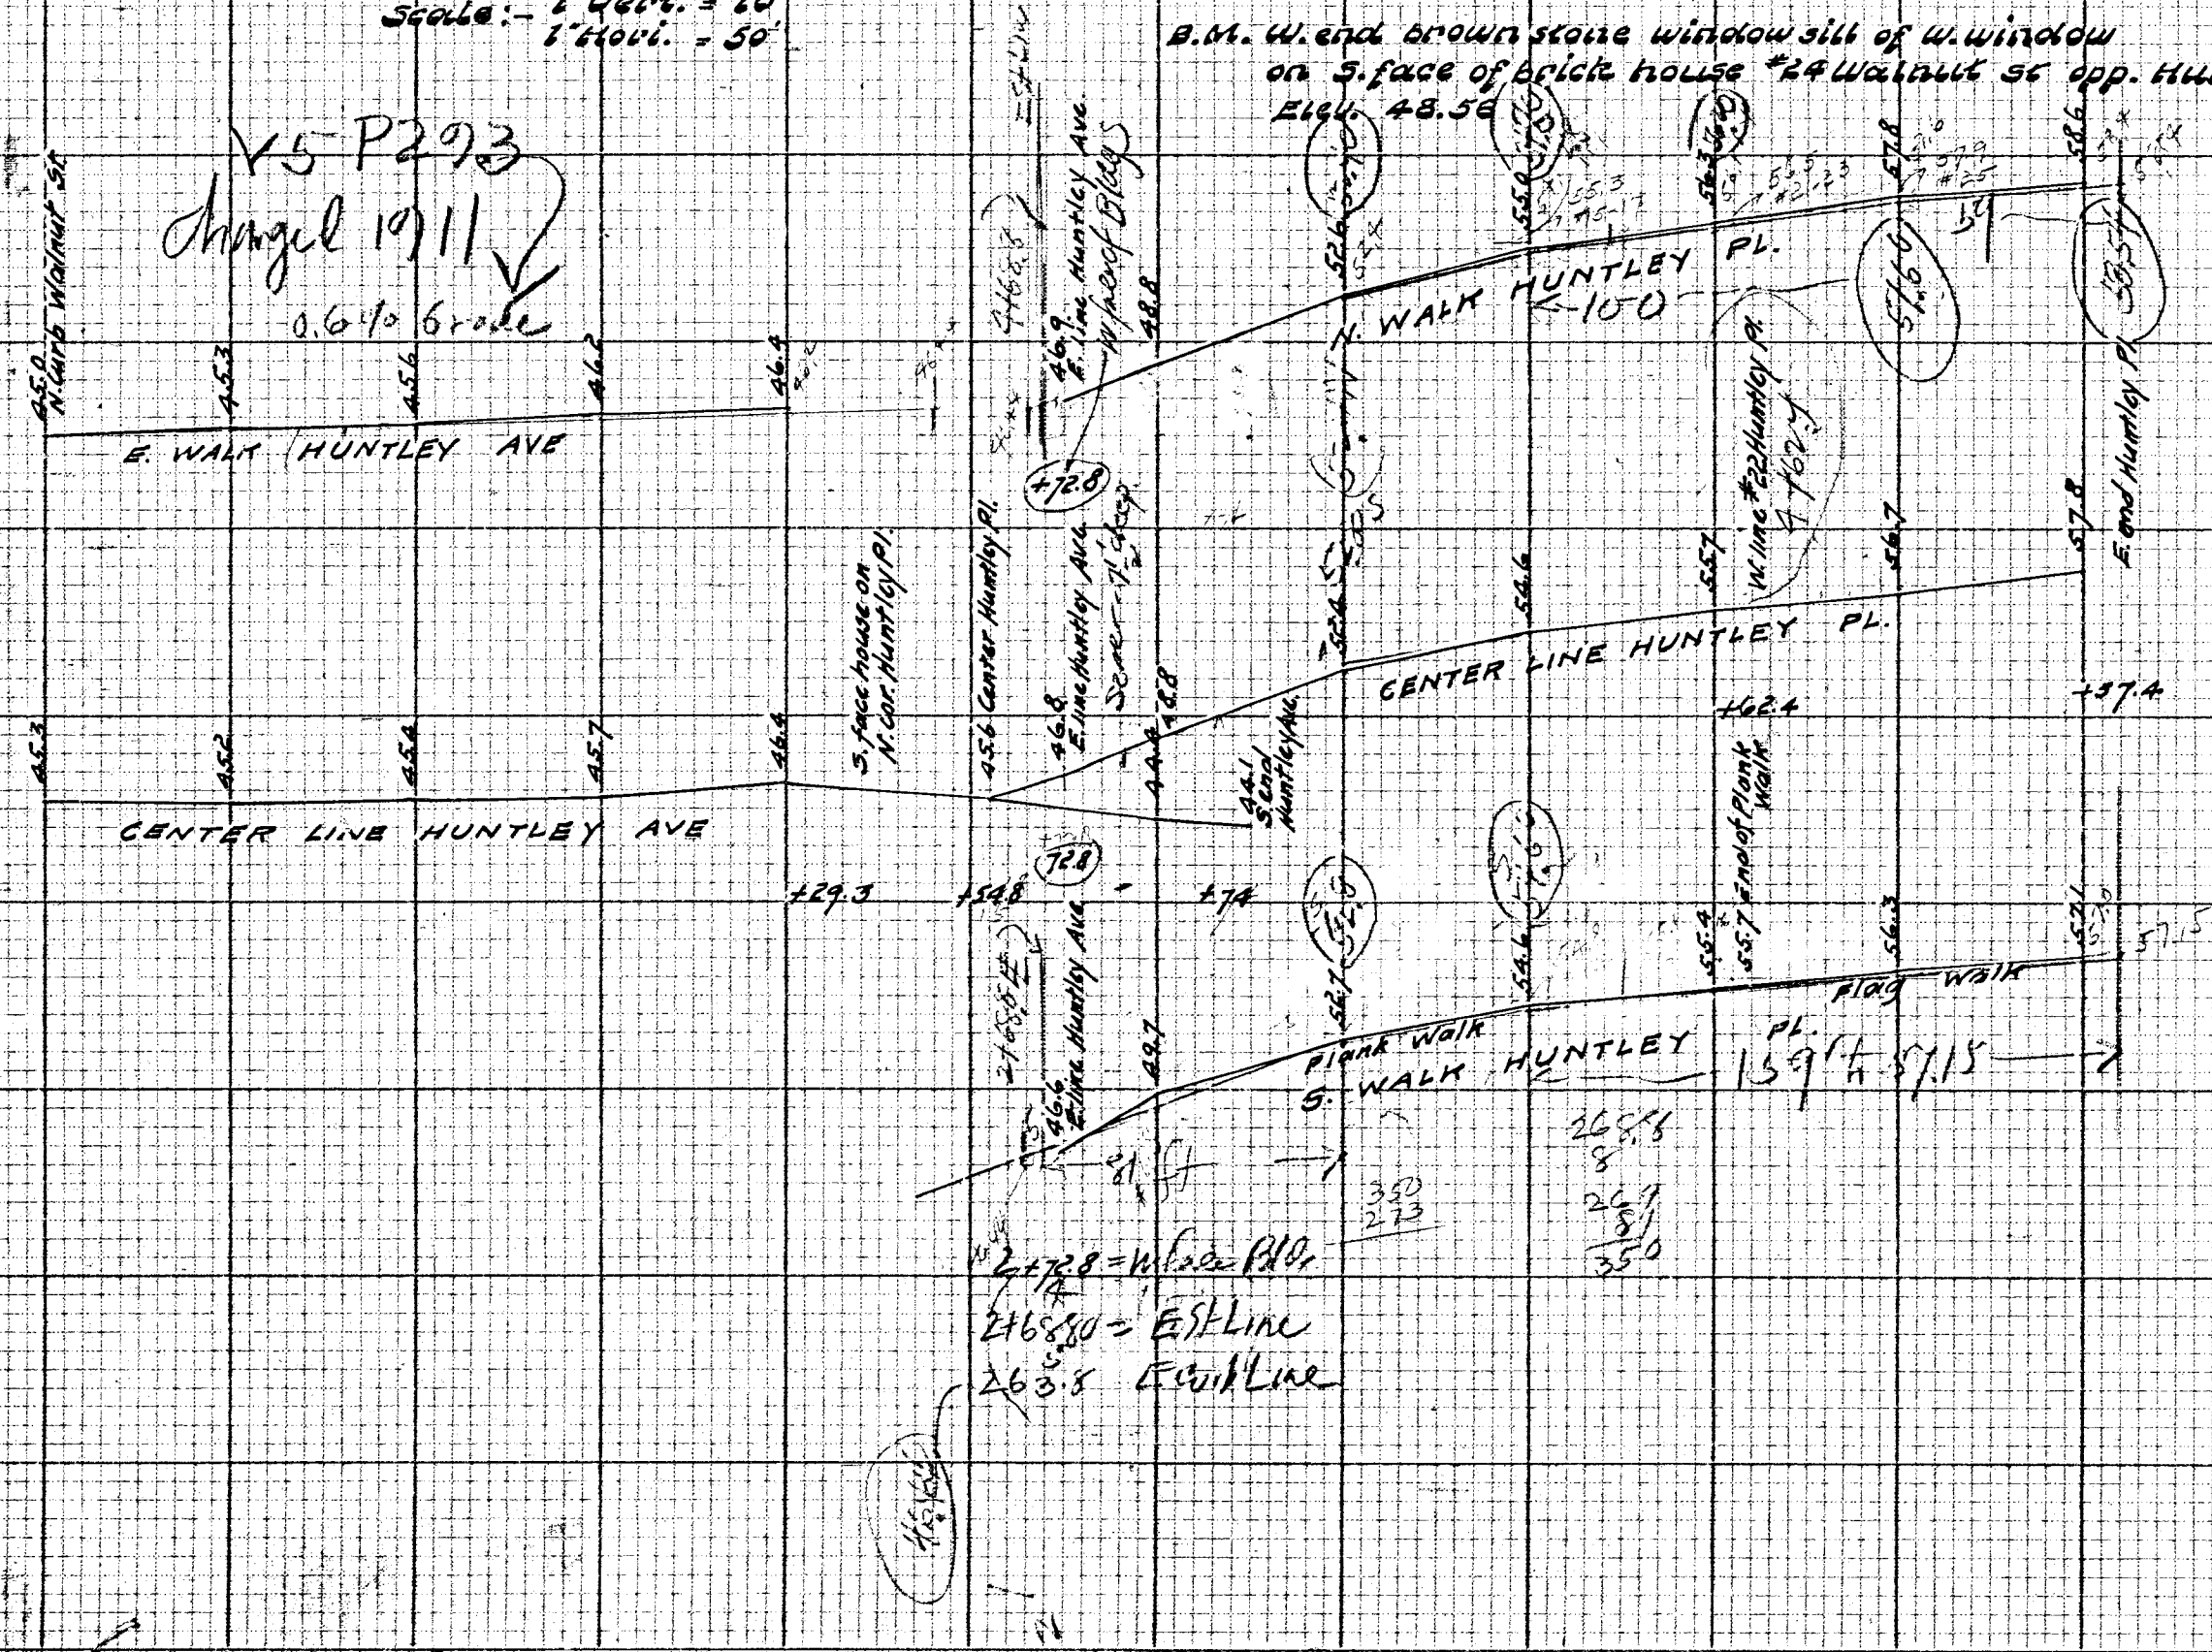

CITY ENGINEER'S OFFICE,
HARTFORD, CONN.
STREET & MISCELLANEOUS DEPT.
July 3, 1901. Day Book to: 01124.
Vol. 107. PM. 52-54
City Engineer.

"Select" CROSS SECTION PAPER, 10x10 = 1 INCH.

"Perfect" CROSS SECTION PAPER, 10x10 = 1 INCH.