


ALBANY AVENUE

SCALE - 1"=40'

Note - Roadway Widened 1923
Ties $\frac{373}{13-16}$

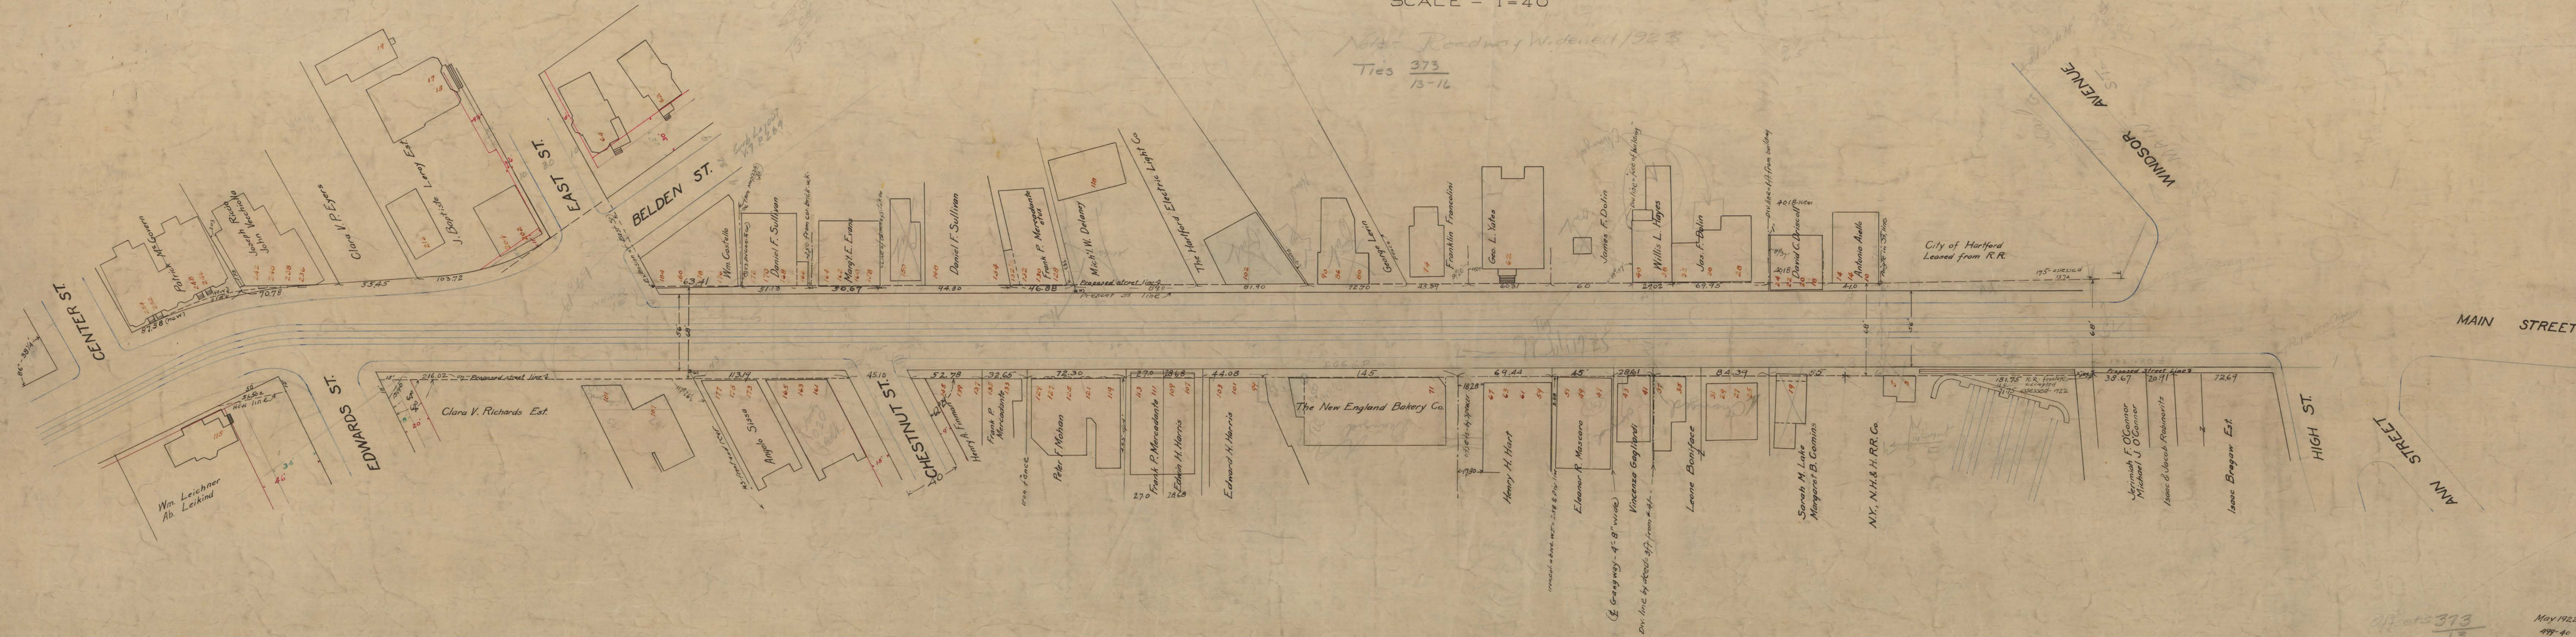

Assessment for new lines - 1922
Note! Frontage on New St. line measured May - 1922
May 1922 05381
499-40 Plan 135
13