


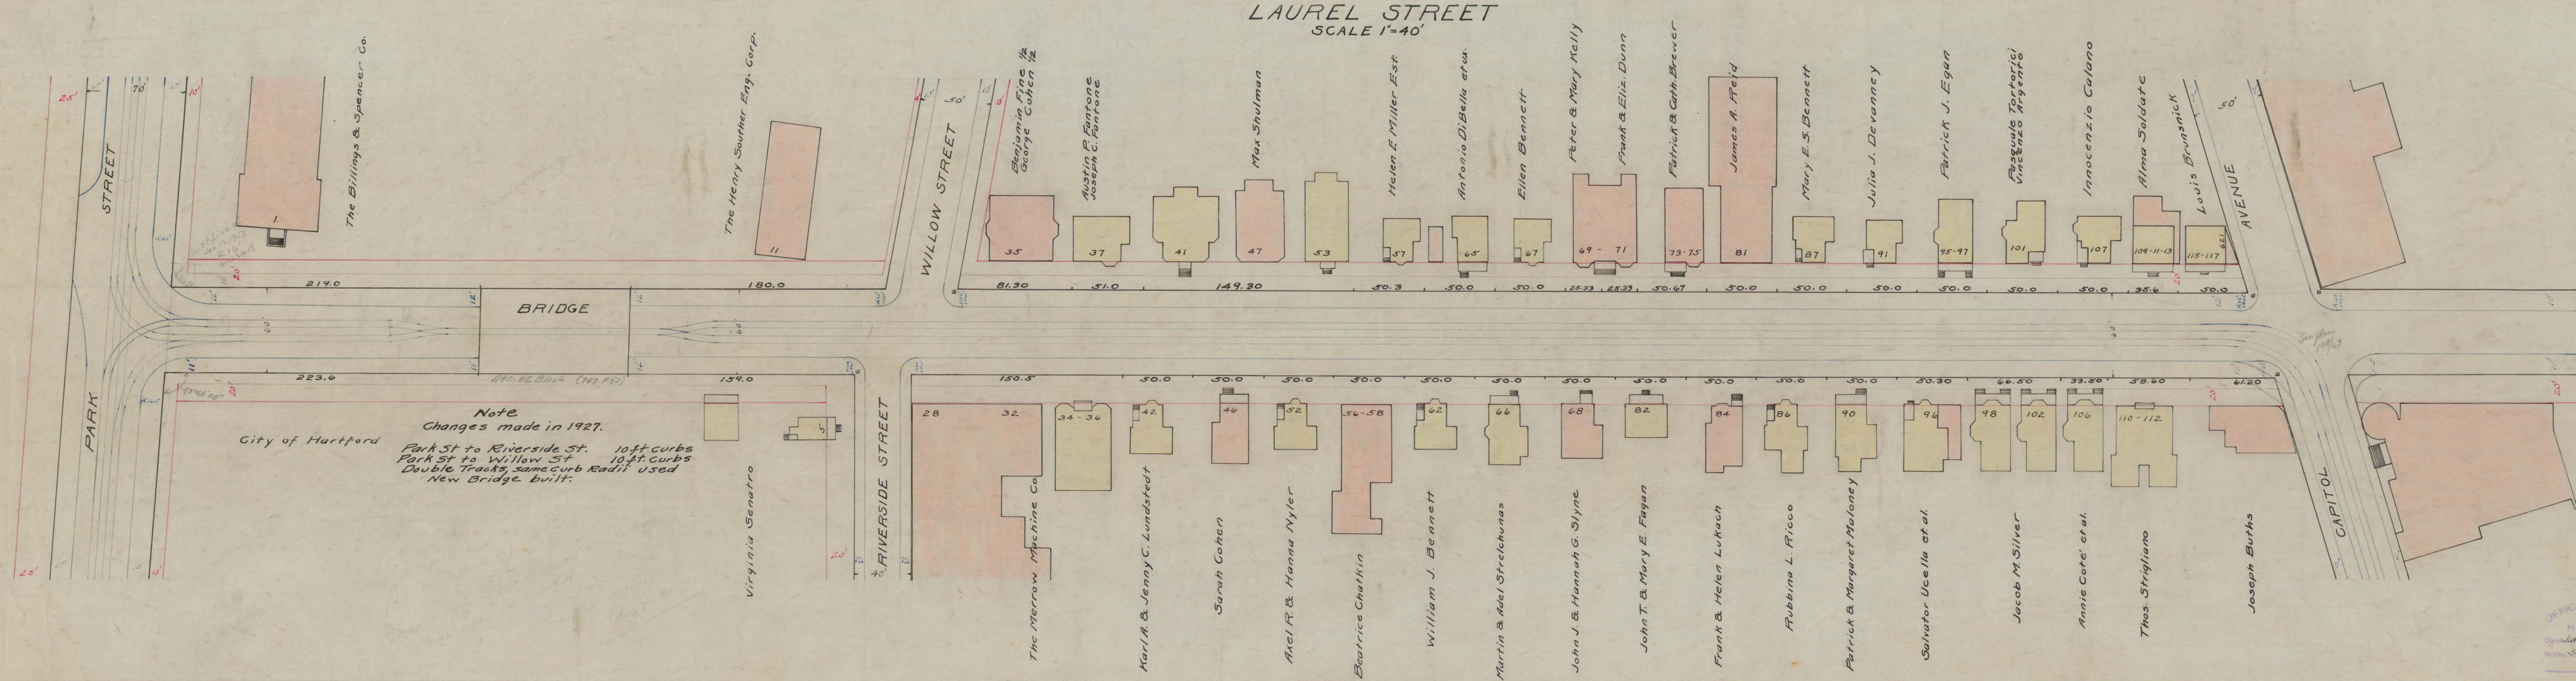

OFFICE OF CITY ENGINEER
HARTFORD, CONN.
Date Jan-1925
Notes 534-P.T.
City Engineer